


Township 5 South, Range 1 West, W.M.
Section 35

T 7995

RECEIVED

MAY 21 1998


WATER RESOURCES DEPT.
SALEM, OREGON

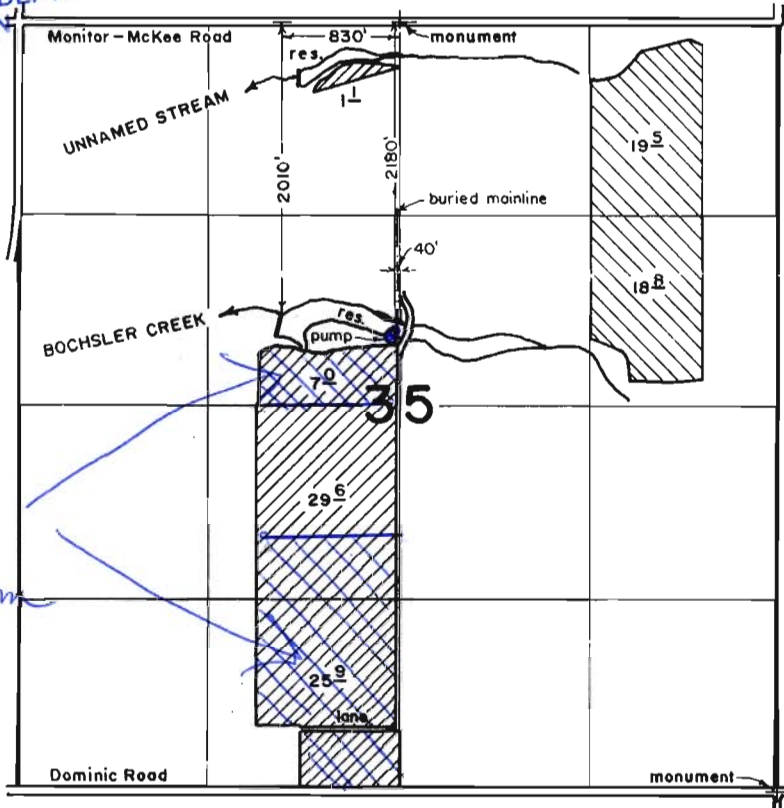


area water rights are transferred from

PRIMARY 

SUPPLEMENTAL 

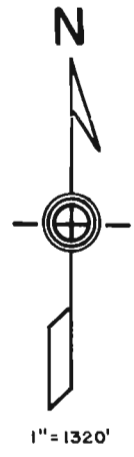

FINAL PROOF SURVEY
under
Appl. No. 70390, Per. No. 51434
in name of
RON VANDECOEVERING
Jan. 23, 1996

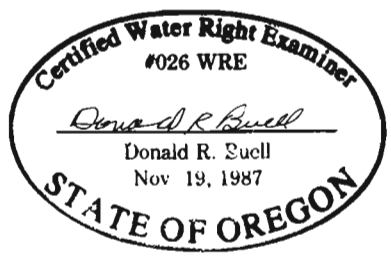

THIS MAP WAS PREPARED FOR THE PURPOSE OF IDENTIFYING THE LOCATION OF A WATER RIGHT ONLY AND IS NOT INTENDED TO PROVIDE LEGAL DIMENSIONS OR LOCATION OF PROPERTY OWNERSHIP LINES.