


T.5N.R.29E.W.M.

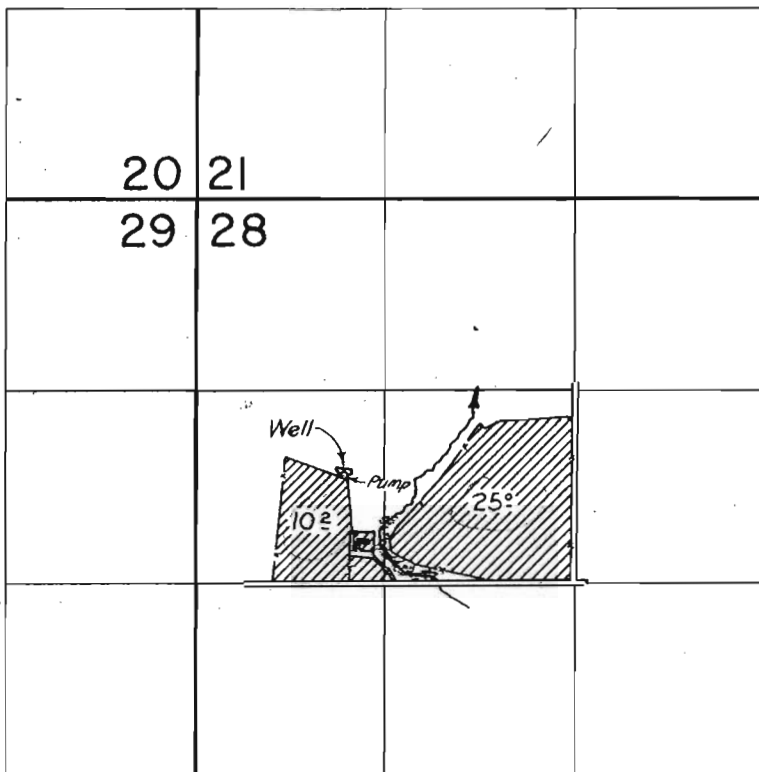

**FINAL PROOF SURVEY**  
UNDER

3.28 acres cancell  
in SE/NW V.52P.426  
4-15-98

Application No. **G-1298** Permit No. **G-1164**  
IN NAME OF

**Donald De Moss**

Surveyed June 7, 1962, by

*A. Jackson*