


# MAP TO ACCOMPANY APPLICATION FOR TRANSFER


APPLICANT: WILSON CATTLE CO.

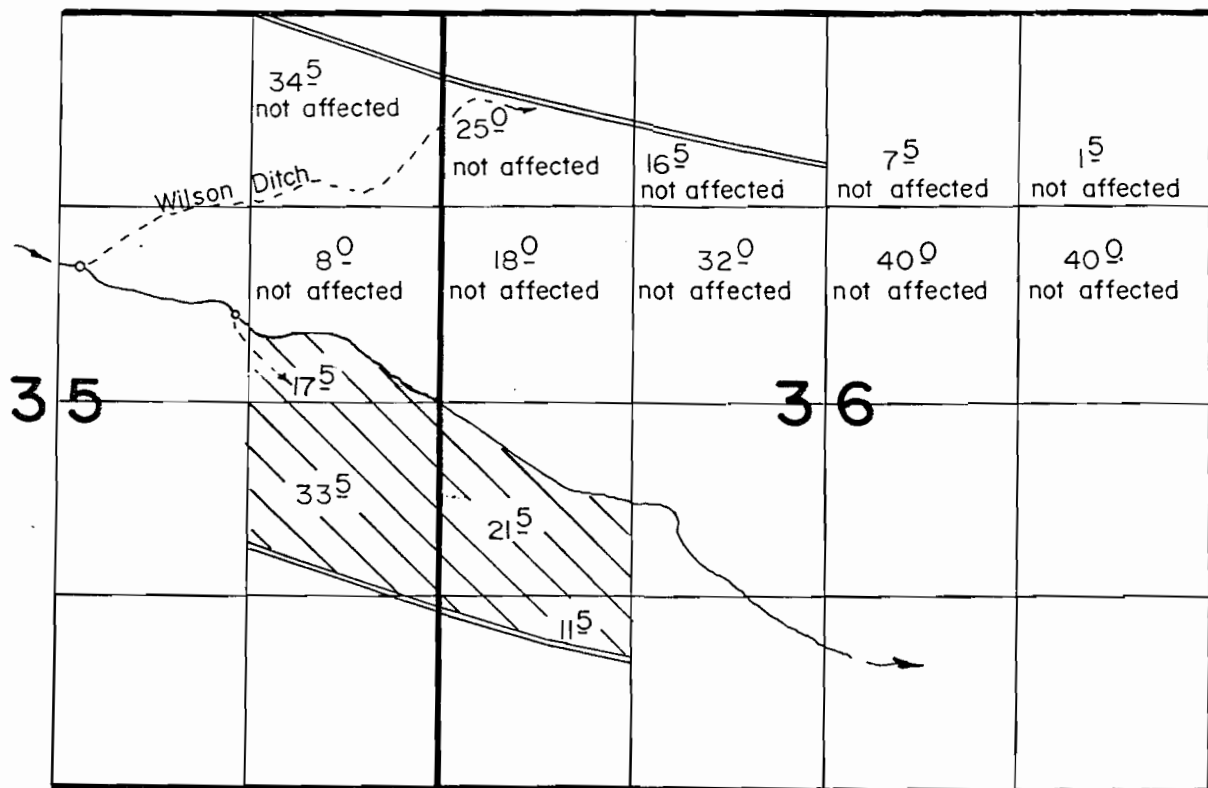

## T. 6S., R. 38E., W.M.

DIV. PT. (DAVIS DALTON DITCH) LOC. 2040'S. & 1430'W. FROM NE COR. SEC. 35  
 DIV. PT. (WILSON DITCH) LOC. 1700'S & 2500'W. FROM NE COR. SEC. 35

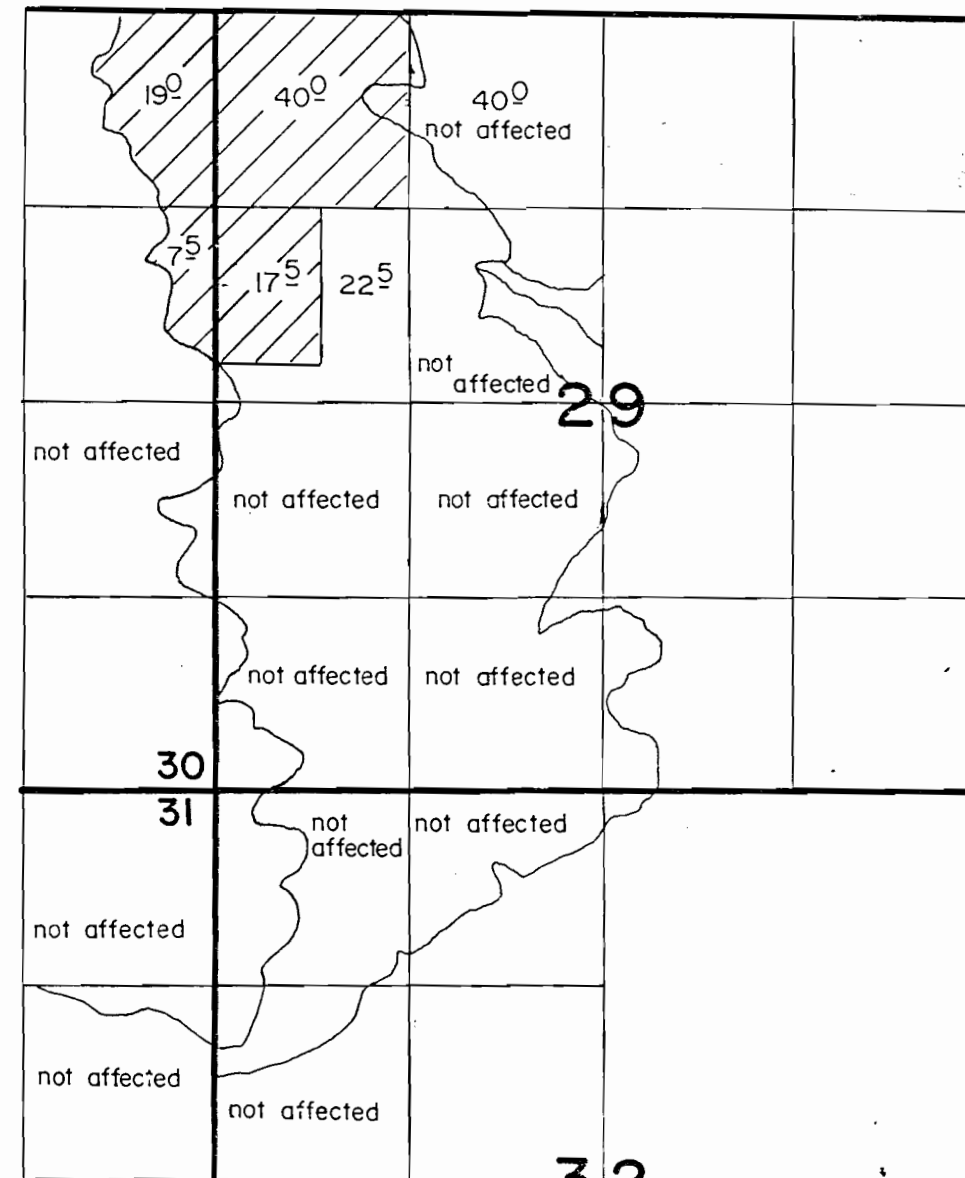


## T. 6S., R. 39E., W.M.



-  FROM C.1524 TO C.1456
-  FROM C.1456 TO C.1524

SCALE 1" = 1320'



T-7885

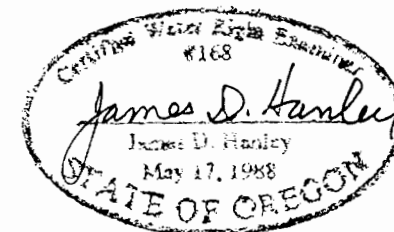

RECEIVED  
 DEC 11 1997  
 WATER RESOURCES DIV.  
 SALEM, OREGON

# Map 1 of 2 FROM LANDS

Twp 6 South, R 38 East, W.M.

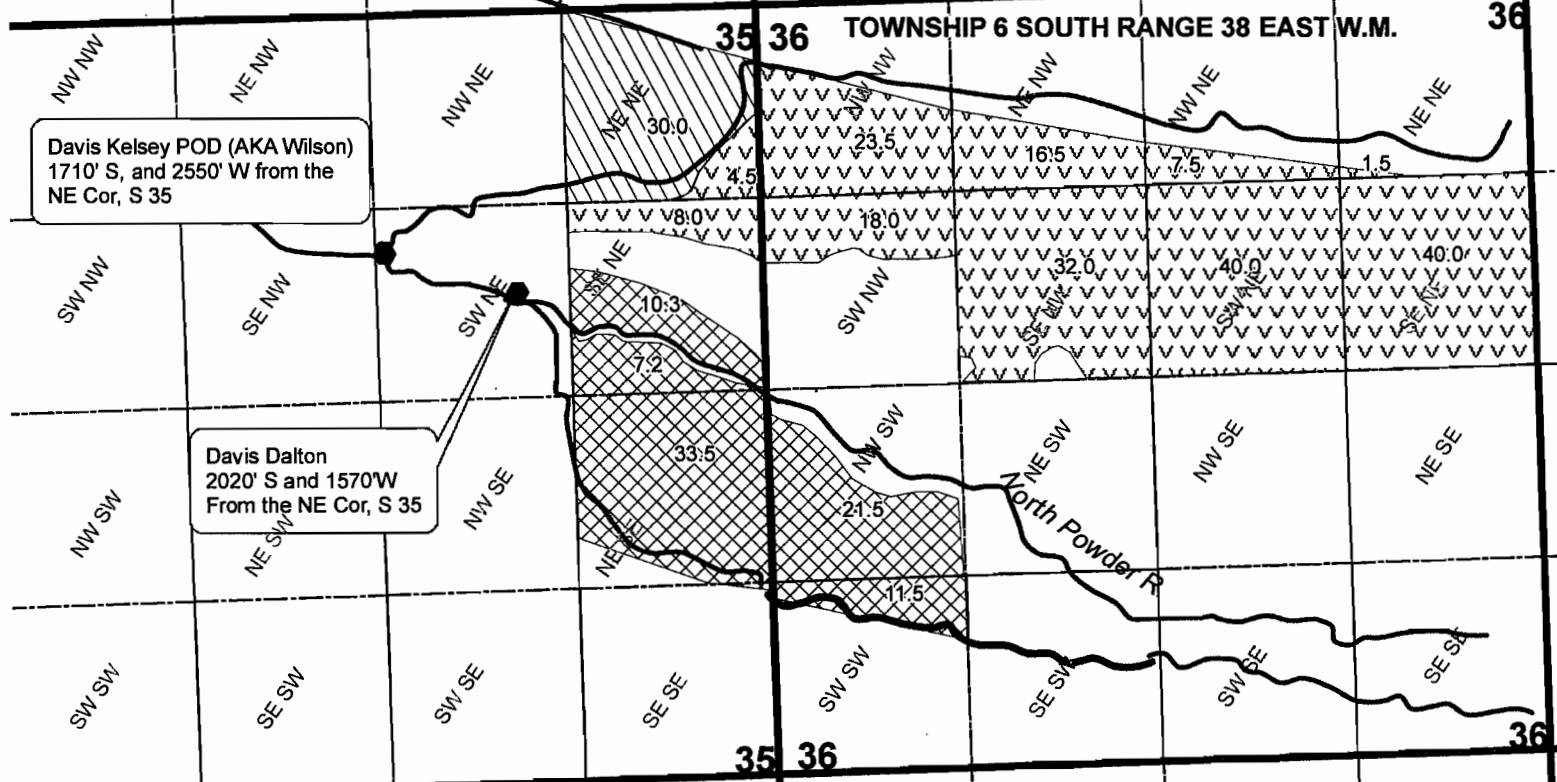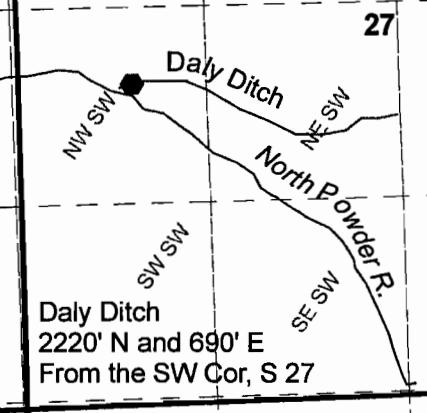

Revised 4/9/08

**T-7885 Wilson Cattle Co**  
**Authorized Points of Diversion**  
**and Place of Use**  
 Scale: 1"=1320'

**Cert 83537**  
 Daly Ditch (1887 Priority)

**Cert 75629**  
 Davis Kelsey (1887 Priority)

Dalton (1874 Priority)

**RECEIVED**  
 AUG 15 2008  
 WATER RESOURCE DEPT.  
 EASTERN REGION

Certified Water Right Examiner  
 # 241  
  
 Thomas J. Hanley  
 May 22, 1990  
 STATE OF OREGON

**Map 2 of 2 TO LANDS**

Twp 6 South, R 38 East, W.M.

Daly Ditch  
2220' N and 690' E  
From the SW Cor, S 27

Davis Kelsey POD (AKA Wilson)  
1710' S, and 2550' W from the  
NE Cor, S 35

Davis Dalton  
2020' S and 1570' W  
From the NE Cor, S 35


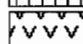


30 Acres From  
Certificate 83537

Revised 4/9/08

**T-7885 Wilson Cattle Co**  
**Proposed changes in Point**  
**of Diversion and Place of Use**

Scale: 1"=1320'

Cert 75629

-  Daly (1874 Priority)
-  Dalton (1887 Priority)
-  Davis Kelsey/ Daly (1874 Priority)
-  Davis Kelsey/Daly (1887 Priority)

**RECEIVED**  
AUG 15 2008  
WATER RESOURCE DEPT.  
EASTERN REGION

Certified Water Right Examiner  
# 241  
*Thomas J. Hanley*  
Thomas J. Hanley  
May 22, 1990  
STATE OF OREGON

