

T.36S.,R.1E. & R.2E.,W.M.

Jackson County, Oregon
Tax Lot No. 362E - 5310
and 361E 13 - 100




SCALE 1" = 400'

MAP TO ACCOMPANY AN APPLICATION
FOR A WATER RIGHT TRANSFER
(CHANGE IN PLACE OF USE AND
ADDITIONAL POINT OF DIVERSION)




PREPARED BY:
GARY D. KAISER
19440 HWY. 62
EAGLE POINT, OR.
97524

FOR: H.J. HANSCOM
and TERRY L. MATLOCK
P.O. BOX 2033
WHITE CITY, OR. 97503

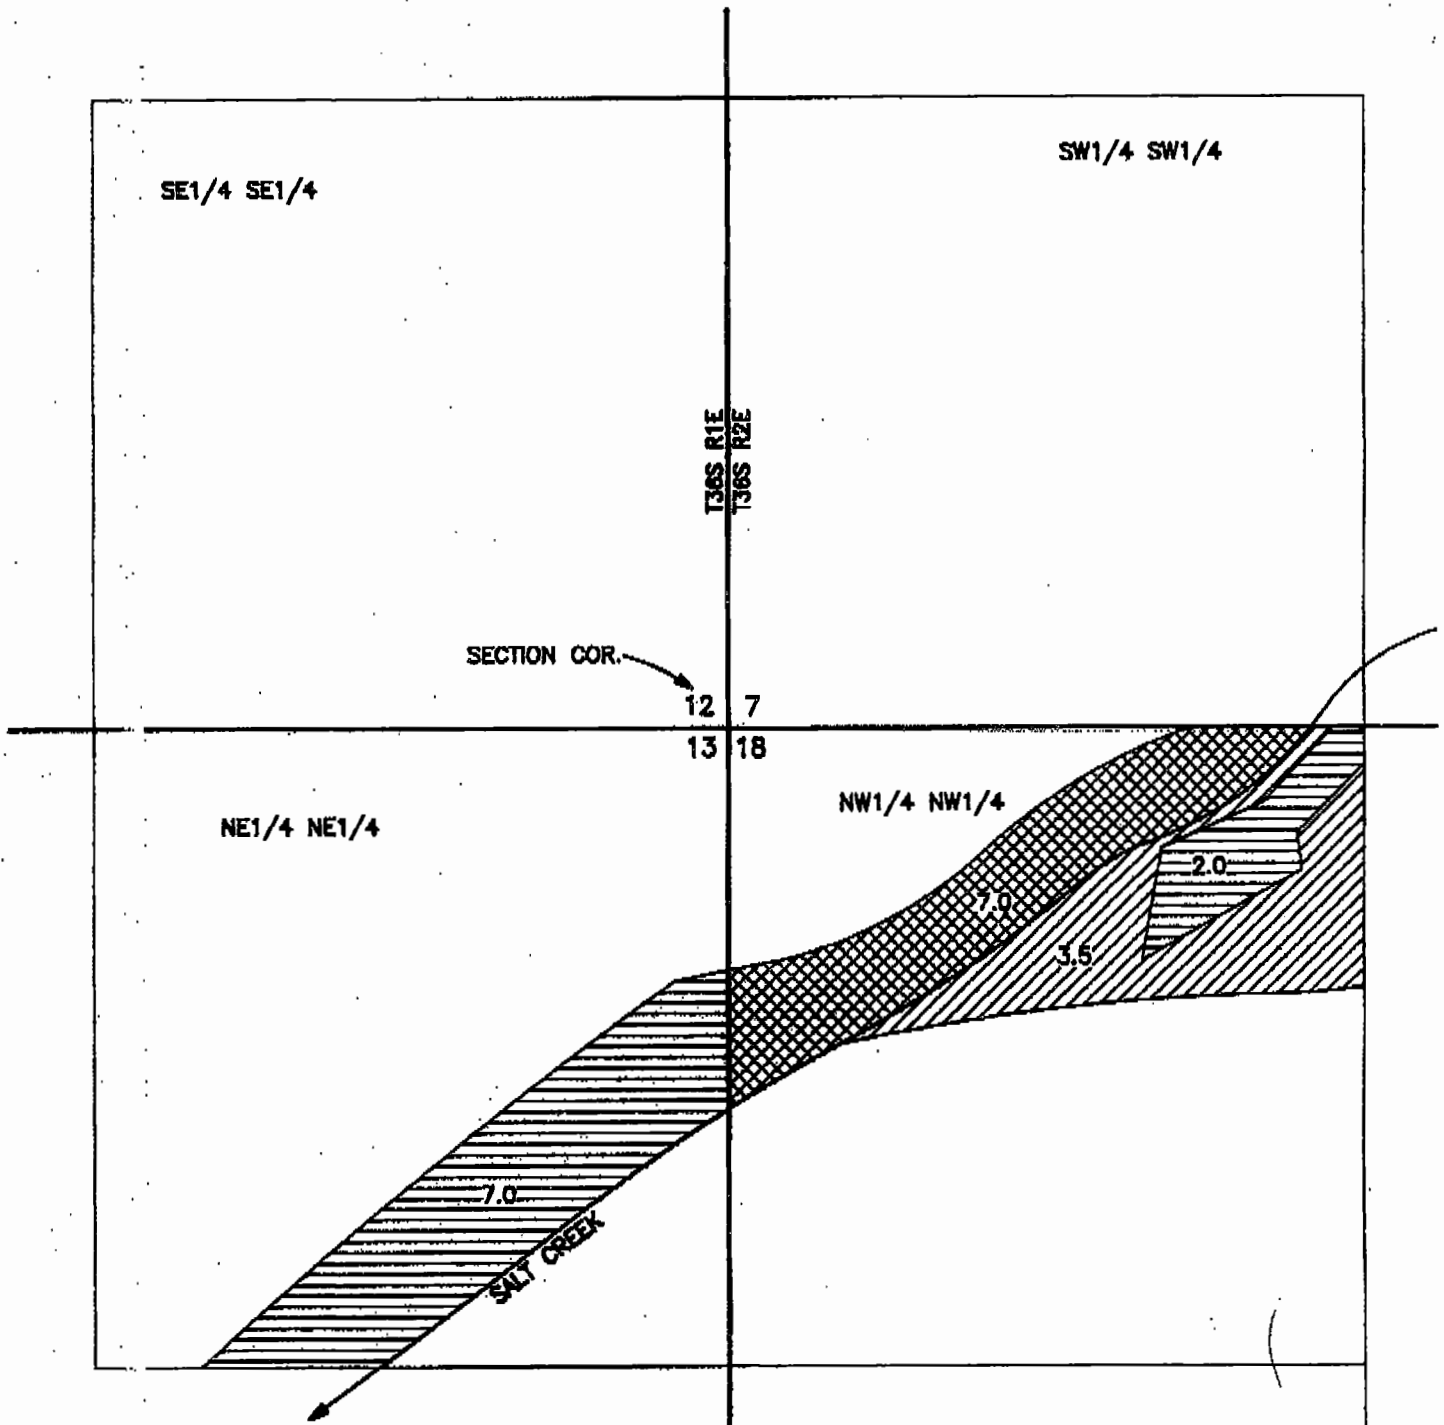FEBRUARY 7, 2001
REVISED: MAY 30, 2001



NOTE: MAP PREPARED FOR
WATER RIGHT PURPOSES ONLY,
NOT FOR PROPERTY BOUNDARY
LOCATIONS.

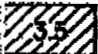-  = NO CHANGE, CERT. 17197
-  = TO BE TRANSFERED, CERT. 17197,
7.0 Ac. IN NE1/4 NE1/4
SECTION 13. 2.0 Ac. IN
NW1/4 NW1/4 SECTION 18,
AREA OCCUPIED BY AN ARENA.
-  = ADDITIONAL POINT OF DIVERSION
CERT. 17197




T.36S.,R.2E.,W.M.

Jackson County, Oregon
Tax Lot No. 362E - 5310

MAP TO ACCOMPANY AN APPLICATION
FOR A WATER RIGHT TRANSFER
(CHANGE IN PLACE OF USE AND
ADDITIONAL POINT OF DIVERSION)

FOR: H.J. HANSCOM
and TERRY MATLOCK
P.O. BOX 2033
WHITE CITY, OR. 97503

PREPARED BY:
GARY D. KAISER
19440 HWY. 62
EAGLE POINT, OR. 97524
FEBRUARY 7, 2001
REVISED: MAY 30, 2001

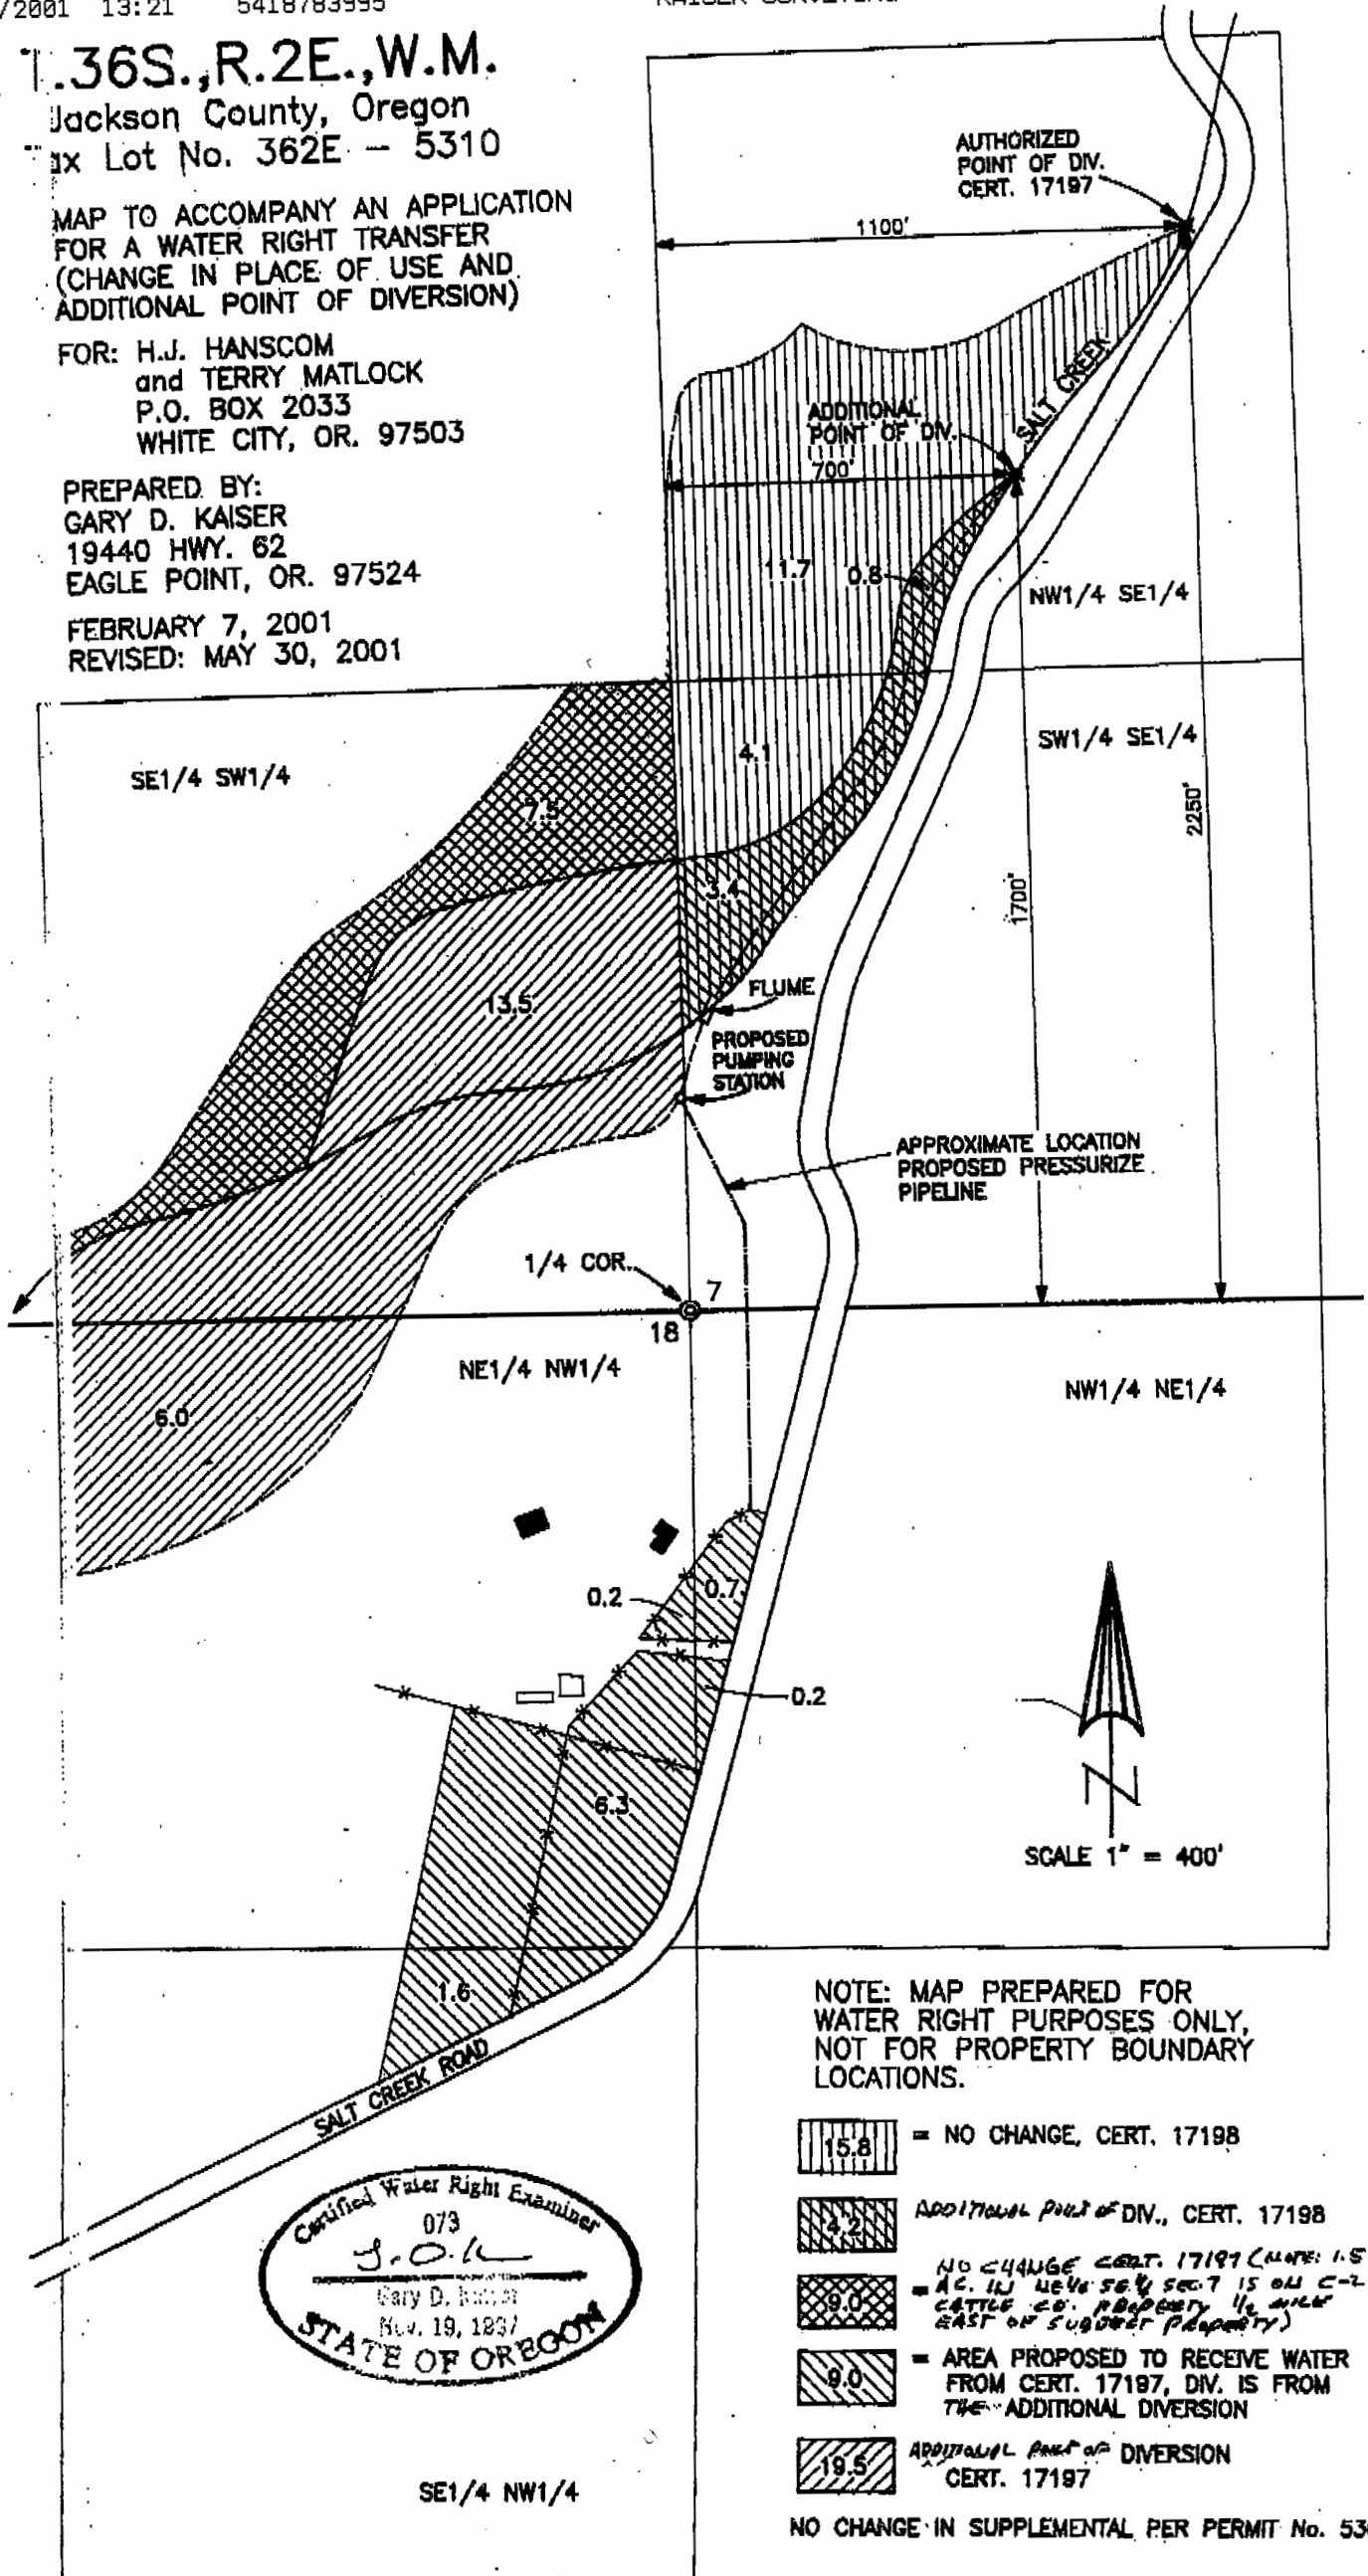

AUTHORIZED
POINT OF DIV.
CERT. 17197

ADDITIONAL
POINT OF DIV.
700'

NW1/4 SE1/4

SW1/4 SE1/4

SE1/4 SW1/4

1700'

2250'

FLUME
PROPOSED
PUMPING
STATION

APPROXIMATE LOCATION
PROPOSED PRESSURIZE
PIPELINE

1/4 COR.

7

NE1/4 NW1/4

NW1/4 NE1/4

6.0

0.2

0.7

0.2

6.3




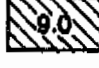

1.6

Certified Water Right Examiner
073
J.D.K.
Gary D. Kaiser
Nov. 19, 1837
STATE OF OREGON

SE1/4 NW1/4

SCALE 1" = 400'

NOTE: MAP PREPARED FOR
WATER RIGHT PURPOSES ONLY,
NOT FOR PROPERTY BOUNDARY
LOCATIONS.


-  = NO CHANGE, CERT. 17198
-  = ADDITIONAL POINT OF DIV., CERT. 17198
-  = NO CHANGE CERT. 17197 (NOTE: 1.5 AC. IN NE1/4 SW1/4 SEC. 7 IS ON C-2 CATTLE CO. PROPERTY 1/2 MILE EAST OF SUBJECT PROPERTY)
-  = AREA PROPOSED TO RECEIVE WATER FROM CERT. 17197, DIV. IS FROM THE ADDITIONAL DIVERSION
-  = ADDITIONAL POINT OF DIVERSION CERT. 17197

NO CHANGE IN SUPPLEMENTAL PER PERMIT No. 53053


T.36S.,R.2E.,W.M.

TAX LOT No. 362E - 5310

NOTE: MAP PREPARED FOR WATER RIGHT PURPOSES ONLY, NOT FOR PROPERTY BOUNDARY LOCATIONS.

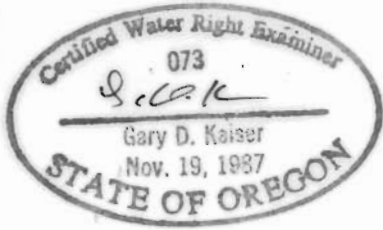

SCALE 1" = 400'

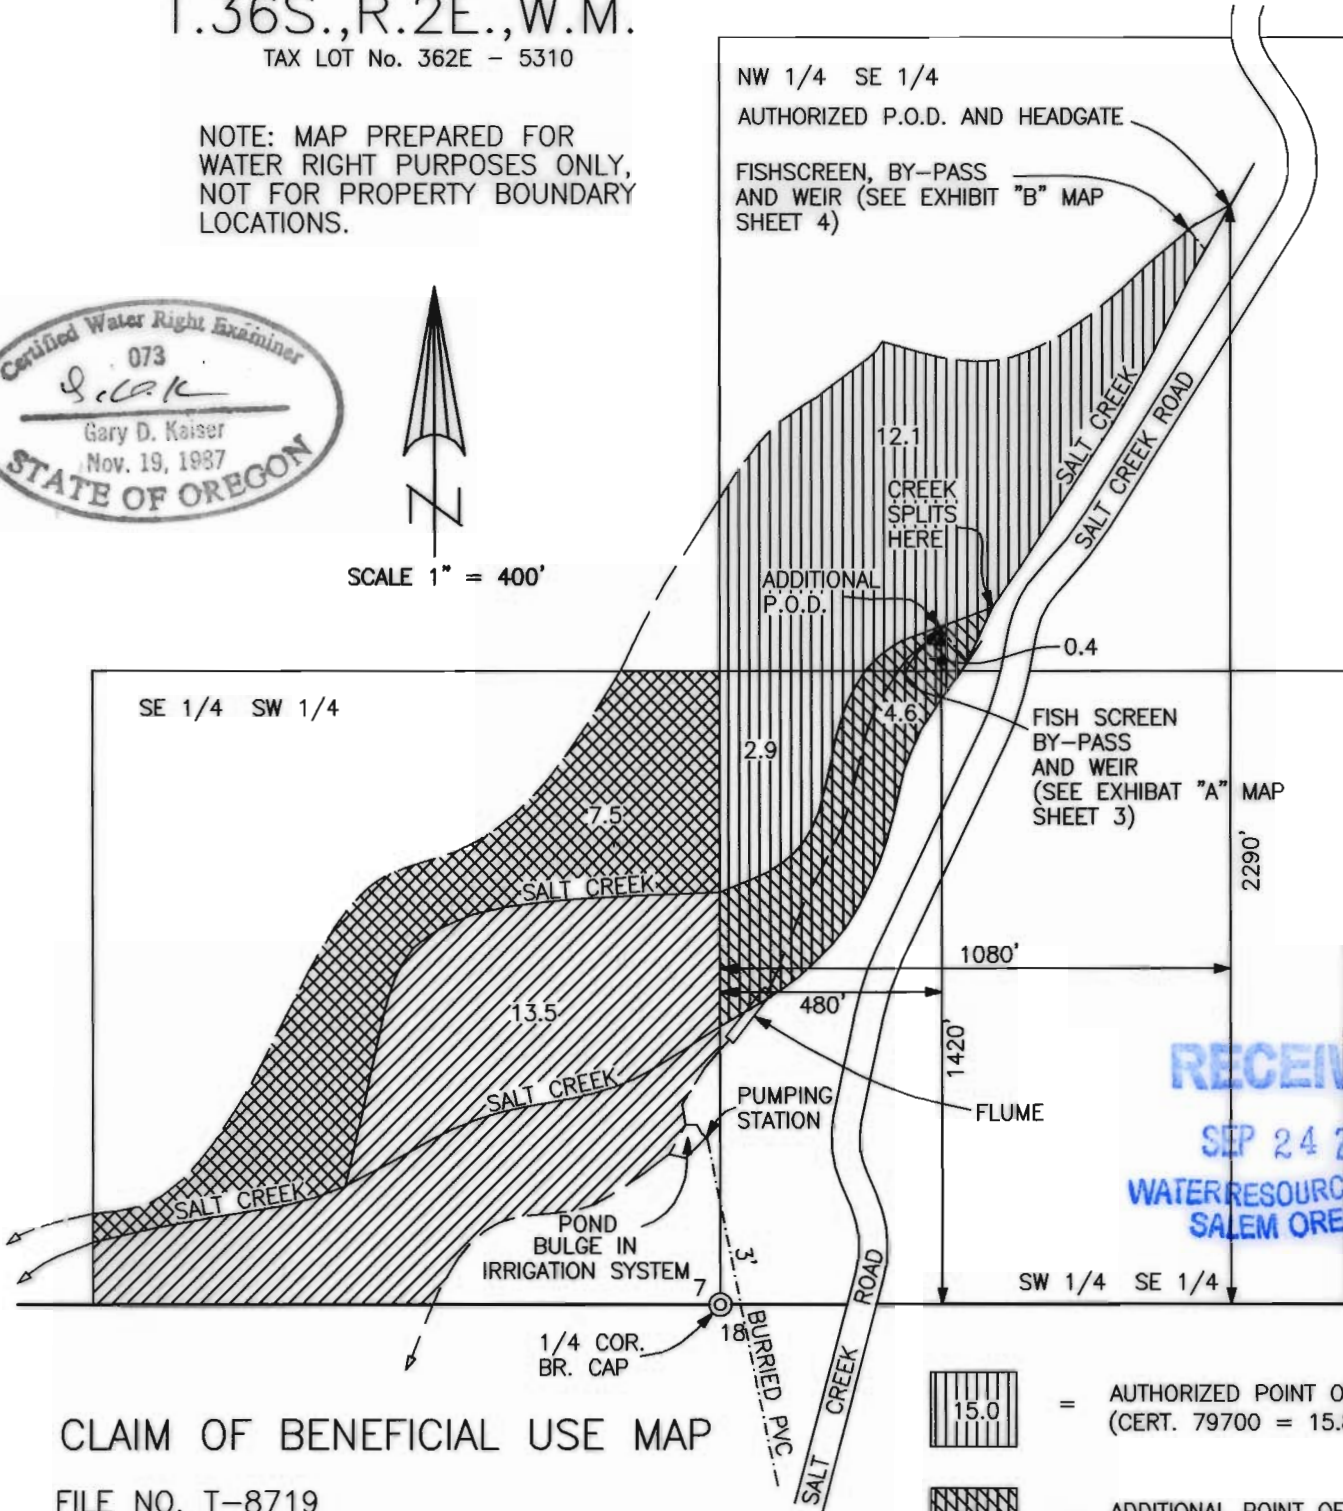

RECEIVED
 SEP 24 2007
 WATER RESOURCES DEPT
 SALEM OREGON

CLAIM OF BENEFICIAL USE MAP

FILE NO. T-8719

IN THE NAMES OF H.J. HANSCOM AND TERRY MATLOCK
 P.O. BOX 2033
 WHITE CITY, OREGON 97503

MAP PREPARED SEPTEMBER 7, 2007
 BY GARY D. KAISER



= AUTHORIZED POINT OF DIVERSION (CERT. 79700 = 15.8 A.C.)



= ADDITIONAL POINT OF DIV. (OLD CERT. 17198)




= NO CHANGE CERT. 79701 (NOTE: 1.5 AC. IN NE 1/4 SE 1/4 SEC. 7 IS ON C-2 CATTLE CO. PROPERTY 1/2 MILE EAST OF SUBJECT PROPERTY)



= ADDITIONAL POINT OF DIV. (OLD CERT. 17197)




T.36S.,R.2E.,W.M.

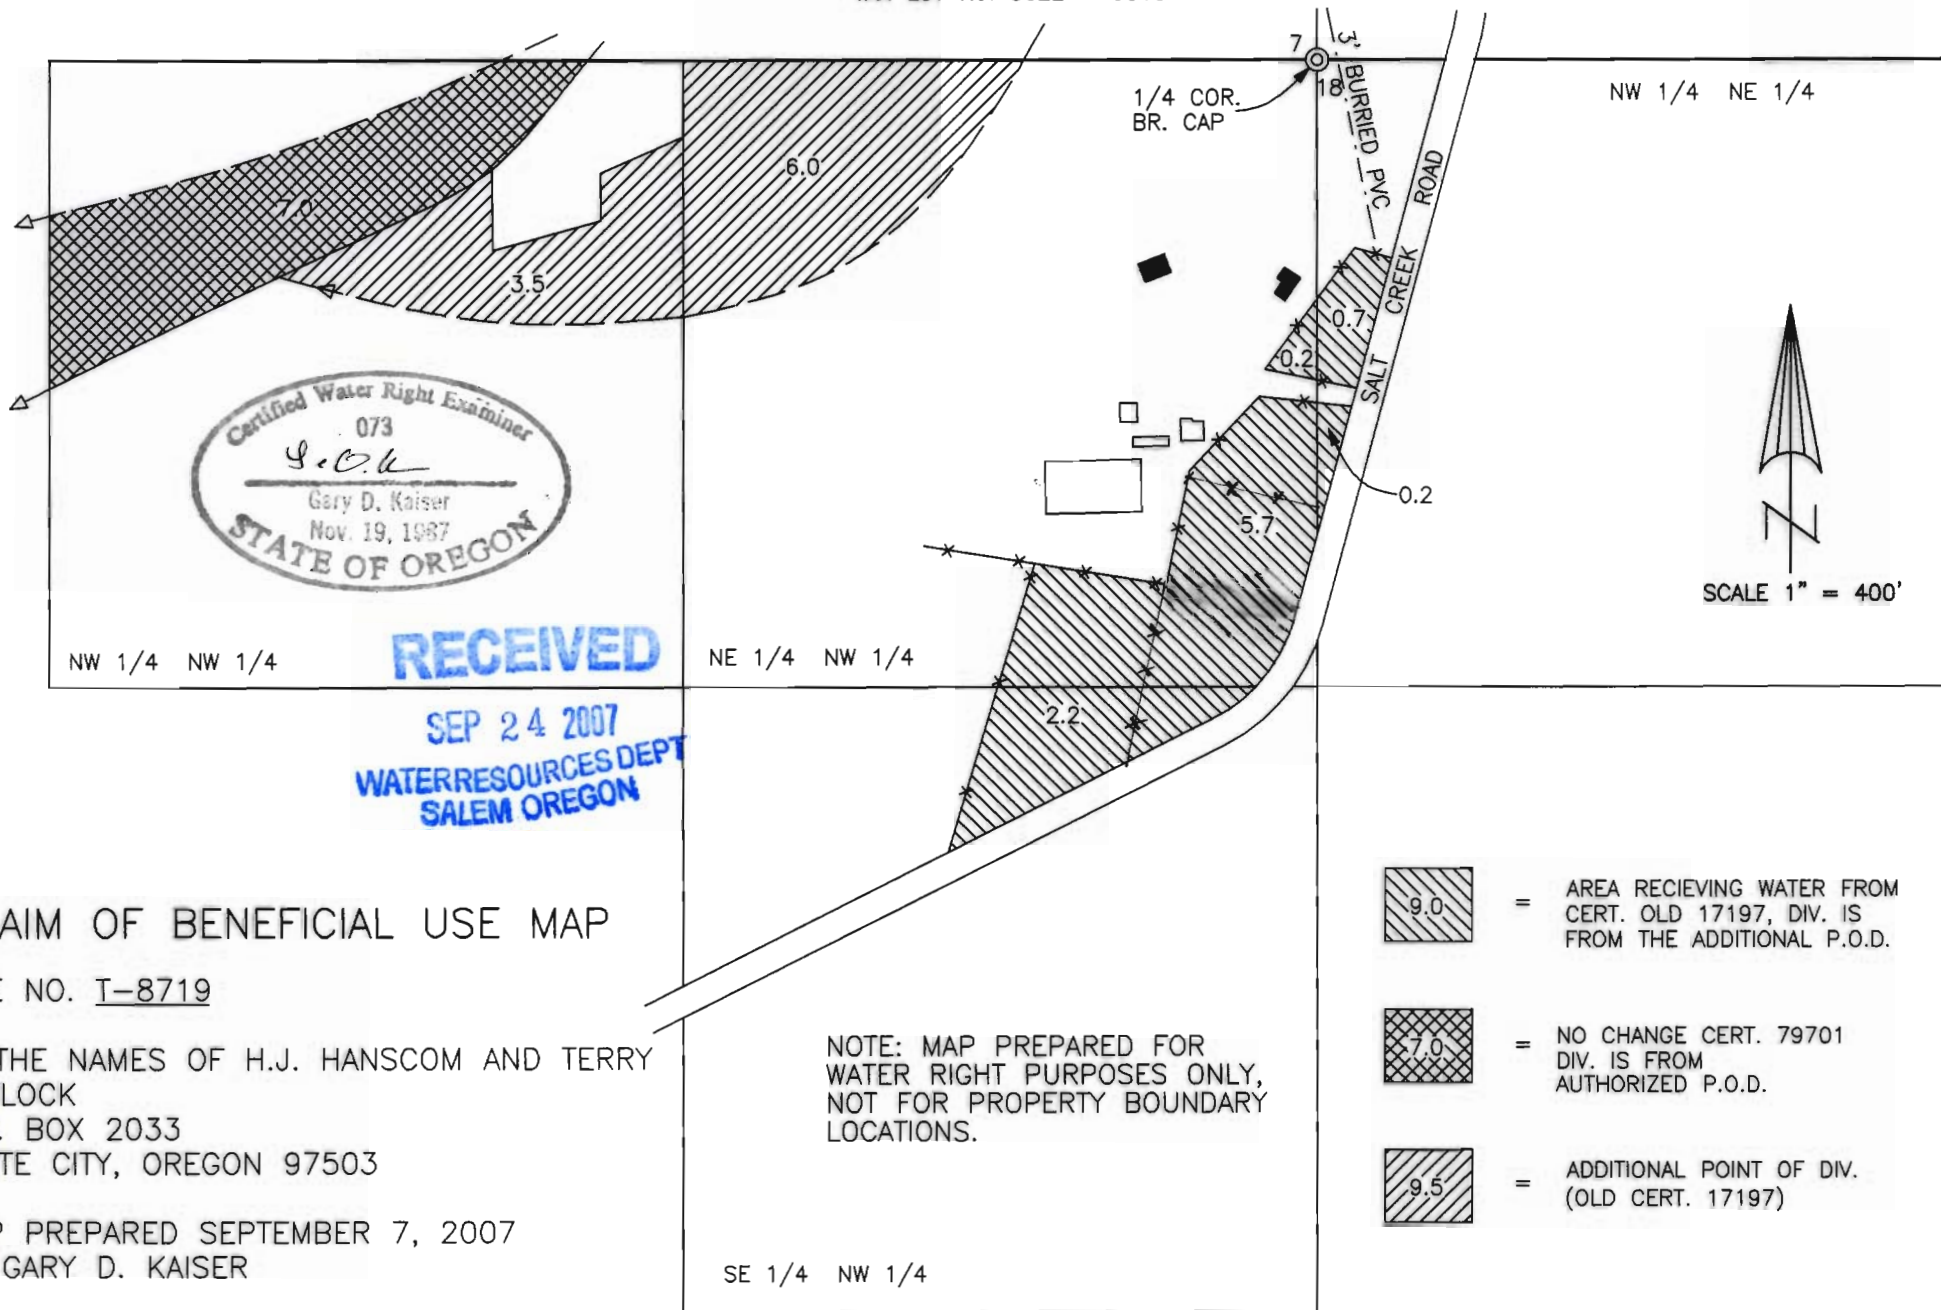TAX LOT No. 362E - 5310



Certified Water Right Examiner
 073
G.D.K.
 Gary D. Kaiser
 Nov. 19, 1987
 STATE OF OREGON

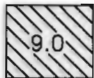RECEIVED
 SEP 24 2007
 WATER RESOURCES DEPT
 SALEM OREGON

-  = AREA RECEIVING WATER FROM CERT. OLD 17197, DIV. IS FROM THE ADDITIONAL P.O.D.
-  = NO CHANGE CERT. 79701 DIV. IS FROM AUTHORIZED P.O.D.
-  = ADDITIONAL POINT OF DIV. (OLD CERT. 17197)

NOTE: MAP PREPARED FOR WATER RIGHT PURPOSES ONLY, NOT FOR PROPERTY BOUNDARY LOCATIONS.

CLAIM OF BENEFICIAL USE MAP

FILE NO. T-8719

IN THE NAMES OF H.J. HANSCOM AND TERRY MATLOCK
 P.O. BOX 2033
 WHITE CITY, OREGON 97503

MAP PREPARED SEPTEMBER 7, 2007
 BY GARY D. KAISER


SE 1/4 NW 1/4

ADDITIONAL POINT OF DIVERSION


EXHIBIT "A"



SCALE 1" = 20'

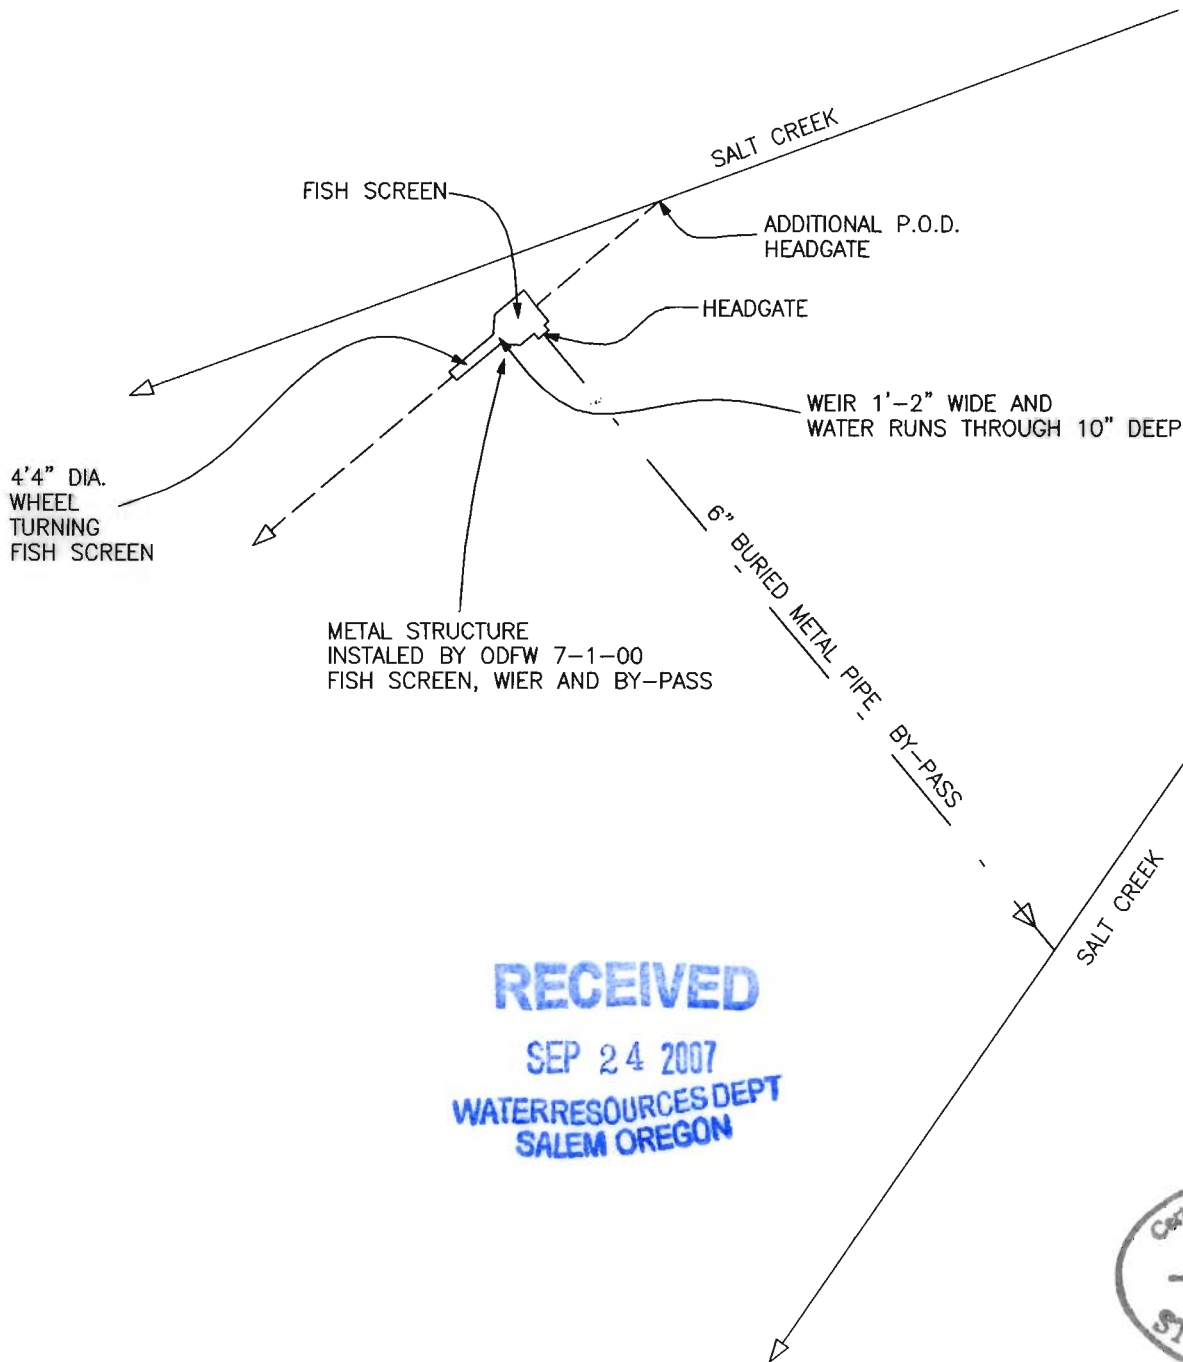

RECEIVED
SEP 24 2007
WATER RESOURCES DEPT
SALEM OREGON

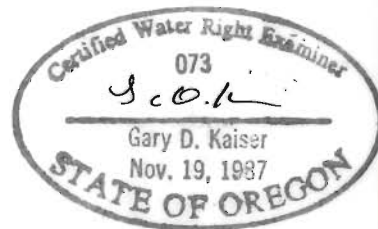

O.D.F.W. METAL STRUCTURE NEAR AUTHORIZED POINT OF DIVERSION

EXHIBIT "B"



SCALE 1" = 20'

