

TRANSFER APPLICATION MAP

IN THE NAME OF NICKEL MOUNTAIN L.L.C.

RECEIVED


DEC 03 2002

PERMIT 21988

CERTIFICATE 48232

WATER RESOURCES DEPT.
SALEM, OREGON

SECTIONS 16, 17, 28 & 29; TOWNSHIP 30 SOUTH, RANGE 6 WEST, W.M.

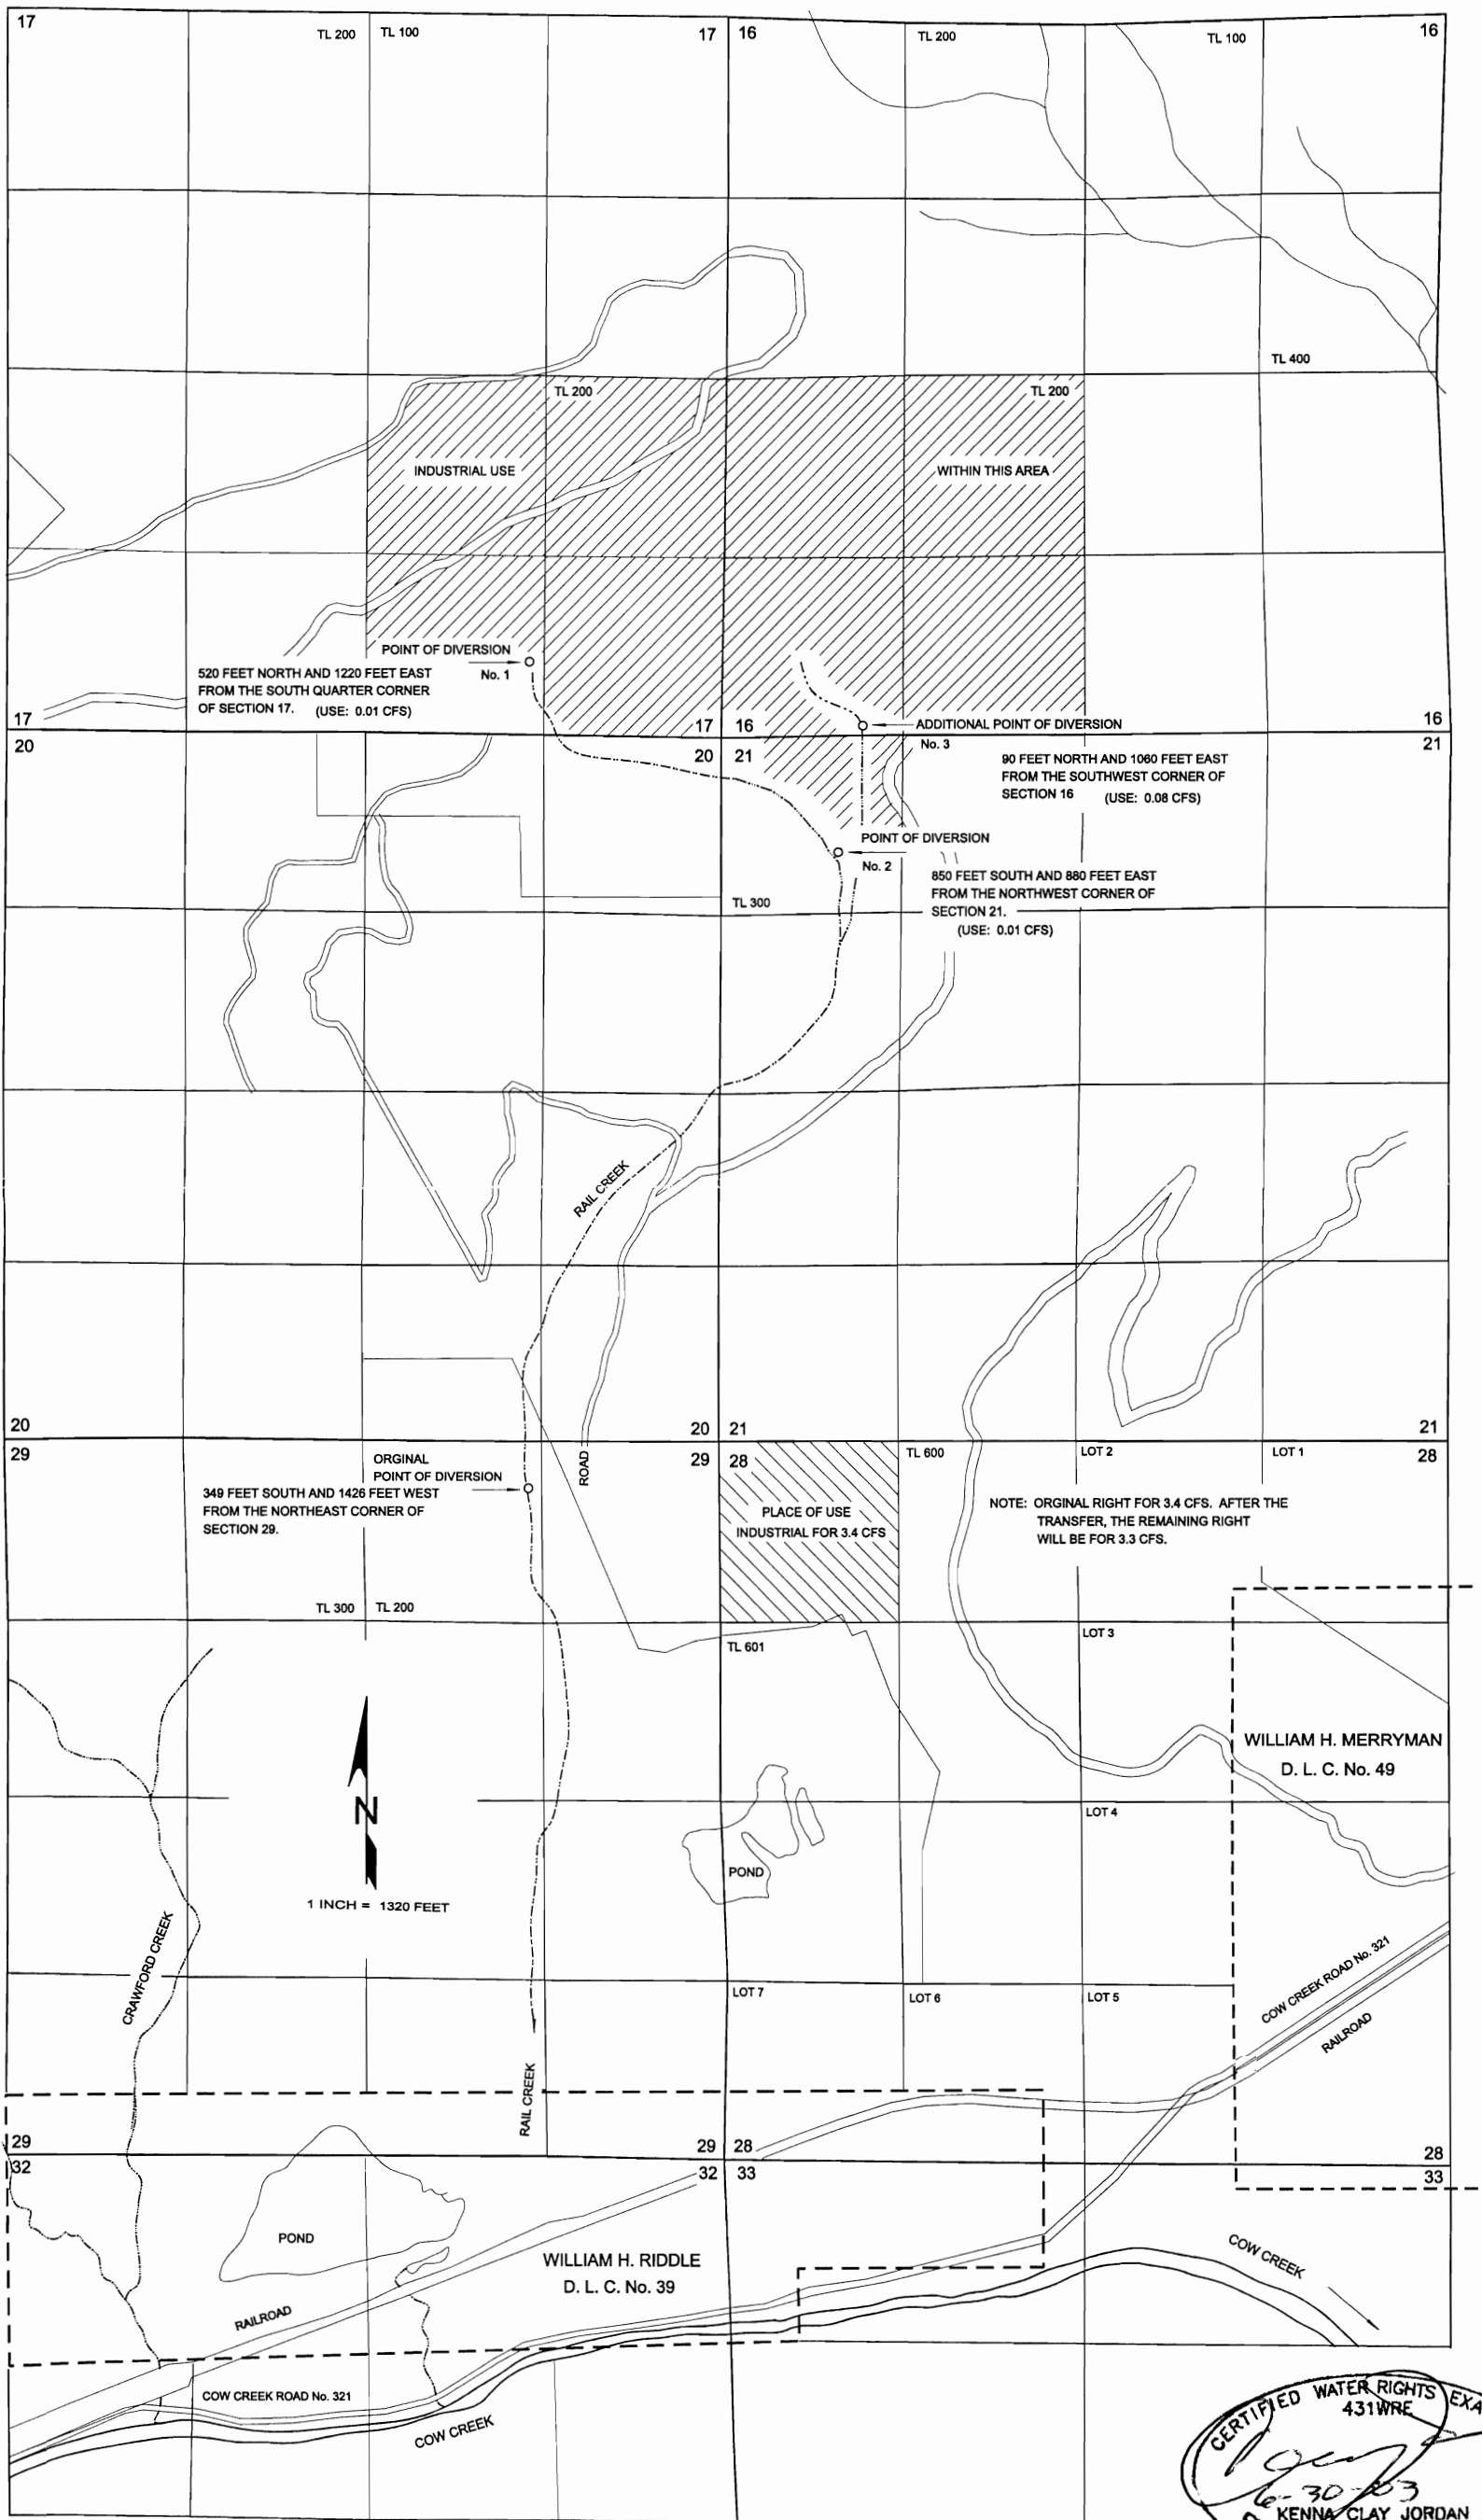

THE PURPOSE OF THIS MAP IS TO IDENTIFY THE LOCATION OF THE WATER RIGHT.
IT IS NOT INTENDED TO PROVIDE INFORMATION RELATIVE TO THE LOCATION OF
PROPERTY OWNERSHIP BOUNDARY LINES.

T-9286

