



T-8725

T.8S., R.6W., W.M.

To: Map

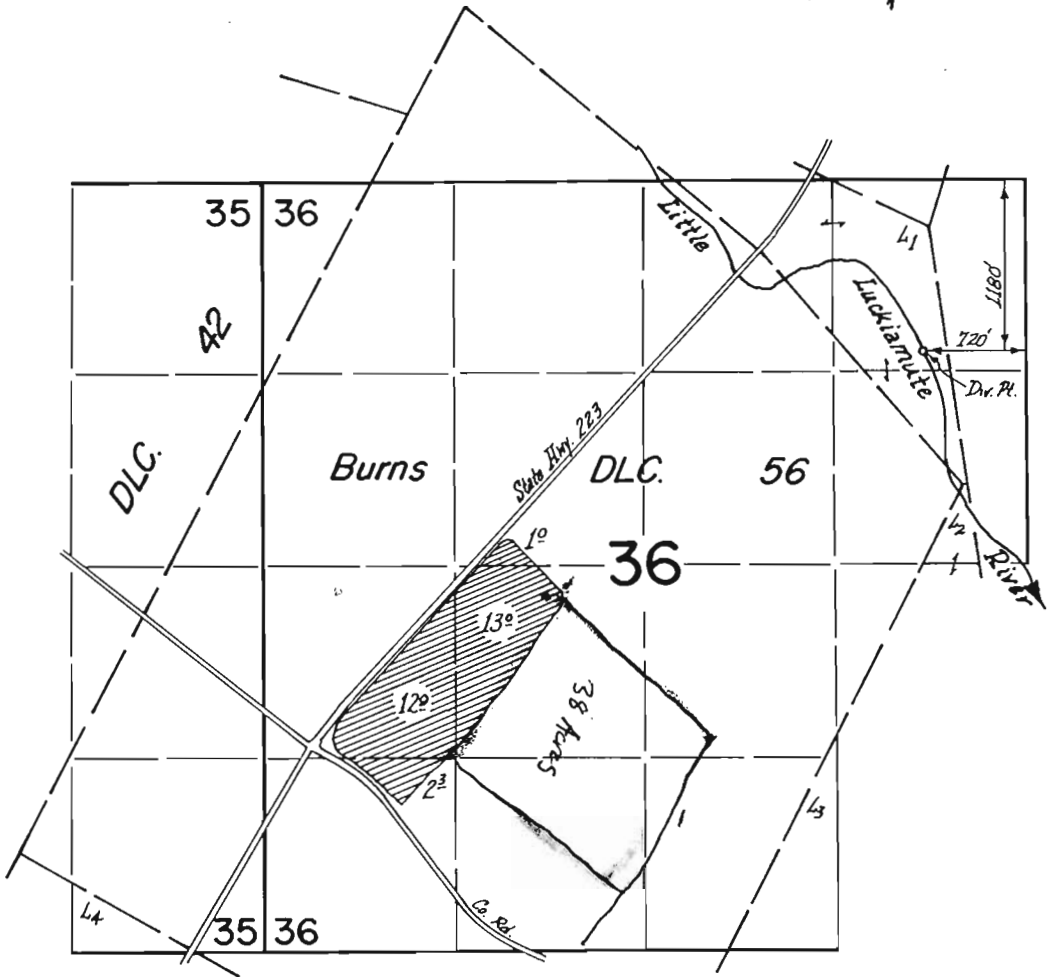

FINAL PROOF SURVEY
 UNDER

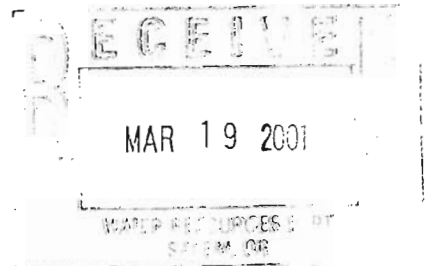

Application No. 53198 Permit No. 39475
 IN NAME OF

J. L. HENDRICKSON

Surveyed July 7 1977, by L.M. Toll