


T-8744

T.6S. R.2W. W.M.

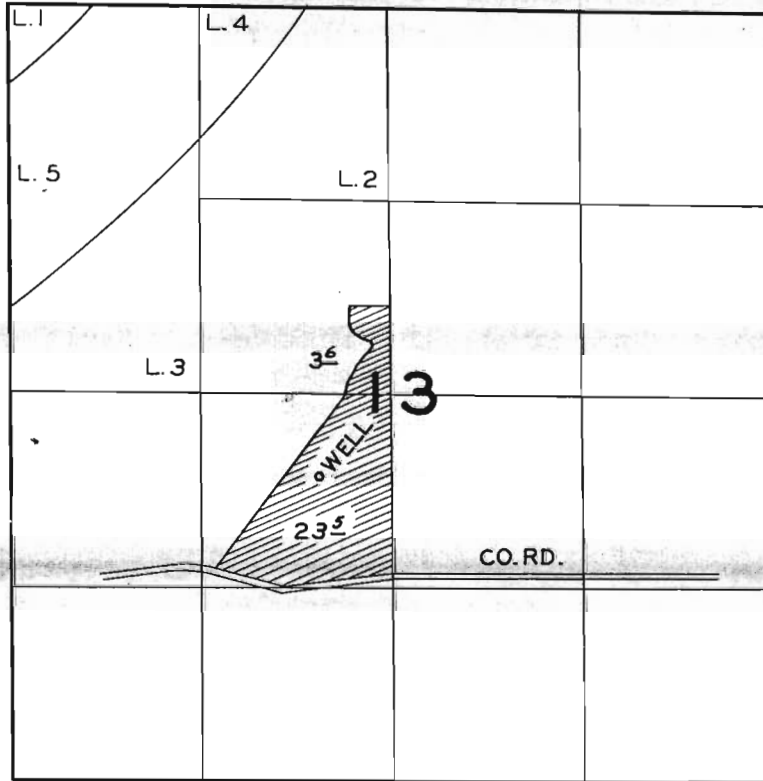

FINAL PROOF SURVEY UNDER

Application No. G.1246 Permit No. G.1010
IN NAME OF

ANTON PFAU, JR.

Surveyed NOV. 4 19.60, by R. H. JACKSON