


TOWNSHIP 9 SOUTH, RANGE 4 WEST, W.M.

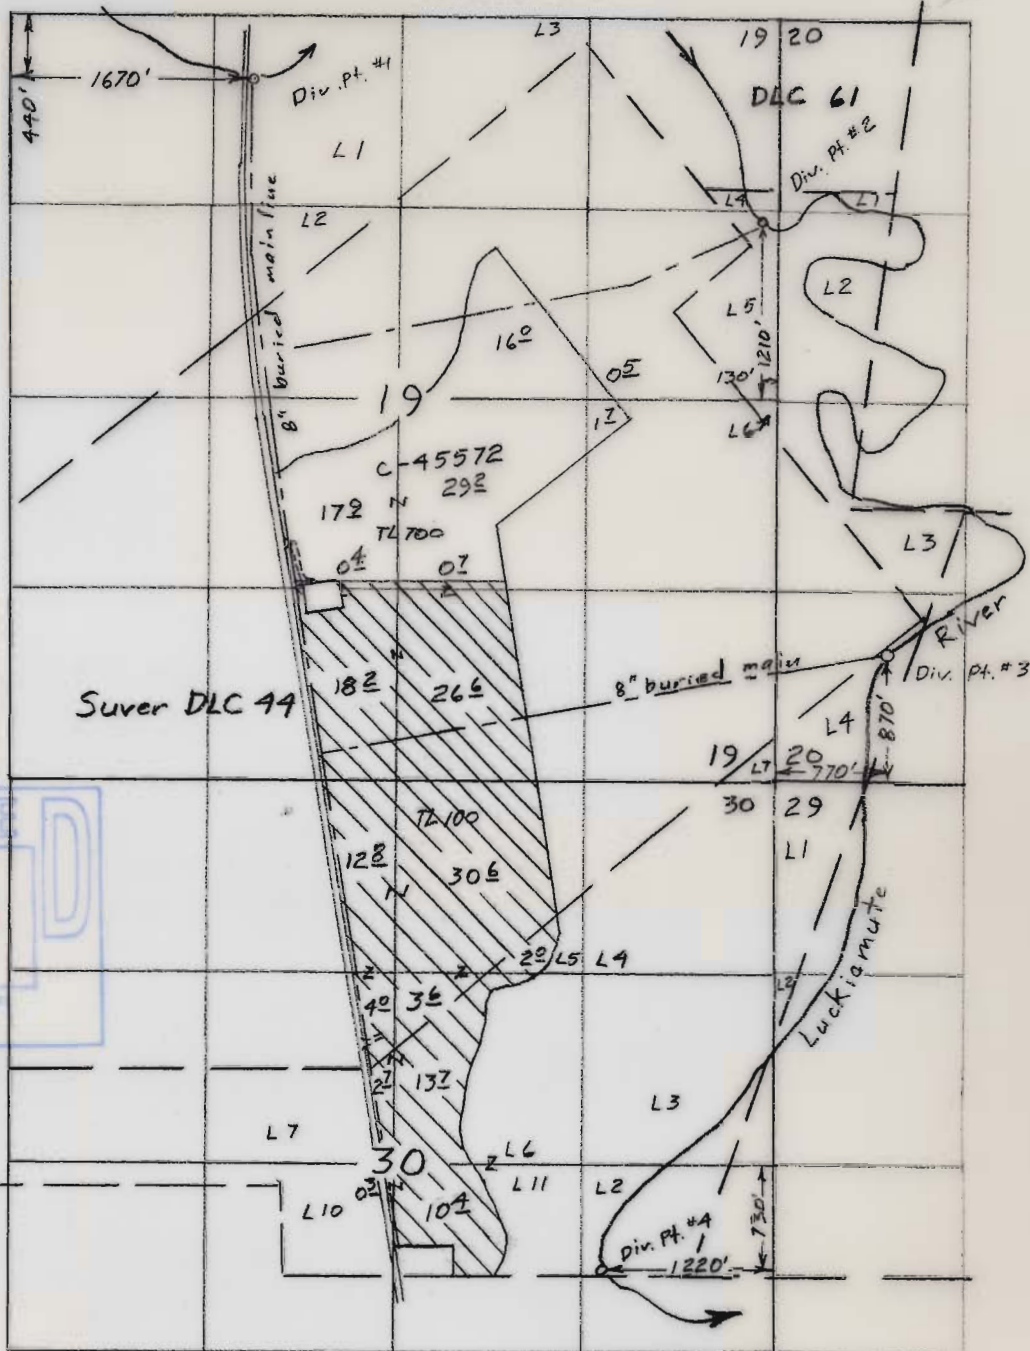


Scale 1" = 1320'



T-8748

Surveyed Sept. 15, 2003

Claim of Beneficial Use Map  
for  
J. Frank Schmidt & Son Co.

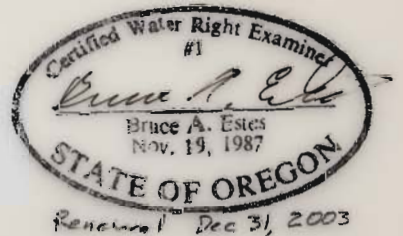

This map is for the purpose of locating a water right only and has no intent to provide legal dimensions or the location of property lines.

**ESTES SURVEYS, LLC**  
 PO Box 17519 Salem, OR 97305-7519 (503) 585-7593  
 60382 Arnold Rd Bend, OR 97702 (541) 382-7391