T.4 & 5S. R.4W. W.M.

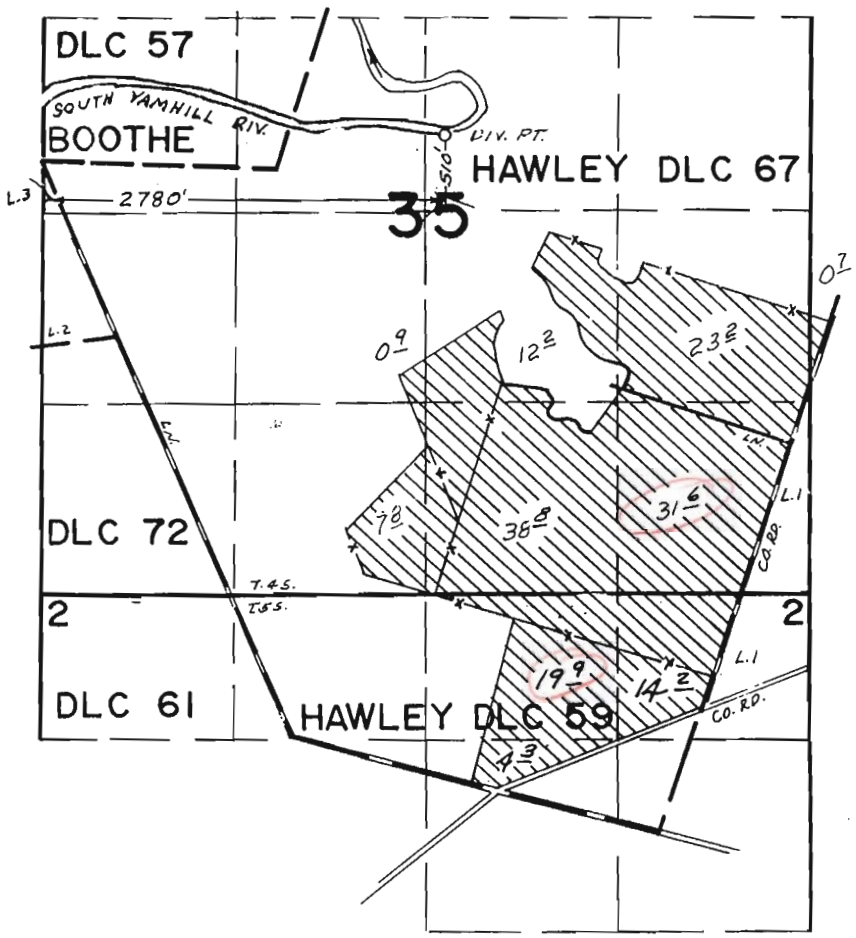

FINAL PROOF SURVEY
UNDER

Application No. 53964 Permit No. 40709
IN NAME OF

GARY CRUICKSHANK

Surveyed MAR. 10 1978, by L.H. NUNN
MAY 9, 1979 C.R. RODRIGUEZ

DFG-ILL-161