

TUMALO IRRIGATION DISTRICT  
WATER RIGHTS SURVEY

FOR


Tumalo Irrigation District / Columella Properties

LOCATED IN THE NE 1/4 OF THE SE 1/4  
OF SECTION 35, T.16 S., R.11 E., W.M.

TAX LOTS # 2000

DESCHUTES COUNTY, OREGON

Final Proof Map

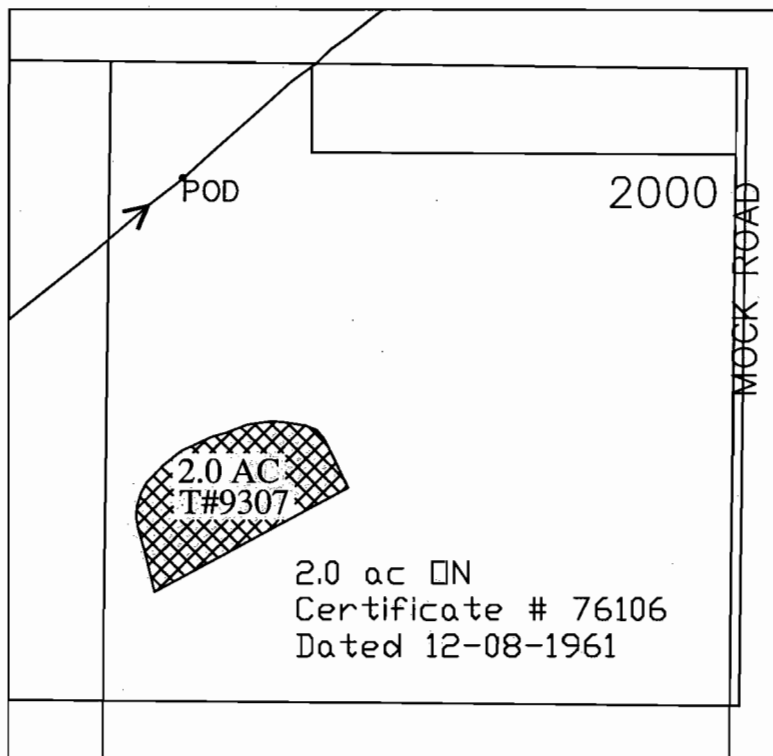

RECEIVED  
AUG 22 2006  
WATER RESOURCES DEPT  
SALEM, OREGON



SCALE: 1" = 400'

THE PREPARATION OF THIS MAP IS FOR THE PURPOSE  
OF IDENTIFYING THE LOCATION OF THE WATER RIGHT  
ONLY AND HAS NO INTENT TO PROVIDE DIMENSIONS OR  
LOCATIONS OF PROPERTY OWNERSHIP LINES.

Prepared By: Tumalo Irrigation District, 64697 Cook Ave, Bend, Oregon 97701 541-382-3053