


COPY

T.2N.R.4W.WM.

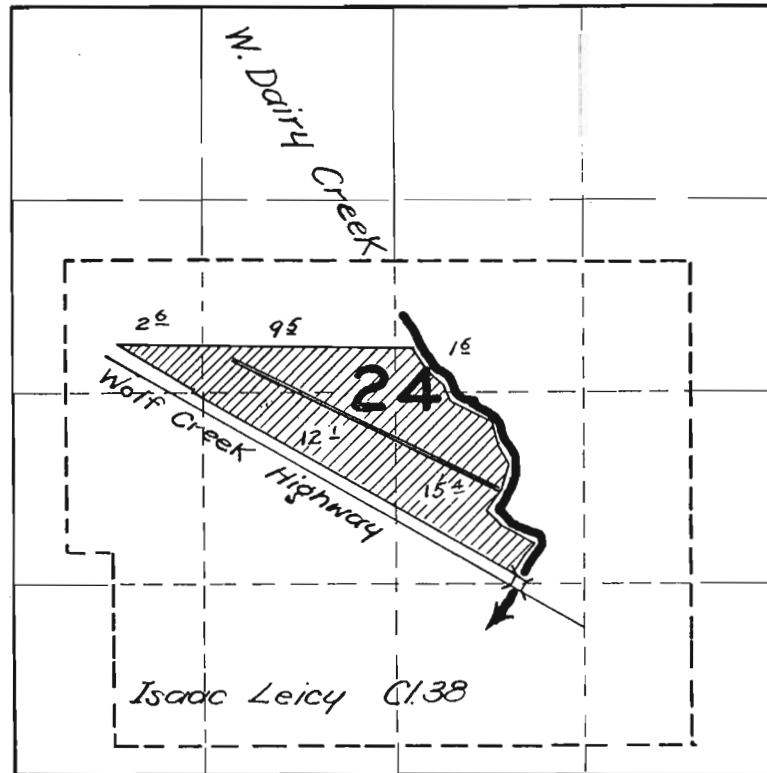

FINAL PROOF SURVEY

UNDER

Application No. 20730 Permit No. 16204

IN NAME OF

A. J. RANZAU

Surveyed 6 / 26 19 52, by H. L. COFFMAN