
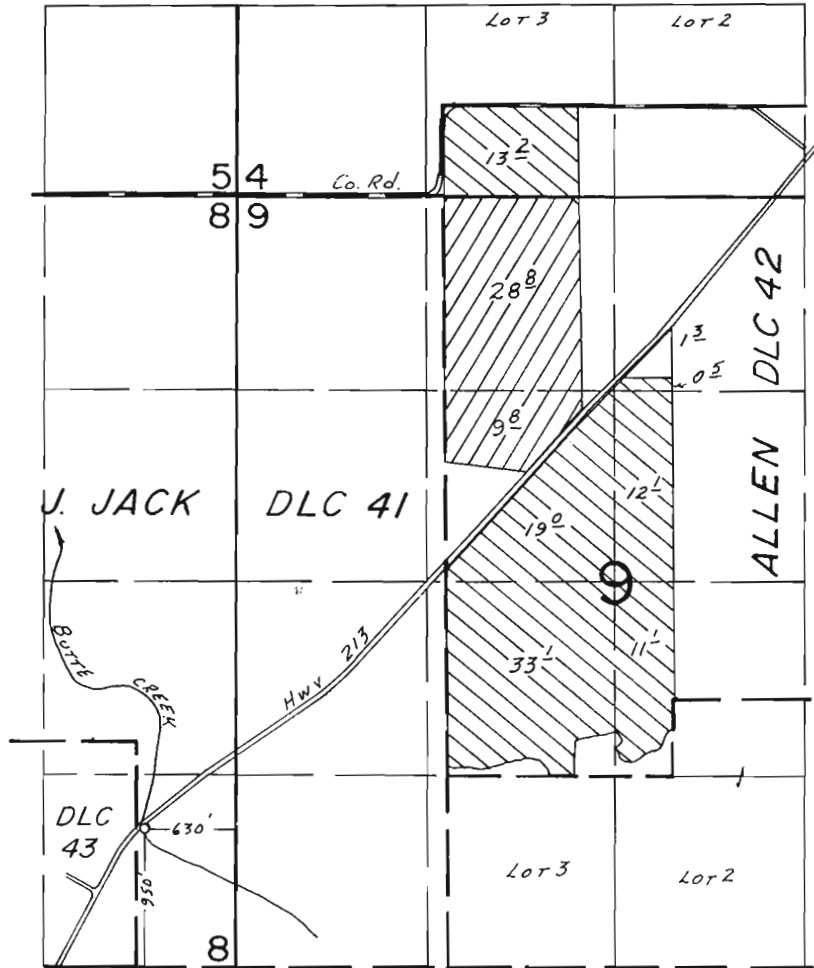
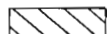


T. 6 S., R. 1 E., W. M.

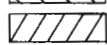

 Primary
 Supplemental

SCALE: 1" = 1320'

FINAL PROOF SURVEY UNDER

Application No. 61721.... Permit No. 47800.....
IN NAME OF

.....HAROLD KRAEMER.....

Surveyed MAY..18.. 19.84, by B.W..BISHOP.....