


TOWNSHIP 17 SOUTH, RANGE 2 WEST, W.M.

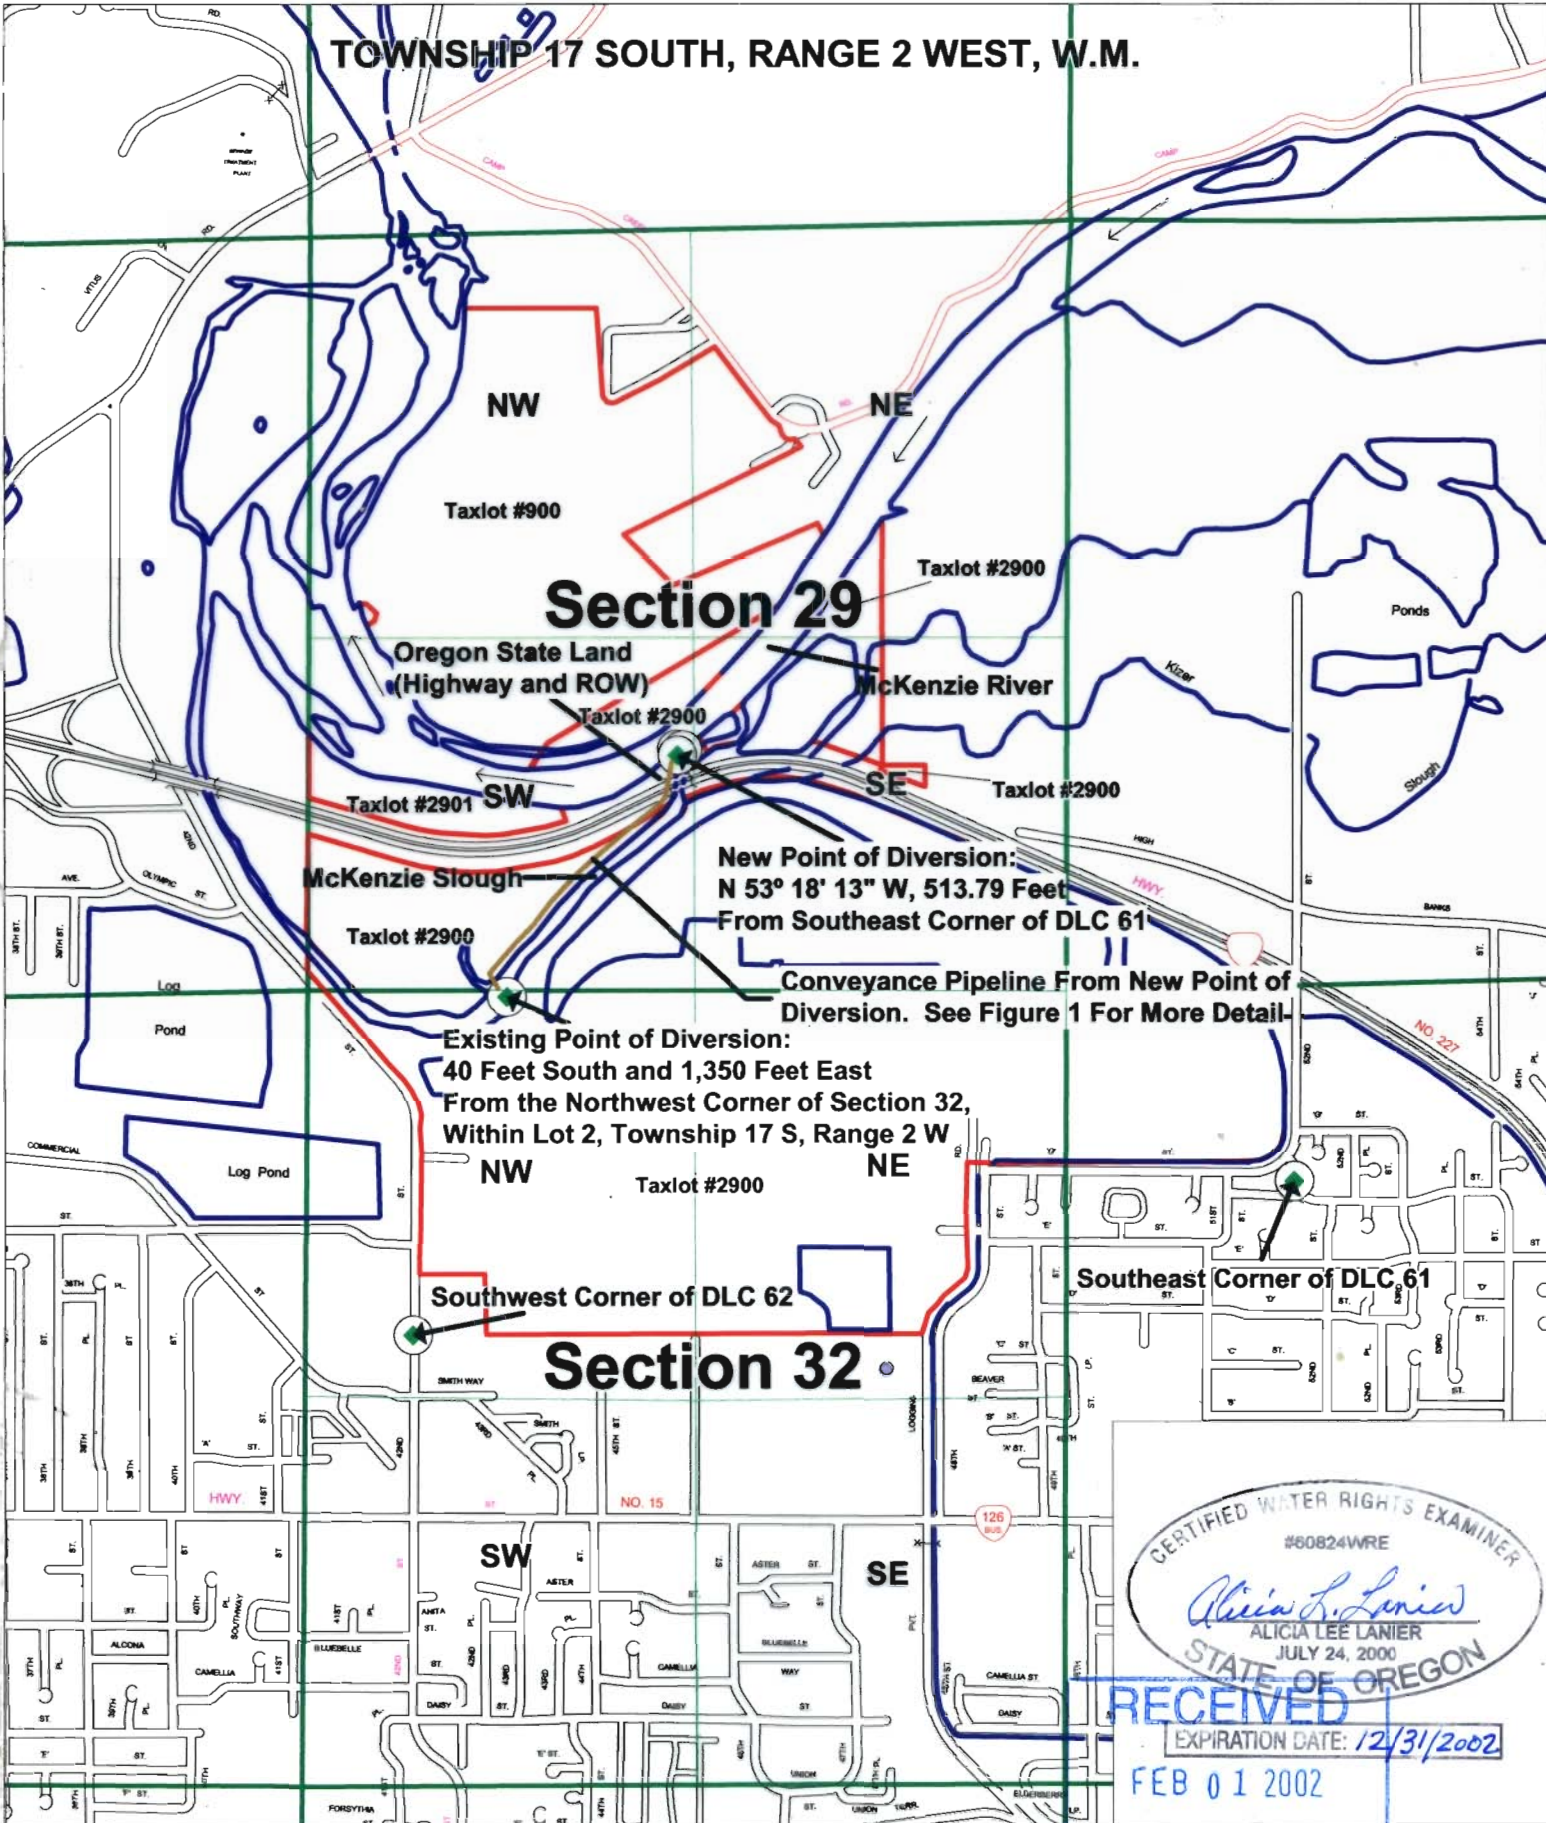

CERTIFIED WATER RIGHTS EXAMINER
 #60824WRE
Alicia L. Lanier
 ALICIA LEE LANIER
 JULY 24, 2000
 STATE OF OREGON

RECEIVED
 EXPIRATION DATE: 12/31/2002
 FEB 01 2002

WATER RESOURCES DEPT
 Permit # K011 Euhus

Weyerhaeuser Company
 P.O. Box 275
 Springfield, Oregon 97477

THIS MAP WAS PREPARED FOR THE PURPOSE OF IDENTIFYING THE LOCATION OF THE WATER RIGHT ONLY. IT IS NOT INTENDED TO PROVIDE LEGAL DIMENSIONS OR LOCATION OF PROPERTY OWNERSHIP LINES.



Scale: 1 inch = 1,320 feet

Final Proof Survey Under
 Application Number: 22551
 Permit Number: 17511
 Certificate Number: 20901
 Transfer Number: T-8792
 Date of Final Proof Survey:
 August 22, 2001

