


COPY

T. 7 S., R. 1 W., W.M.

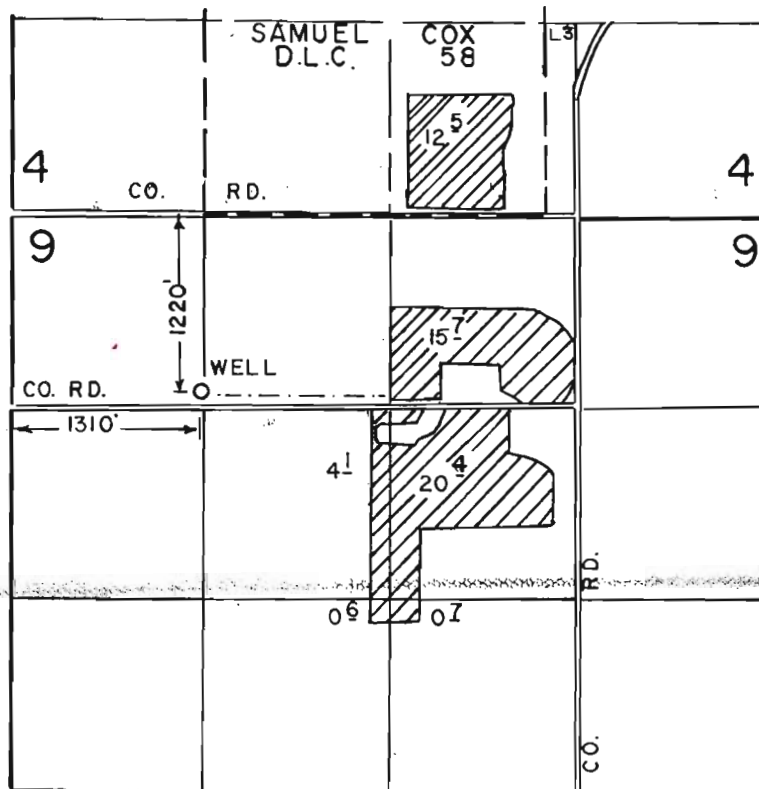

FINAL PROOF SURVEY UNDER

Application No. G-11668 Permit No. G-10769
IN NAME OF

RAYMOND J. KUENZI

Surveyed MAY 29 1990, by T.M. WARREN

6-25-90 DSM
41047-278-132D