


FINAL PROOF SURVEY  
 IN NW 1/4 SW 1/4 SEC 31  
 T2N, R42E, W.M.  
 WALLOWA COUNTY, ORE

SEPT. 5, 2006

SCALE 1" = 1320'

WATER RIGHTS TRANSFER T-8805  
 FROM CERTIF. # 72349

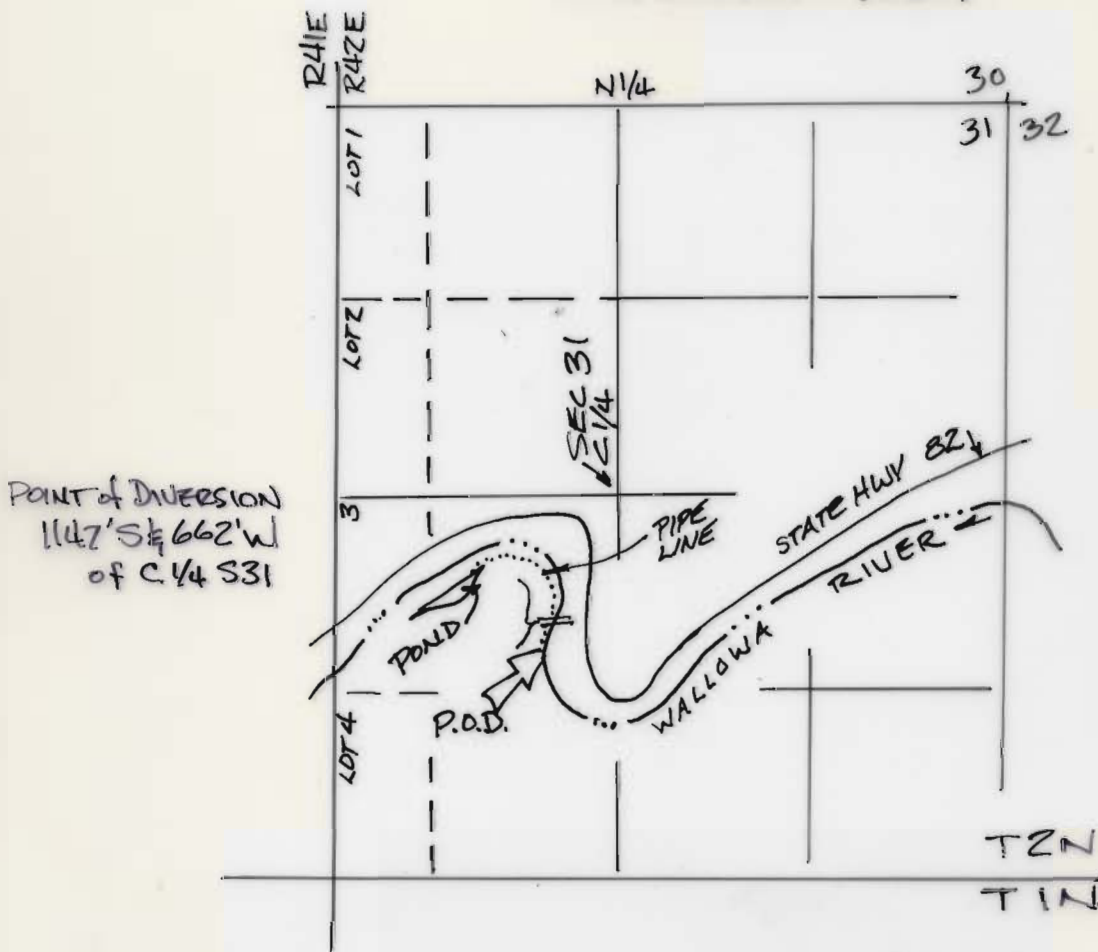

LESLIE KEENON, CWRE  
 16721 NOAKES RD  
 VERNONIA, ORE.  
 97064



APPLICANT:

JAMES A. SMEJKAL  
 42142 PALACE DR.  
 BANKS, OREGON

97106

