


TRANSFER APPLICATION MAP

IN THE NAME OF: KENNETH MAACK
 SECTIONS 7, 8, 17 & 18, T2S, R9W, W.M.
 TILLAMOOK COUNTY
 OCTOBER 19, 2000

RECEIVED
 MAY - 2 2005
 WATER RESOURCES DEPT
 SALEM, OREGON

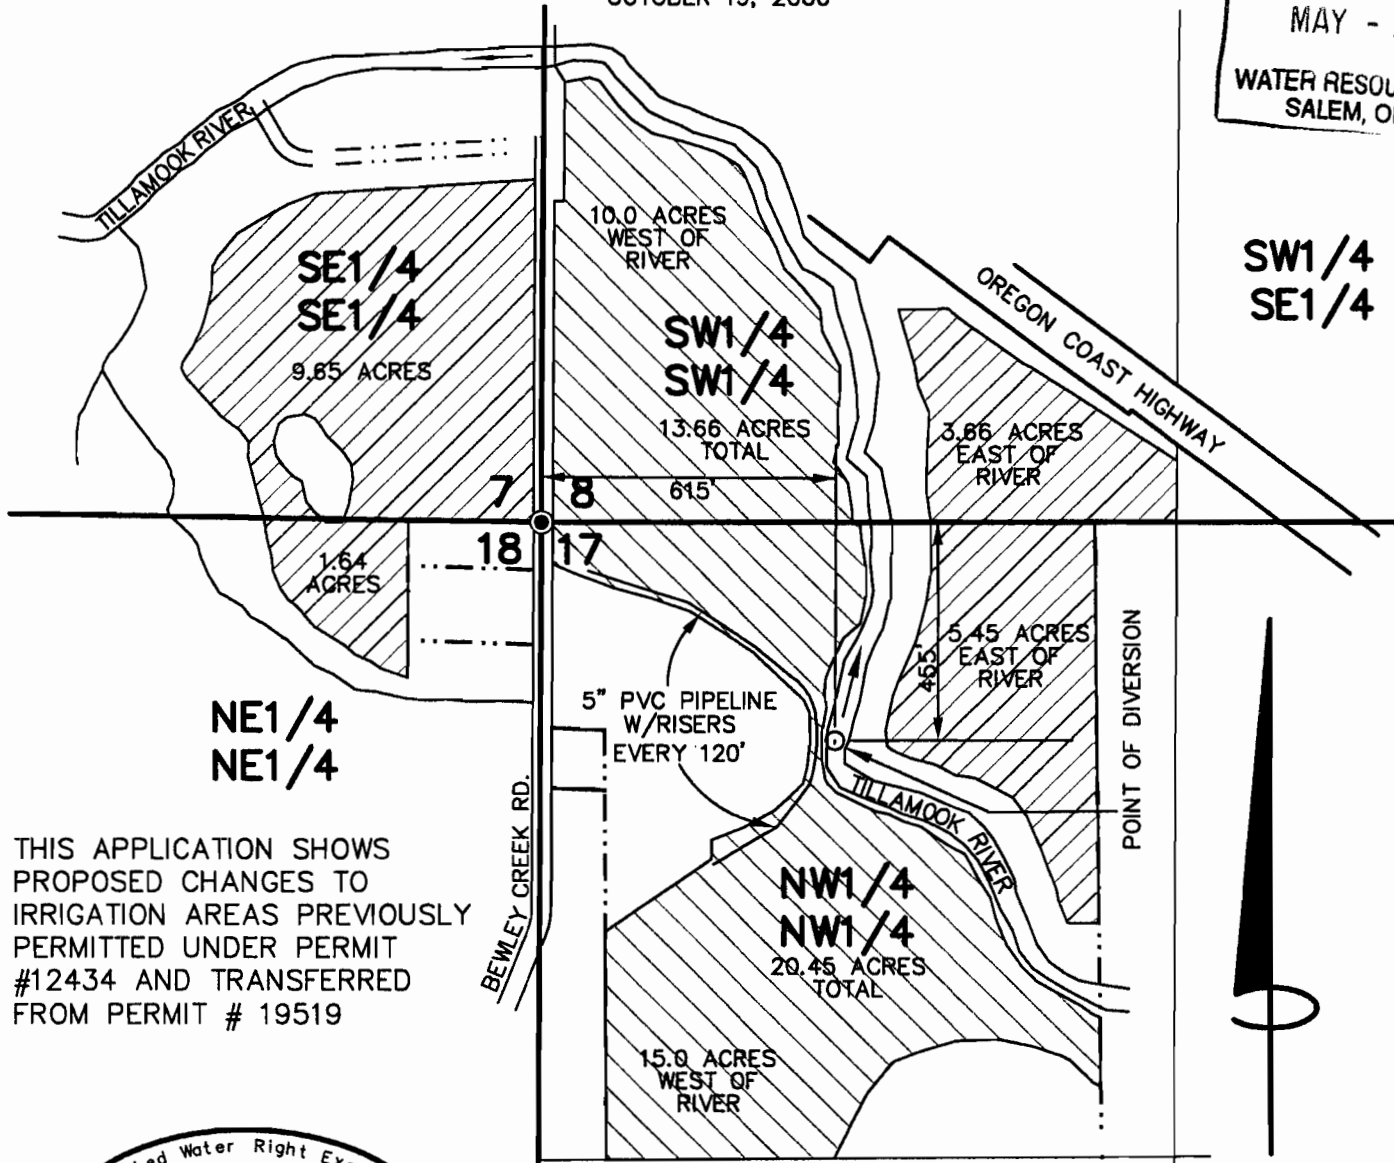

THIS APPLICATION SHOWS PROPOSED CHANGES TO IRRIGATION AREAS PREVIOUSLY PERMITTED UNDER PERMIT #12434 AND TRANSFERRED FROM PERMIT # 19519

Certified Water Right Examiner
 #175 WRE
Ronald G. Larson
 Ronald G. Larson
 May 17, 1988
 STATE OF OREGON

RENEWAL DATE: DECEMBER 31, 2006

- = AREAS OF EXISTING WATER RIGHTS PERMIT # 12434
- = AREAS OF WATER RIGHTS TRANSFER PERMIT # 19519

SCALE:
 1" = 400'

M021208-01-01.DWG

THE PURPOSE OF THIS MAP IS TO IDENTIFY THE LOCATION OF THE WATER RIGHT. IT IS NOT INTENDED TO PROVIDE INFORMATION RELATIVE TO THE LOCATION OF PROPERTY OWNERSHIP BOUNDARY LINES.

HLB & Associates INCORPORATED

Surveying • Civil Engineering • Planning • Water Rights • Wetlands Consulting

CLATSOP COUNTY	PACIFIC COUNTY	TILLAMOOK COUNTY
4253-A HWY 101 N. GEARHART, OR 97138 (503) 738-3425 FAX: (503) 738-7455	1715-B N. PACIFIC AVE. LONG BEACH, WA 98631 (360) 642-4454 FAX: (360) 642-4054	160 LANEDA AVE MANZANITA, OR 97130 (503) 368-5394 FAX: (503) 368-5847

WWW.HLBINC.COM