


T.5S.R.3W.W.M.

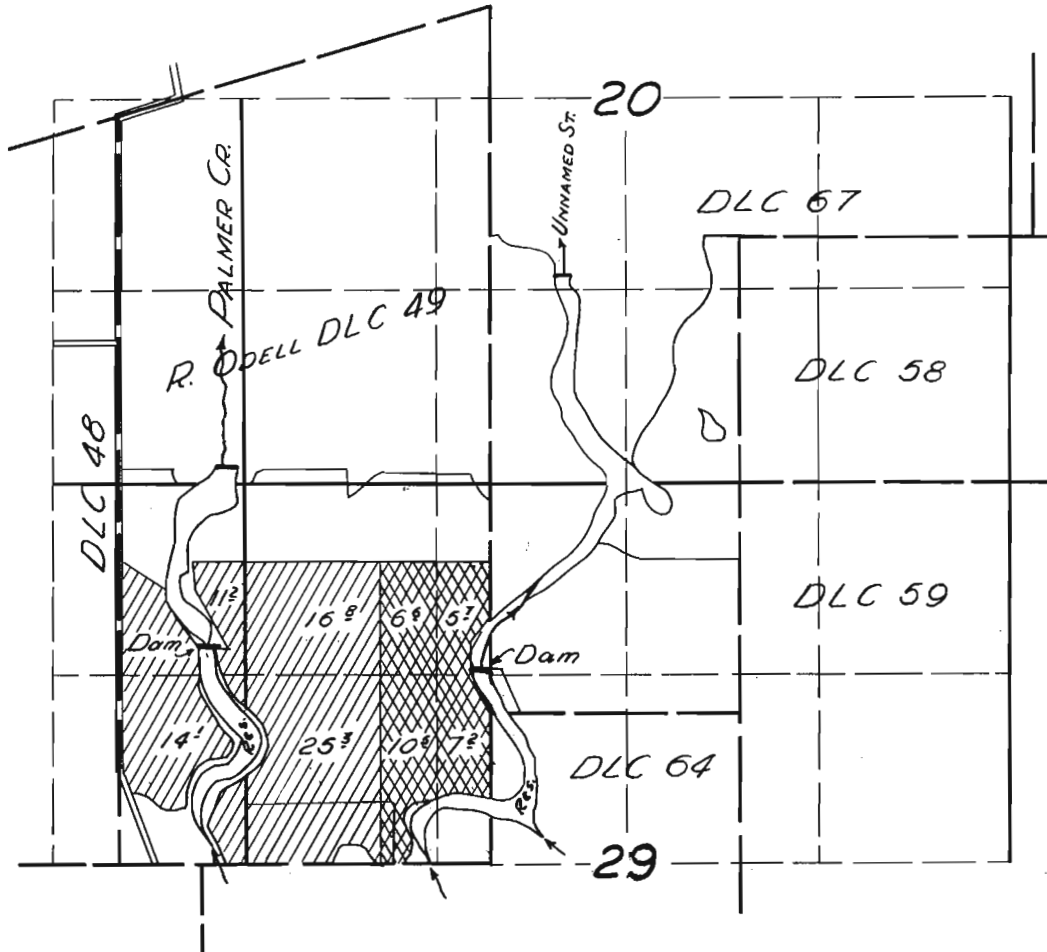

FINAL PROOF SURVEY

23304
R-23303
26647

18438
R-952
21014



Application No. R-26380 Permit No. R-1308

IN NAME OF

VICTORIA CAMPBELL

Surveyed 26 Mar 1956, by [Signature]