



MAP TO ACCOMPANY TRANSFER APPLICATION

TRANSFER NO. _____

ORIGINAL CONFIGURATION PER PERMIT # G-10099
 LOCATED IN SECTION 6
 TOWNSHIP 26 SOUTH, RANGE 16 EAST, W.M.
 LAKE COUNTY, OREGON


FINAL CONFIGURATION AFTER TRANSFER
 LOCATED IN SECTION 6
 TOWNSHIP 26 SOUTH, RANGE 16 EAST, W.M.
 LAKE COUNTY, OREGON

LOCATED IN SECTION 3
 TOWNSHIP 26 SOUTH, RANGE 16 EAST, W.M.
 LAKE COUNTY, OREGON

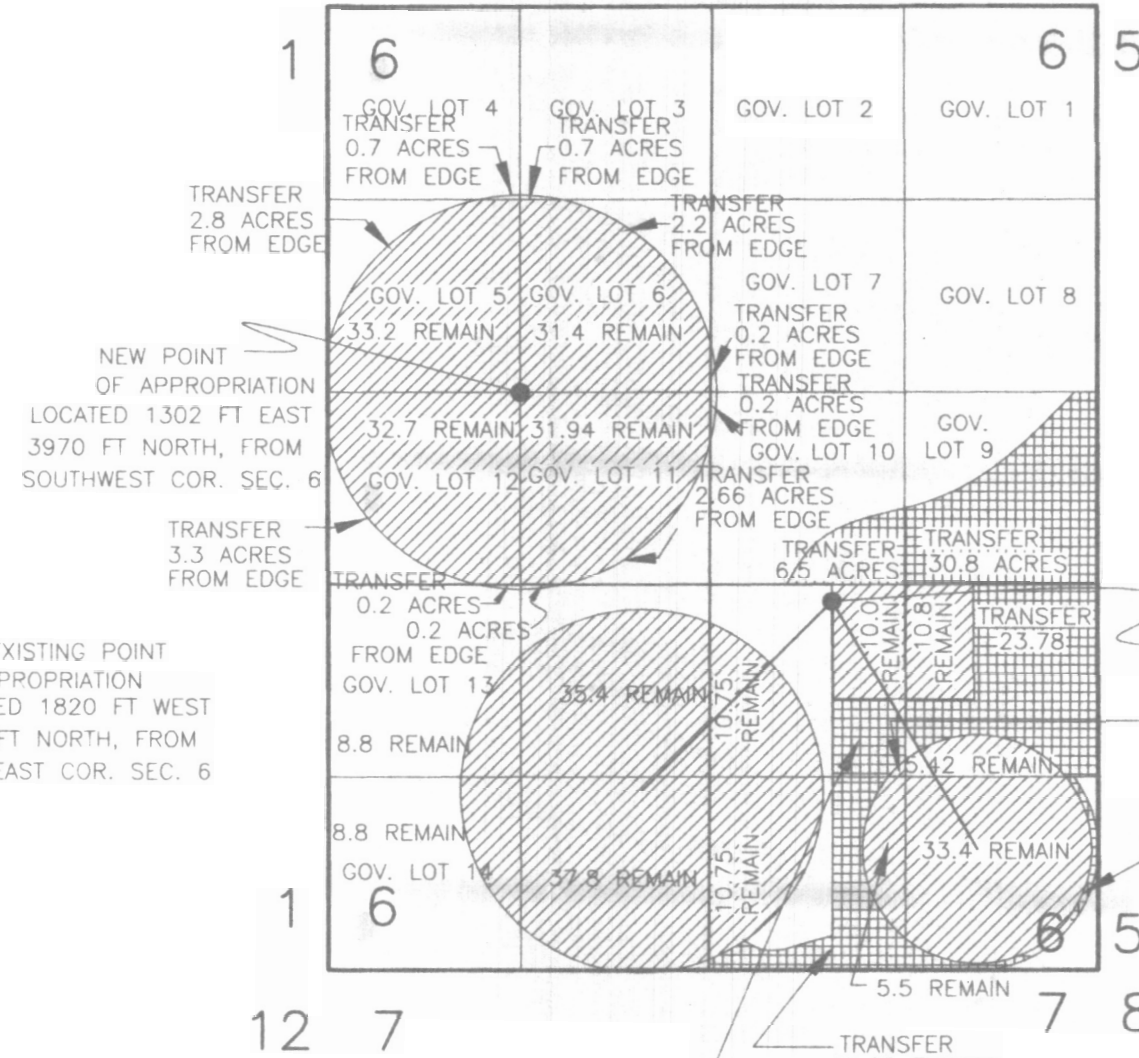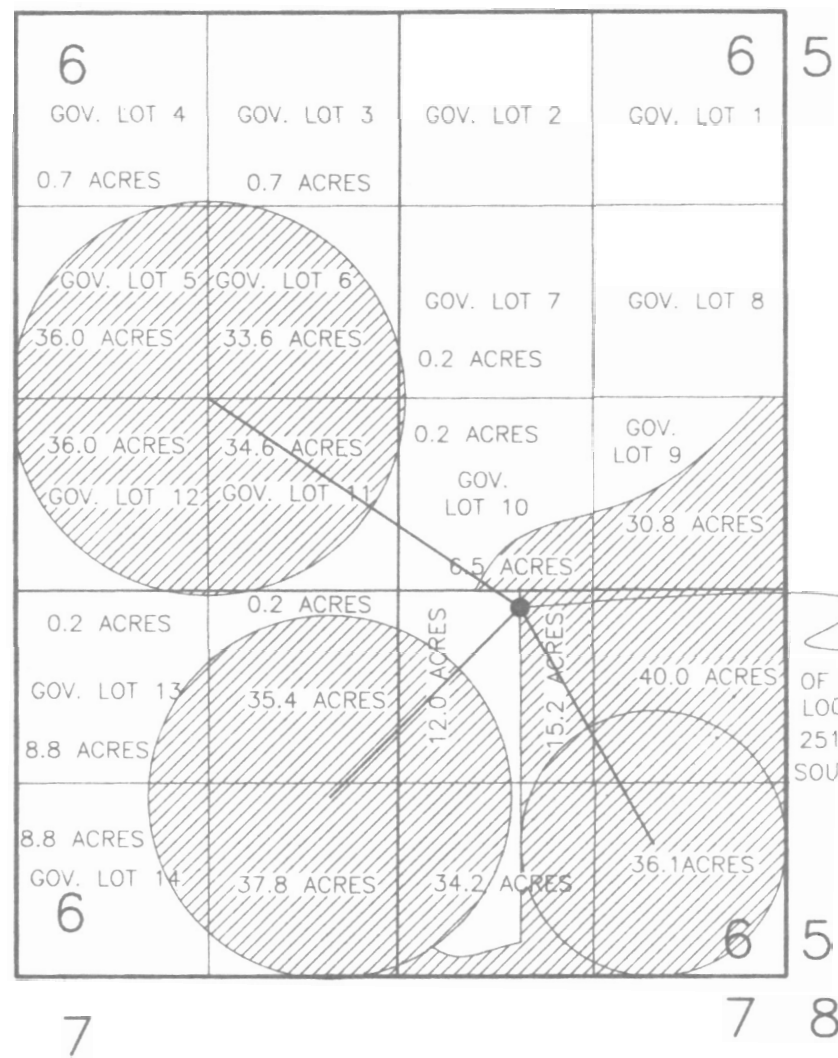

NOTE:
 THE FINAL PROOF FOR TRANSFER T-6864 IS IN PROGRESS

○ ACRES AVAILABLE PER: CERTIFICATE NO. 53457
 □ ACRES TO REMAIN IN PLACE AFTER TRANSFER
 ⬡ ACRES AVAILABLE PER: COMPLETED FINAL PROOF OF TRANSFER T-6864

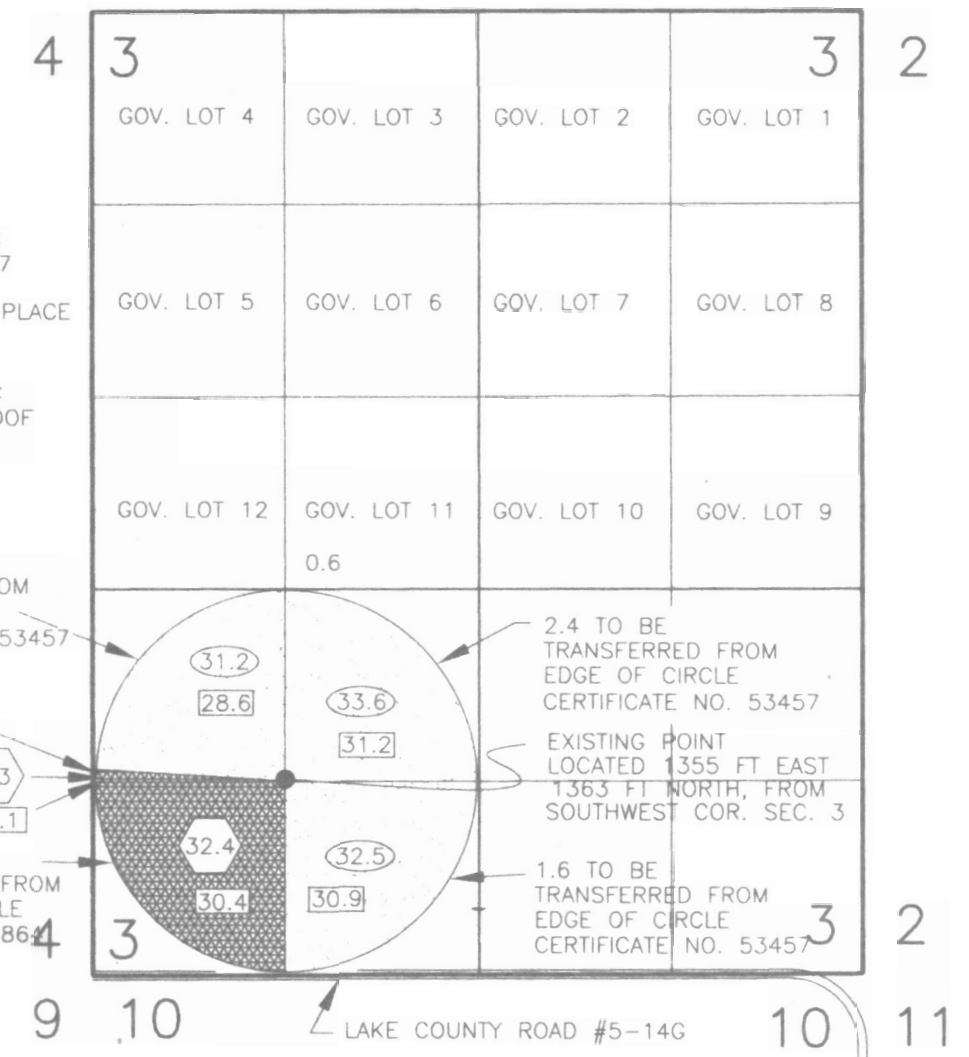

NOTE:
 THIS APPLICATION INCLUDES CHANGE IN POINT OF DIVERSION FOR THIS PORTION OF PERMIT G-10099

101.24 ACRES FROM PERMIT NO. G-10099 TO BE TRANSFERRED AS SHOWN.
 306.76 ACRES FROM PERMIT NO. G-10099 TO REMAIN IN PLACE AS SHOWN.

ALL AREAS SHOWN IN THIS BOX REFER TO EXISTING TRANSFERS TO AREAS IN SECTION 12 TOWNSHIP 27 SOUTH RANGE 16 EAST WILLAMETTE MERIDIAN LAKE COUNTY, OREGON

NOTE: AS PER T-7372 ROTH


22.4 ACRES FROM PERMIT NO. G-9075 TO BE TRANSFERRED TO THIS LOCATION. FROM CERTIFICATE NO. 53233
 6.0 ACRES FROM PERMIT NO. G-9076 TO BE TRANSFERRED TO THIS LOCATION. FROM CERTIFICATE NO. 53234

NOTE: AS PER T-7972 ADAMS

8.4 ACRES FROM CERTIFICATE NO. 37388 TO BE TRANSFERRED TO THIS LOCATION.
 16.7 ACRES FROM CERTIFICATE NO. 46881 TO BE TRANSFERRED TO THIS LOCATION.
 12.1 ACRES FROM CERTIFICATE NO. 52641 TO BE TRANSFERRED TO THIS LOCATION.
 7.7 ACRES FROM CERTIFICATE NO. 54690 TO BE TRANSFERRED TO THIS LOCATION.

NOTE: AS PER T-8013 NOFZIGER

39.0 ACRES FROM PERMIT NO. G-21 TO BE TRANSFERRED TO THIS LOCATION FROM CERTIFICATE NO. 31072
 8.67 ACRES FROM PERMIT NO. 9125 TO BE TRANSFERRED TO THIS LOCATION FROM CERTIFICATE NO. 53457
 7.47 ACRES FROM PERMIT NO. G-8 TO BE TRANSFERRED TO THIS LOCATION FROM CERTIFICATE NO. 52876

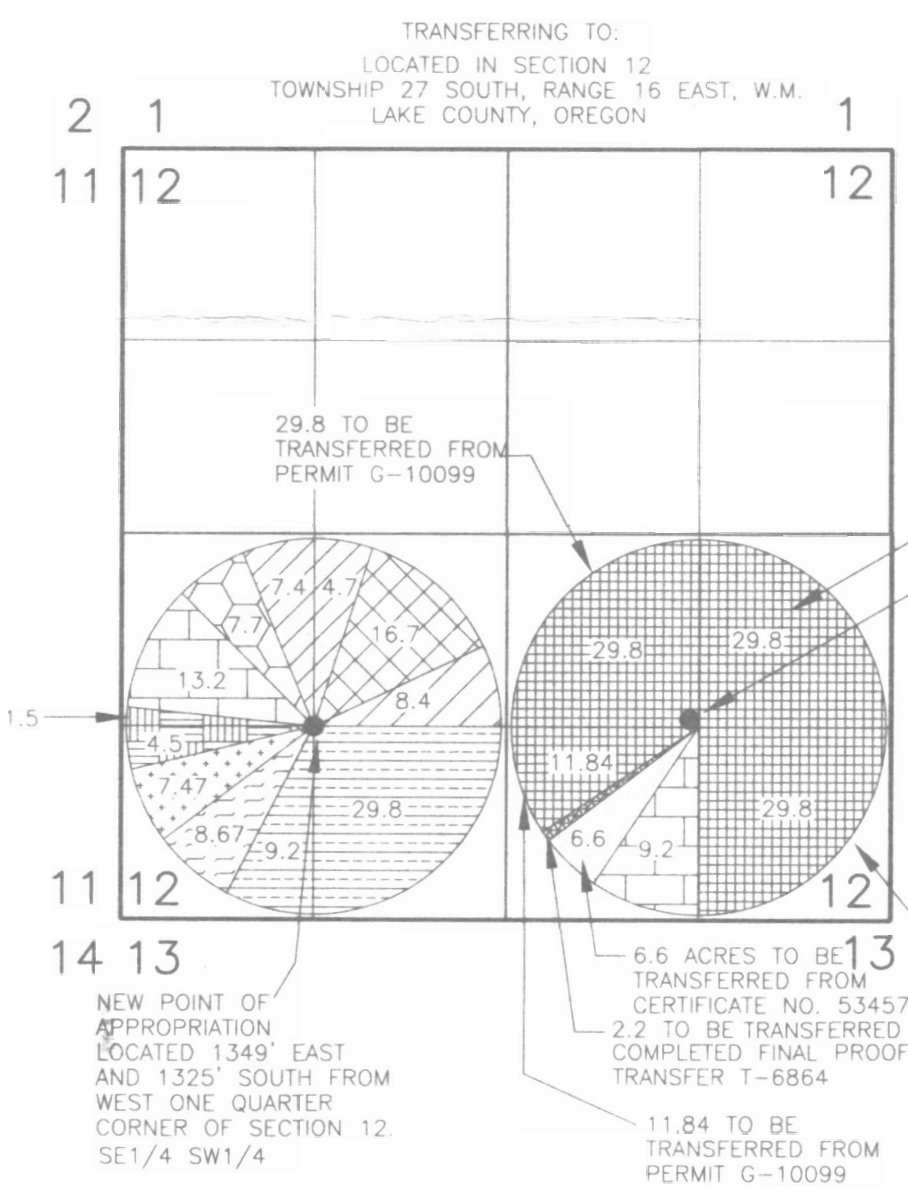


29.8 TO BE TRANSFERRED FROM PERMIT G-10099
 NEW POINT OF APPROPRIATION LOCATED 1374' WEST AND 1382' NORTH FROM SE CORNER OF SECTION 12, NW1/4 SE1/4
 29.8 TO BE TRANSFERRED FROM PERMIT G-10099

AS PER THIS APPLICATION

2.2 TO BE TRANSFERRED FROM COMPLETED FINAL PROOF OF: TRANSFER T-6864
 101.24 ACRES FROM PERMIT NO. G-10099 TO BE TRANSFERRED TO THIS LOCATION. AS SHOWN
 6.6 ACRES TO BE TRANSFERRED FROM CERTIFICATE NO. 53457

LEGEND

SECTION LINE
 1/4 SECTION LINE
 1/16 SECTION LINE
 ● EXISTING WELL

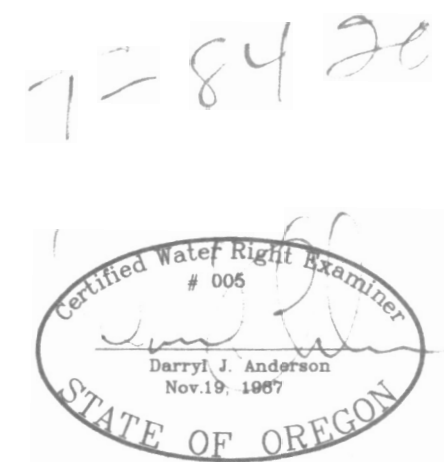

PREPARED FOR:
CHARLES NOFZIGER
 PO BOX 36
 CHRISTMAS VALLEY, OR 97641

PREPARED BY:
ANDERSON ENGINEERING & SURVEYING,
 P.O. BOX 28 LAKEVIEW, OREGON 97630
 P.O. BOX 419 REDMOND, OREGON 977
 (541) 947-4407 (541) 923-4307
 FAX 947-2321 FAX 923-4308

MAP TO ACCOMPANY TRANSFER APPLICATION

TRANSFER NO. 8420


REVISION: FEB. 12, 2008

EXISTING CONFIGURATION PER CERTIFICATE #82391
LOCATED IN SECTION 6
TOWNSHIP 26 SOUTH, RANGE 16 EAST, W.M.
LAKE COUNTY, OREGON


FINAL CONFIGURATION AFTER TRANSFER
LOCATED IN SECTION 6
TOWNSHIP 26 SOUTH, RANGE 16 EAST, W.M.
LAKE COUNTY, OREGON

EXISTING CONFIGURATION
LOCATED IN SECTION 3
TOWNSHIP 26 SOUTH,
RANGE 16 EAST W.M.
LAKE COUNTY, OREGON


FINAL CONFIGURATION
LOCATED IN SECTION 3
TOWNSHIP 26 SOUTH,
RANGE 16 EAST W.M.
LAKE COUNTY, OREGON

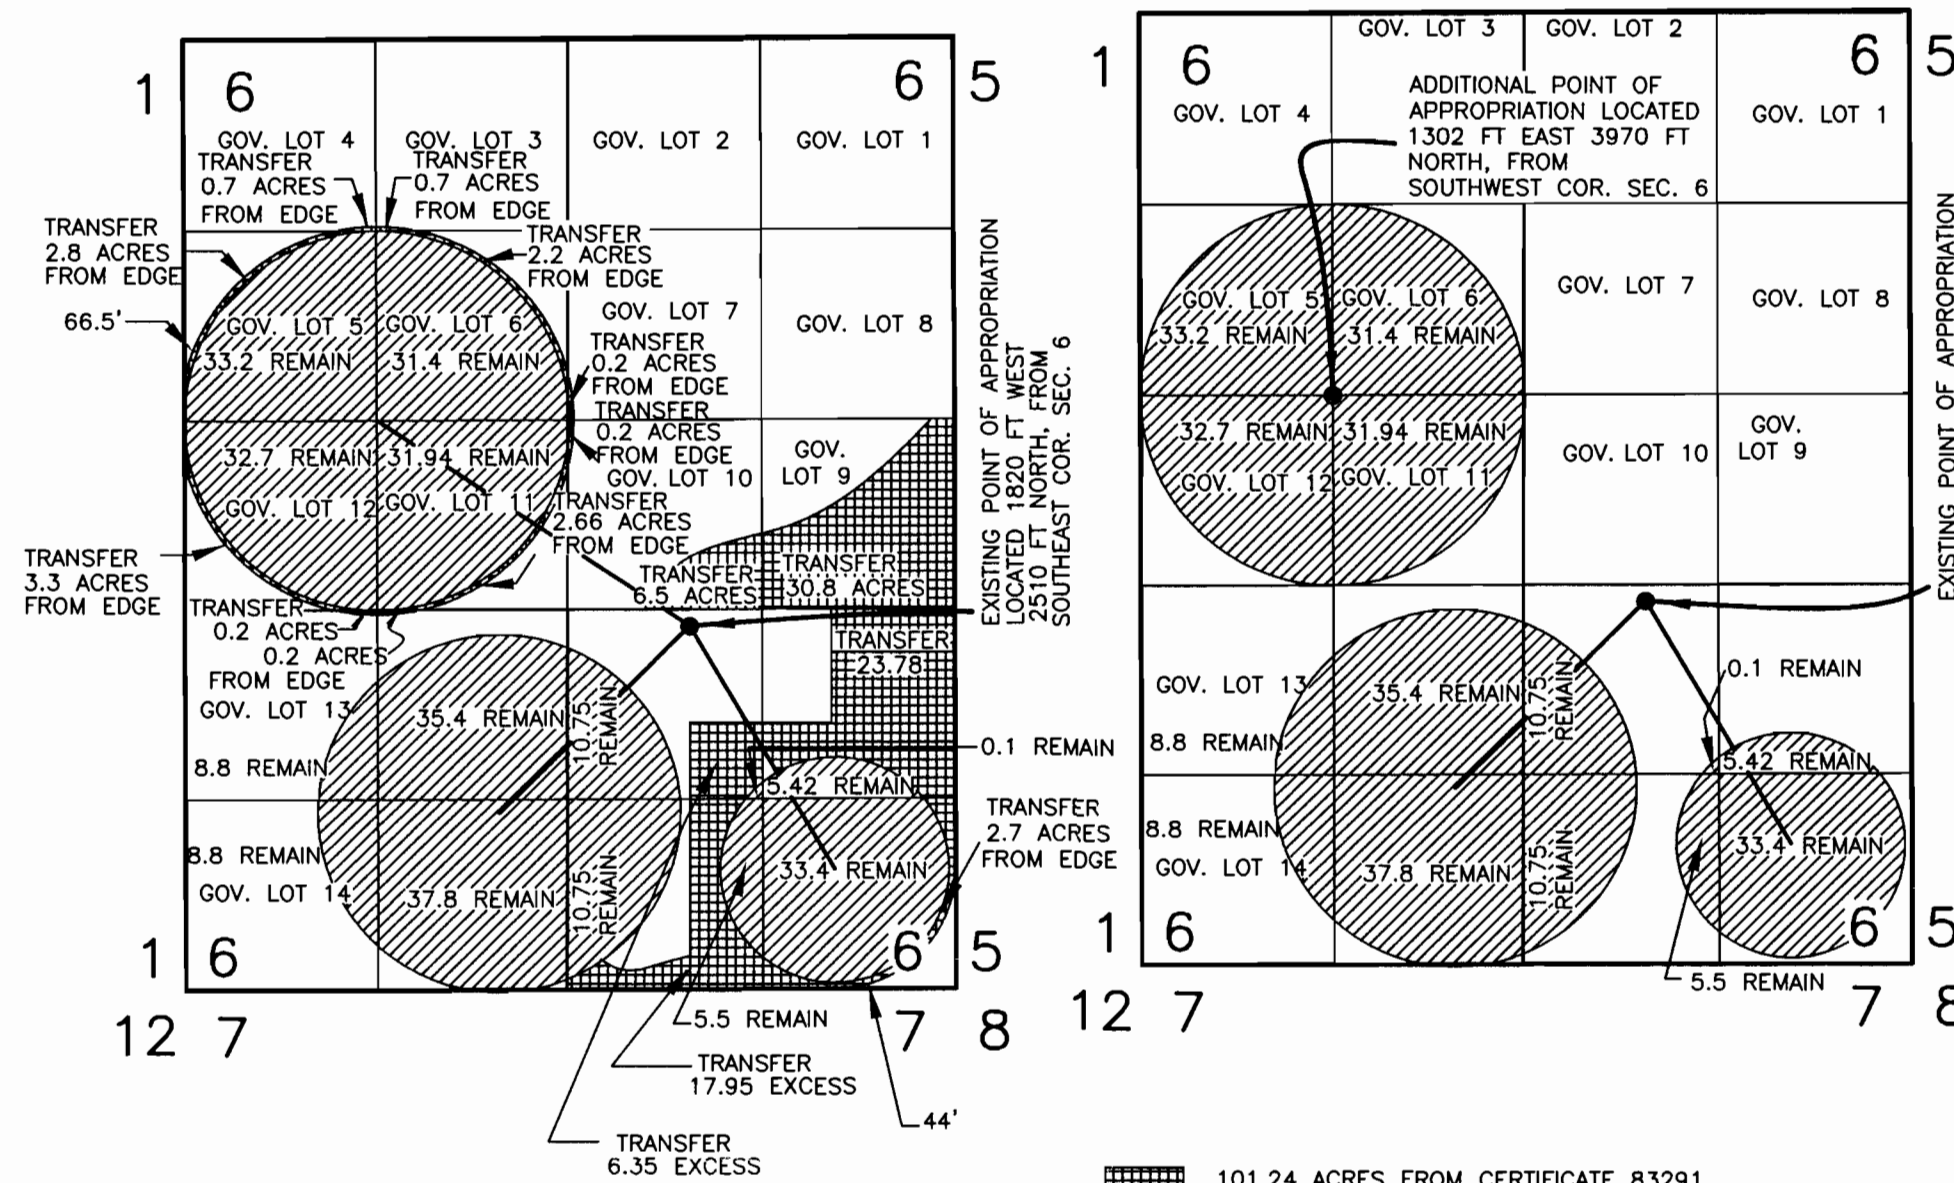


- 101.24 ACRES FROM CERTIFICATE 83291 TO BE TRANSFERRED AS SHOWN.
- 285.96 ACRES FROM CERTIFICATE 83291 TO REMAIN IN PLACE AS SHOWN.

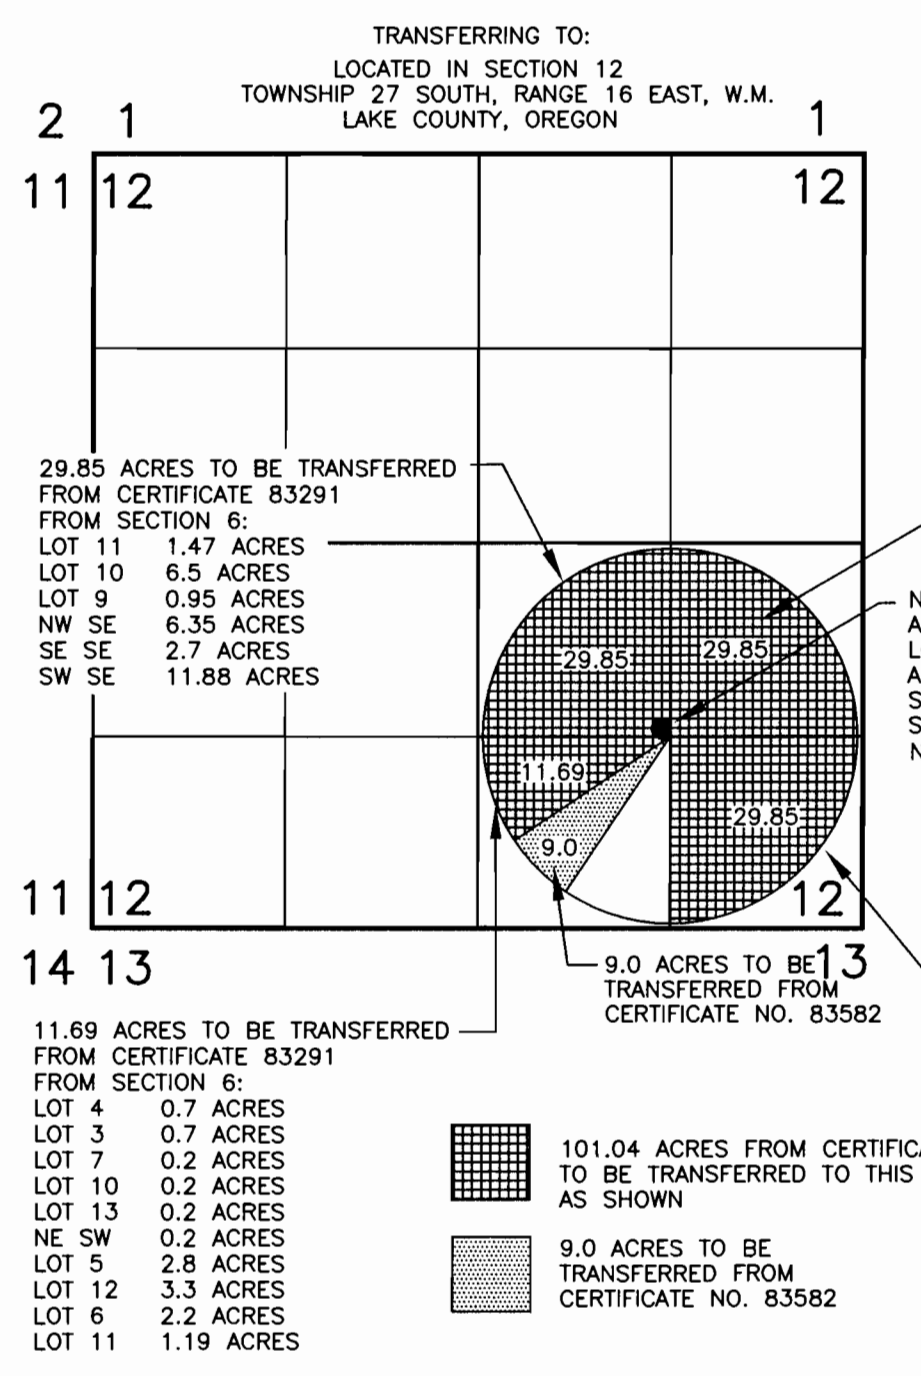

- 101.04 ACRES FROM CERTIFICATE 83291 TO BE TRANSFERRED TO THIS LOCATION AS SHOWN
- 9.0 ACRES TO BE TRANSFERRED FROM CERTIFICATE NO. 83582

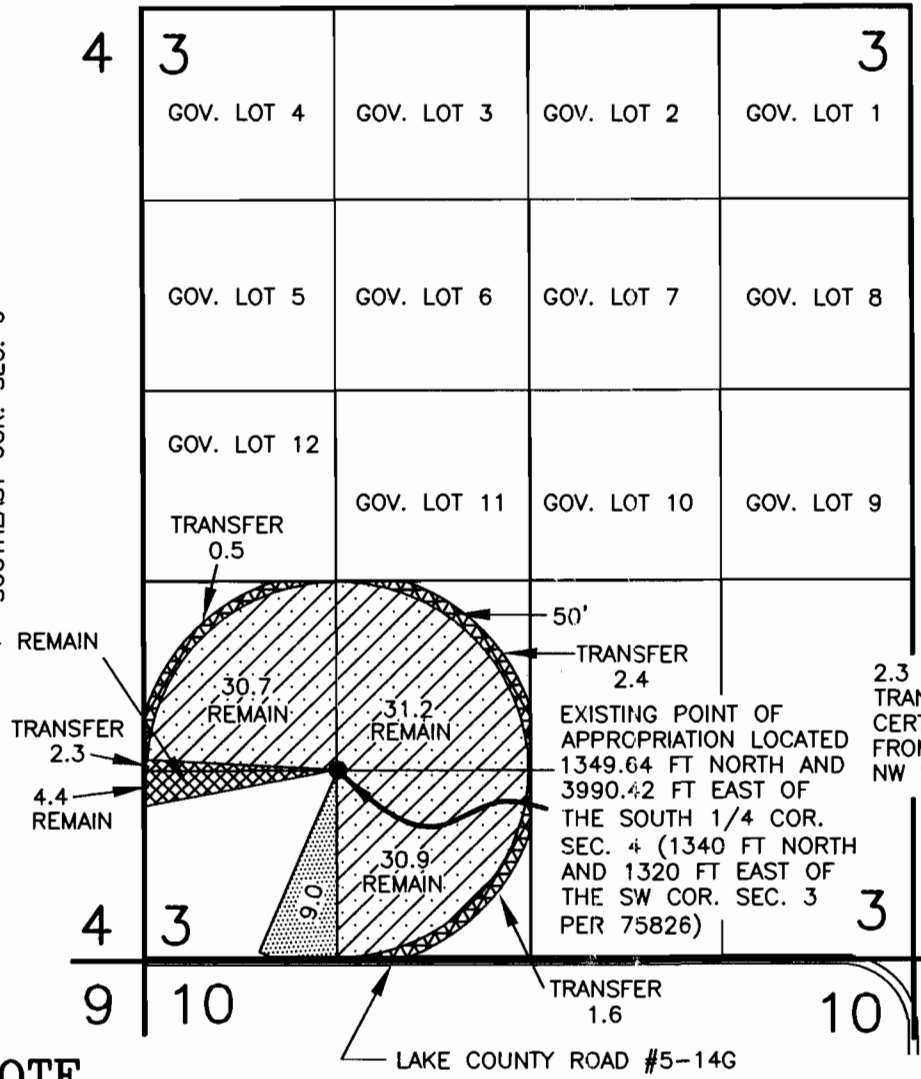

NOTE
0.5 ACRES FROM THE NW 1/4 SW 1/4, 2.4 ACRES FROM THE NE 1/4 SW 1/4, AND 1.6 ACRES FROM THE SE 1/4 SW 1/4 IN SECTION 3 FROM CERTIFICATE NO. 75826 ARE TO BE TRANSFERRED TO THE SW 1/4 SW 1/4 OF SECTION 3 AS SHOWN.
2.3 ACRES FROM CERTIFICATE NO. 83581 IN THE NW 1/4 SW 1/4 OF SECTION 3 ARE TO BE TRANSFERRED TO THE SW 1/4 SW 1/4 OF THE SOUTHWEST 1/4 OF SECTION 3 AS SHOWN.
ALL 9.0 ACRES FROM CERTIFICATE NO. 83582 IN THE SW 1/4 SW 1/4 OF SECTION 3 ARE TO BE TRANSFERRED TO THE SW 1/4 SE 1/4 OF SECTION 12 AS SHOWN.

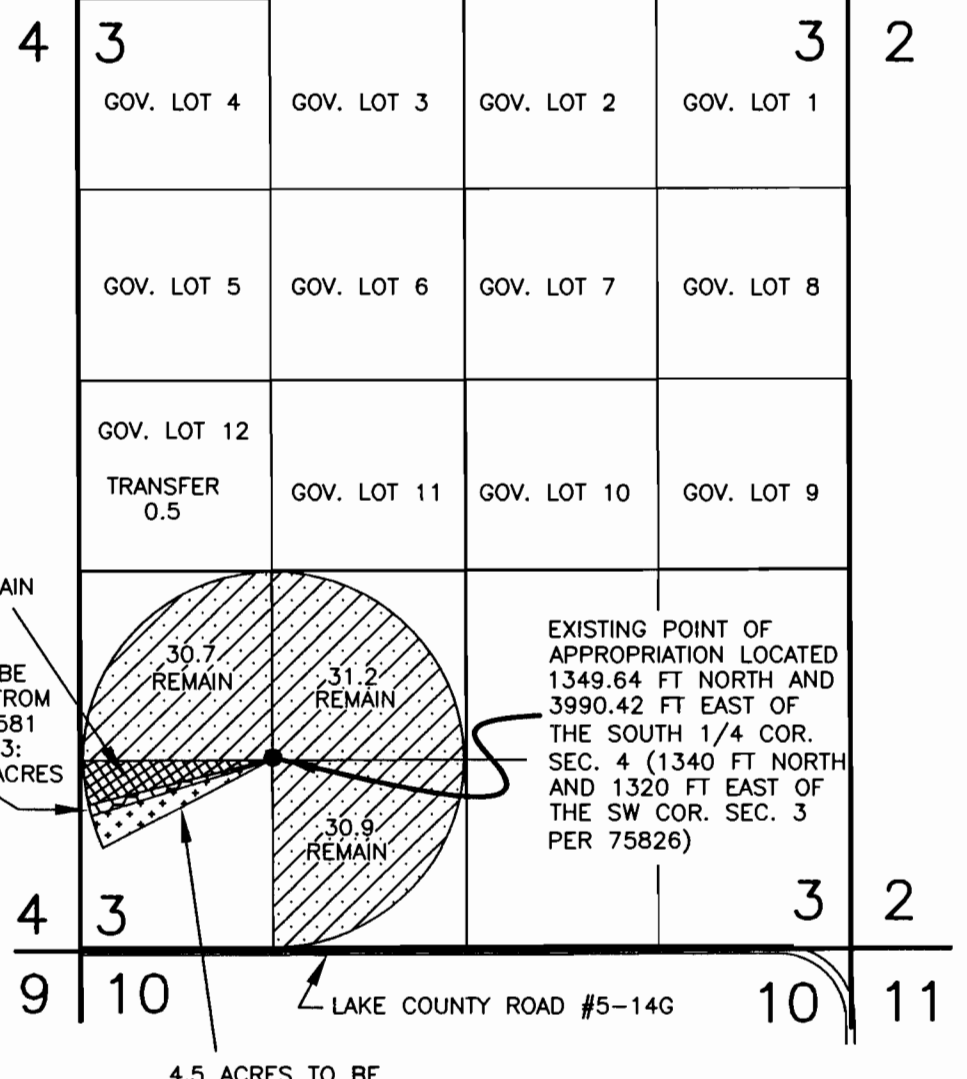

- 4.5 ACRES TO BE TRANSFERRED FROM CERTIFICATE 83583 FROM SECTION 3: NW SW 0.5 ACRES, NE SW 2.4 ACRES, SE SW 1.6 ACRES
- AS PER CERTIFICATE NO. 75826 TO BE TRANSFERRED - 4.5 ACRES
- AS PER CERTIFICATE NO. 75826
- AS PER CERTIFICATE NO. 83581
- AS PER CERTIFICATE NO. 83582 TO BE TRANSFERRED - 9.0 ACRES
- AREA TRANSFERRED FROM CERTIFICATE 75826 - 4.5 ACRES
- AREA TRANSFERRED FROM CERTIFICATE 83581 - 2.3 ACRES

- LEGEND**
- SECTION LINE
 - 1/4 SECTION LINE
 - 1/16 SECTION LINE
 - EXISTING WELL



RECEIVED

FEB 26 2008
WATER RESOURCES DEPT
SALEM OREGON

SCALE: 1"=1320'

PREPARED FOR:
CHARLES NOFZIGER
PO BOX 36
CHRISTMAS VALLEY, OR 97641

PREPARED BY:
ANDERSON ENGINEERING & SURVEYING, INC.
P.O. BOX 28
LAKEVIEW, OREGON 97630
(541) 947-4407
FAX 947-2321

DATE: MARCH 2000 DWG. FILE: T-8420
JOB NO.: 2000-024 SHEET 1 OF 1

NOTE: PREPARATION OF THIS MAP IS FOR IDENTIFYING PROPOSED WATER RIGHTS ONLY. IT HAS NO INTENT TO PROVIDE LOCATIONS OR DIMENSIONS OF PROPERTY BOUNDARIES..