


T13S R26E

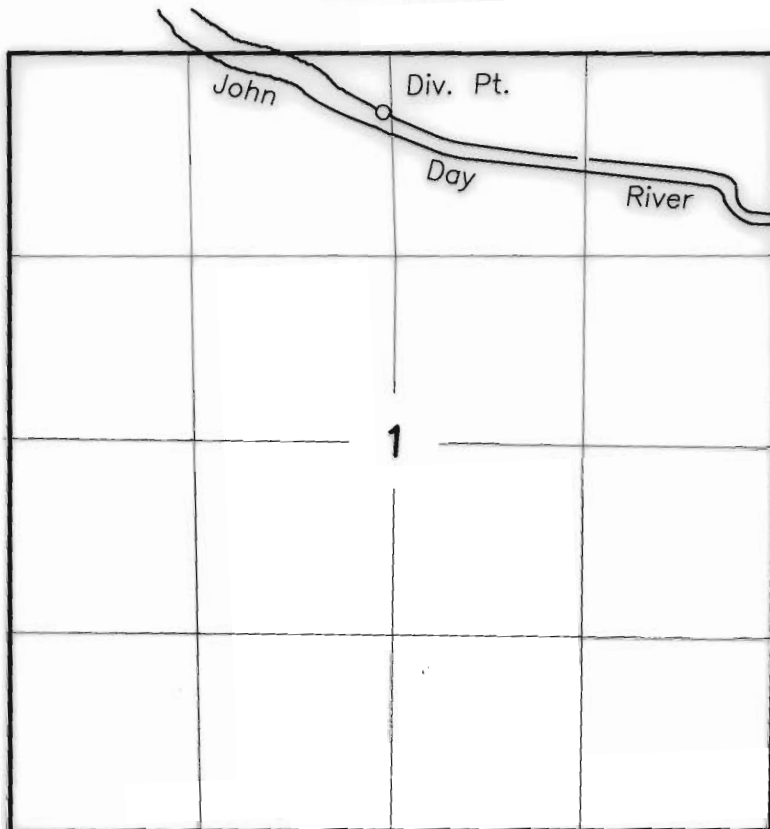

Scale 1" = 1320'

Point of Diversion
400 ft. South and 50 ft. West
of the N1/4 corner of Sec. 1

FINAL PROOF SURVEY

UNDER
Transfer T-8832

IN NAME OF
Jerald and Barbara Clausen
and
Larry and Danielle Slaughter

Surveyed February 23, 2001



RECEIVED
OCT 03 2005
WATER RESOURCES DEPT
SALEM, OREGON