


T.14S.R.15E.W.M.

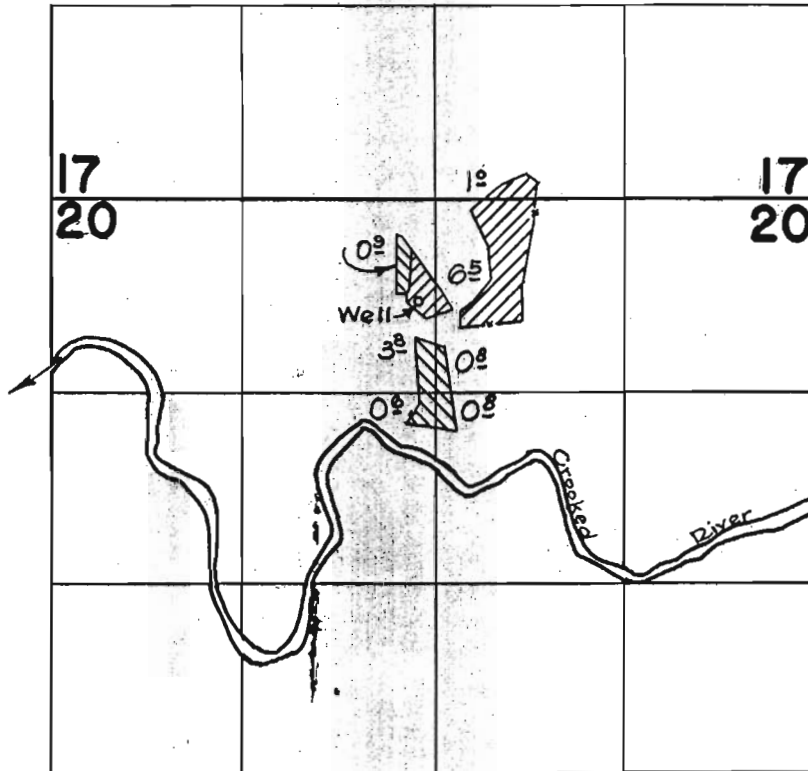

 Primary
 Supplemental

FINAL PROOF SURVEY
UNDER

Application No. G-1239 Permit No. G-1119
IN NAME OF

ROBERT LISTER

Surveyed Nov. 2 1962 by C. R. BAKER
July 8 1963 by T. LAUER