
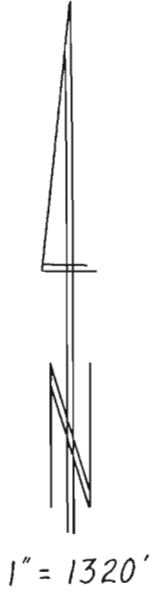


T 8 S R I W W M

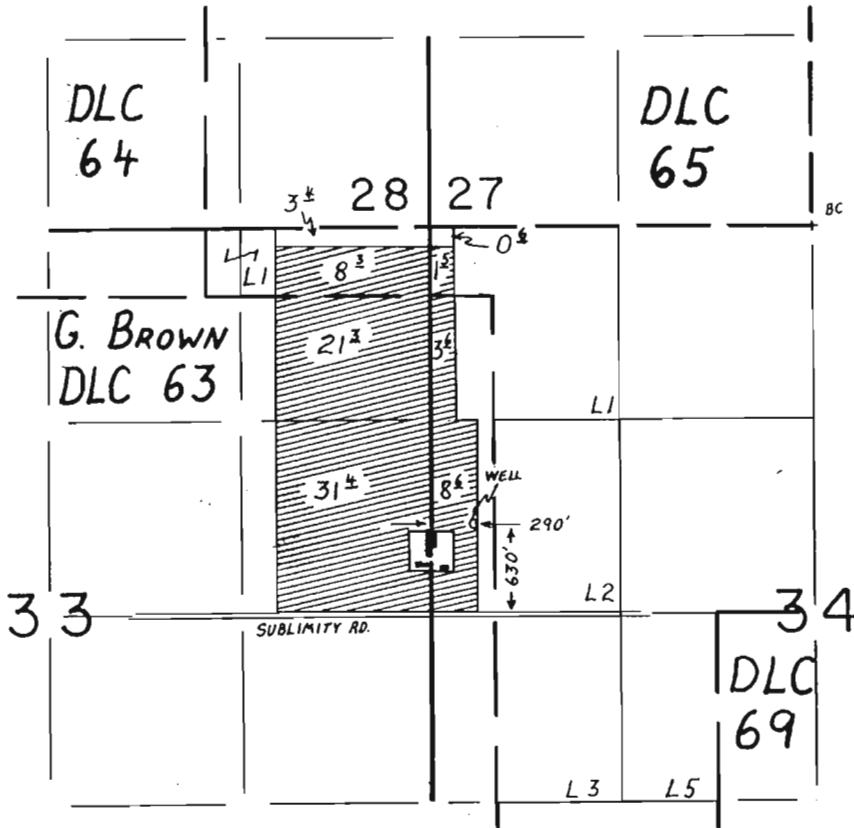

FINAL PROOF SURVEY
UNDER

Application No. G-11650. Permit No. G-10726.

IN NAME OF

.....LAWRENCE A. FRANK.....

Surveyed FEB. 20. 19.91., by H. KEMP.....