

# FINAL PROOF SURVEY MAP

T 10 S R 2 W, W.M. Section 9


prepared for: MILLER FORESTS, INC.

transfers: T-8845 & T-9922

**RECEIVED**

**DEC 08 2006**

**WATER RESOURCES DEPT  
SALEM, OREGON**

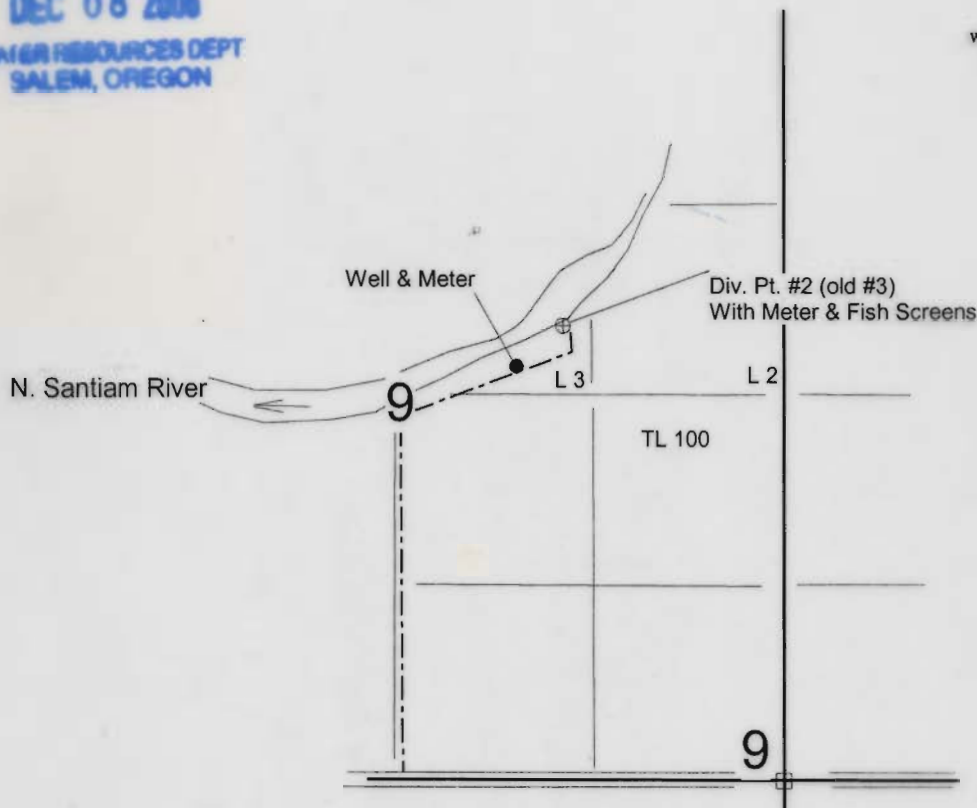

Div. Pt. #2 (old #3): 3150' N & 1540' W  
Well: 2750' N & 1760' W  
both from the SE corner Section 9

4" = 1 mile



This map is not intended to  
provide legal dimensions or  
locations of property ownership lines.



RENEWAL DATE: 6-30-2007