


Township 5 North, Range 29 East, W.M.
 NW 1/4 SW 1/4 of Section 31
 UMATILLA COUNTY

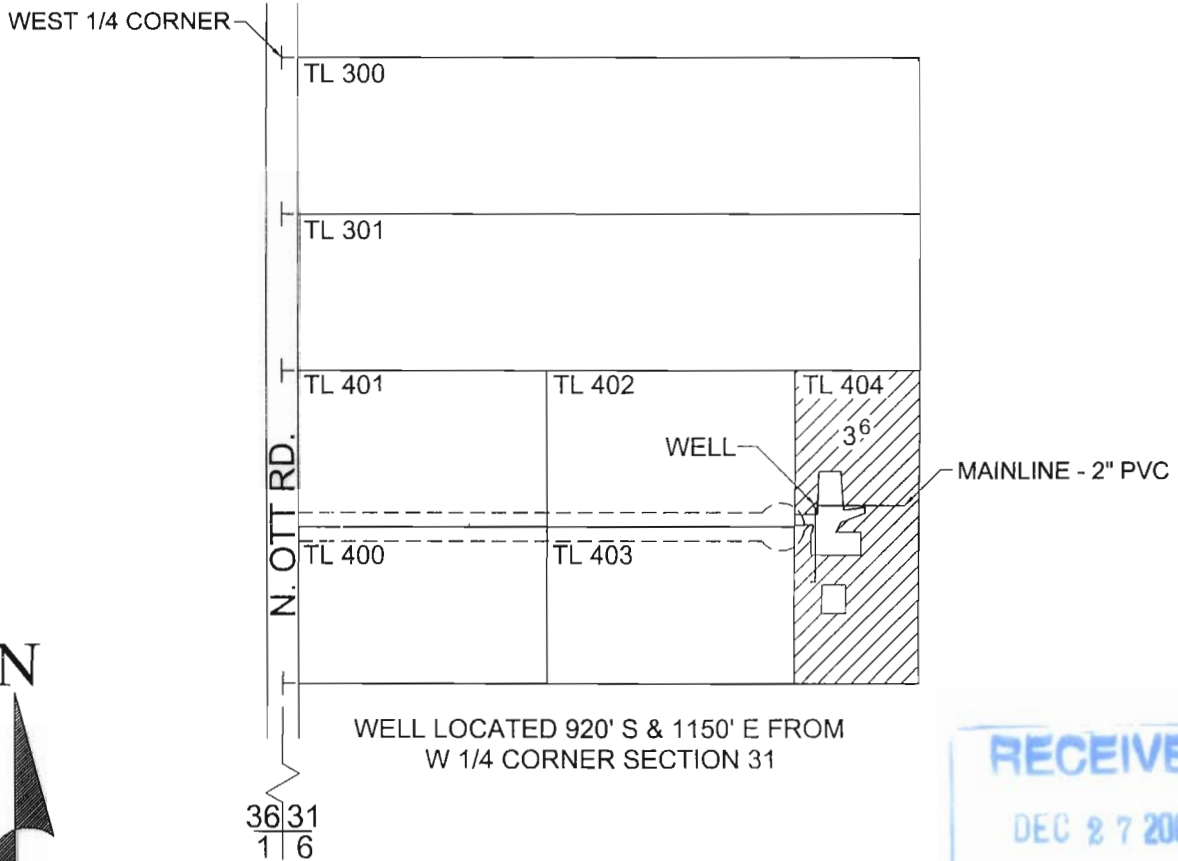

SCALE 1" = 400'



EXPIRES: 6/30/06

FINAL PROOF SURVEY
 under
 Transfer Application No. T-8848
 Permit No. G-7357
 in names of
 DENNIS E. AND KAREN A. BAKER
 October 8, 2004

THIS MAP WAS PREPARED FOR THE PURPOSE OF IDENTIFYING THE LOCATION OF A WATER RIGHT ONLY AND IS NOT INTENDED TO PROVIDE LEGAL DIMENSIONS OR LOCATION OF PROPERTY OWNERSHIP LINES.