




T6N, R35E, S36, WM
 T6N, R36E, S31, WM
 Umatilla County

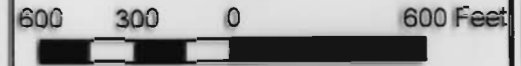


The purpose of this map is to identify the location of a water right. It is not intended to provide information regarding the location of property ownership boundary lines.

FOUNTAINHEAD
 1860 Blue Creek Road
 Walla Walla, WA 99362
 509.529.2646 phone



○ **Authorized POA**

Well is located in the SW/4 of SE/4, Section 36, T6N, R35E, WM, at a distance 650 feet N and 1675 feet W from SE Corner of Section 36. Well Log UMAT 6475. Flowmeter at same location.

 **Authorized POU**

Water beneficially used for supplemental irrigation of 49.2 acres of fruit orchards, including:

- 34.7 ac in NE/4 of SE/4, Section 36, T6N, R35E, WM
- 14.5 ac in SE/4 of SE/4, Section 36, T6N, R35E, WM

Water applied with solid-set sprinklers (Nelson R10).

----- **Conveyance**

Common buried PVC mainline conveys water from wells to Authorized POU and to/from temporary storage bulge. Predominantly 8-inch diameter pipe.

RECEIVED
 MAY 16 2008
 WATER RIGHTS DIVISION

**CLAIM OF BENEFICIAL USE MAP
 TRANSFER 8855**

in the name of
 SAM LEFORE, JR.

Revised 08 MAY 2008