

# TOWNSHIP 5 NORTH, RANGE 36 EAST, W.M.



CLAIM OF BENEFICIAL USE – FINAL PROOF MAP

WATER RIGHT TRANSFER T-8437

**RECEIVED**

MAY 20 2004

WATER RESOURCES DEPT  
SALEM, OREGON

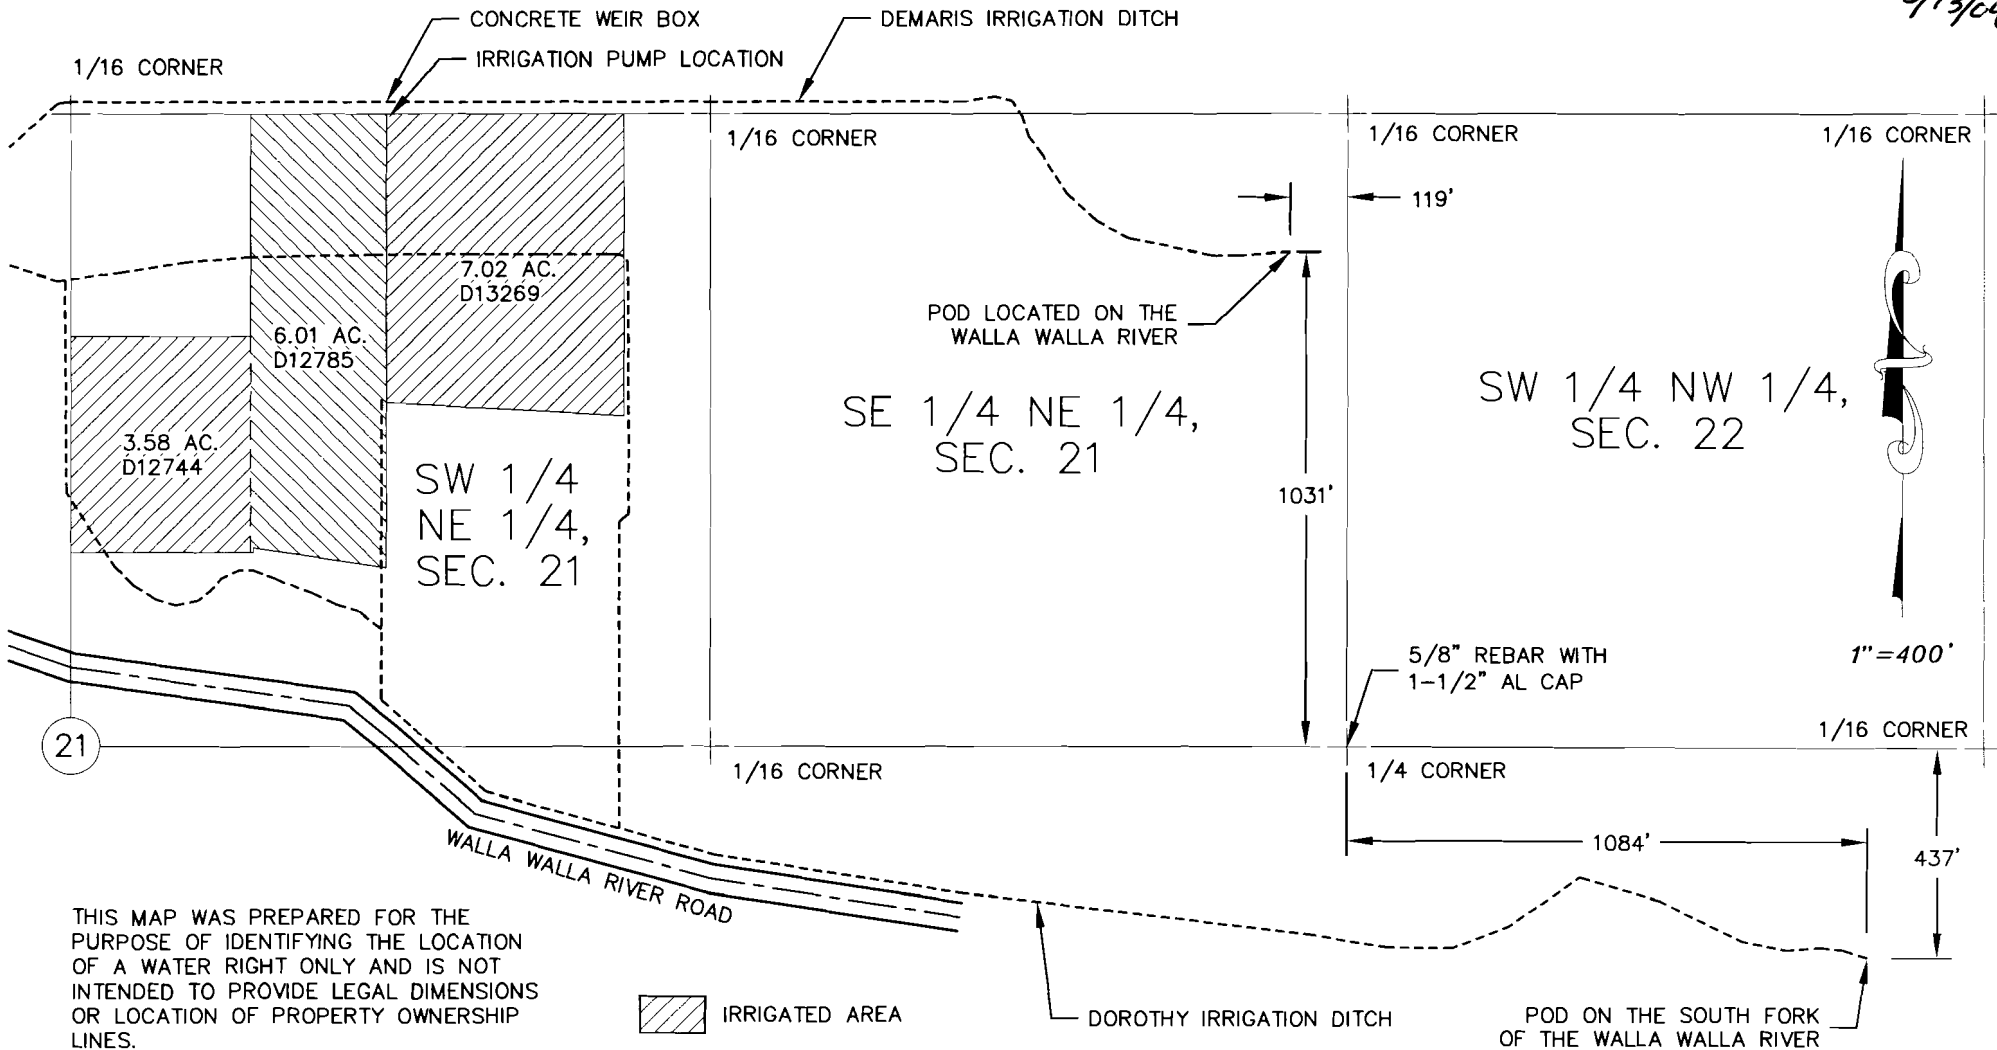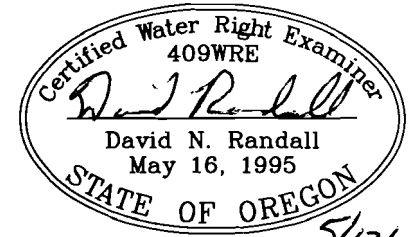

THIS MAP WAS PREPARED FOR THE PURPOSE OF IDENTIFYING THE LOCATION OF A WATER RIGHT ONLY AND IS NOT INTENDED TO PROVIDE LEGAL DIMENSIONS OR LOCATION OF PROPERTY OWNERSHIP LINES.