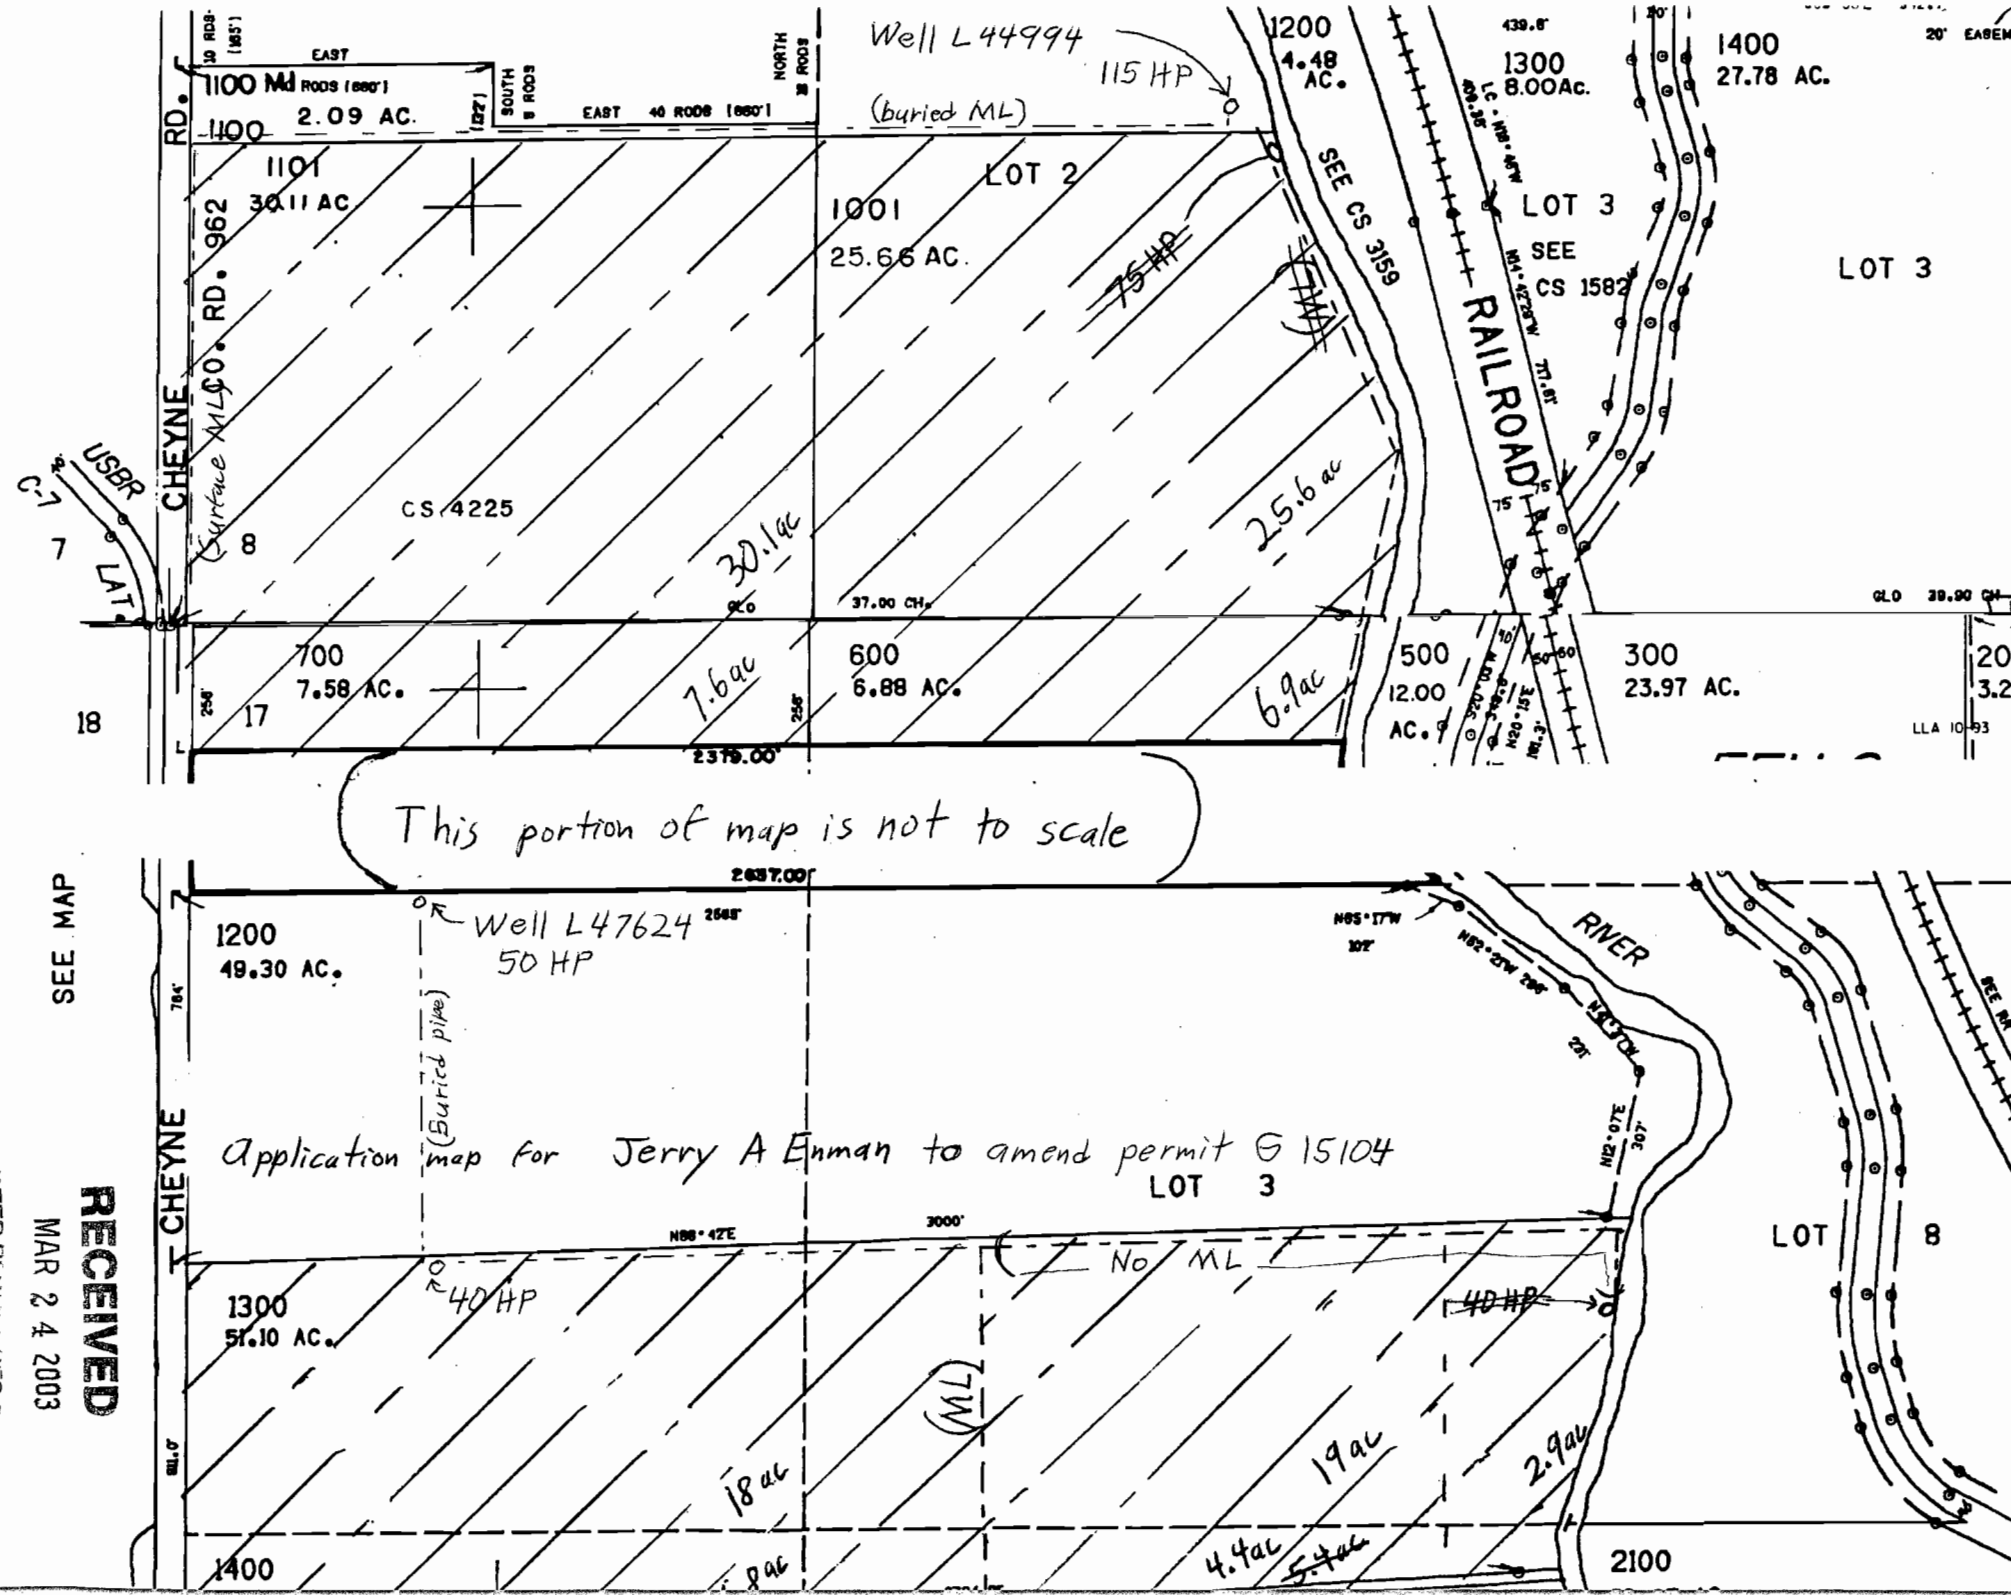

T9380

RECEIVED
MAR 24 2003
WATER RESOURCES DEPT.
SALEM, OREGON