

EXHIBIT B


DESCHUTES COUNTY
SEC. 4, T15S, R13 EWM

SCALE - 1" = 400'

N ↑

SW 1/4 OF THE NW 1/4

RECEIVED
MAY 01 2003
WATER RESOURCES DEPT
SALEM, OREGON

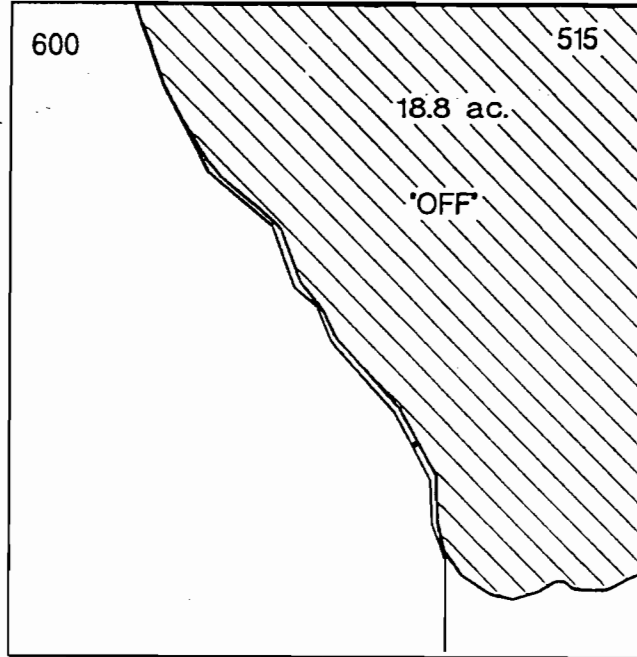

APPLICATION FOR WATER RIGHT TRANSFER

JEFF AND CAROL RANK / WM. SMITH PROPERTIES 18.8 ACRES



T9423