

THIS MAP WAS PREPARED FOR
ASSESSMENT PURPOSE ONLY

Section 28 T2N R10E WM

Hood River County

1" = 400'

2N 10


Cancelled No's.

400
4200
2902

RECEIVED

APR 18 2003

WATER RESOURCES DEPT.
SALEM, OREGON

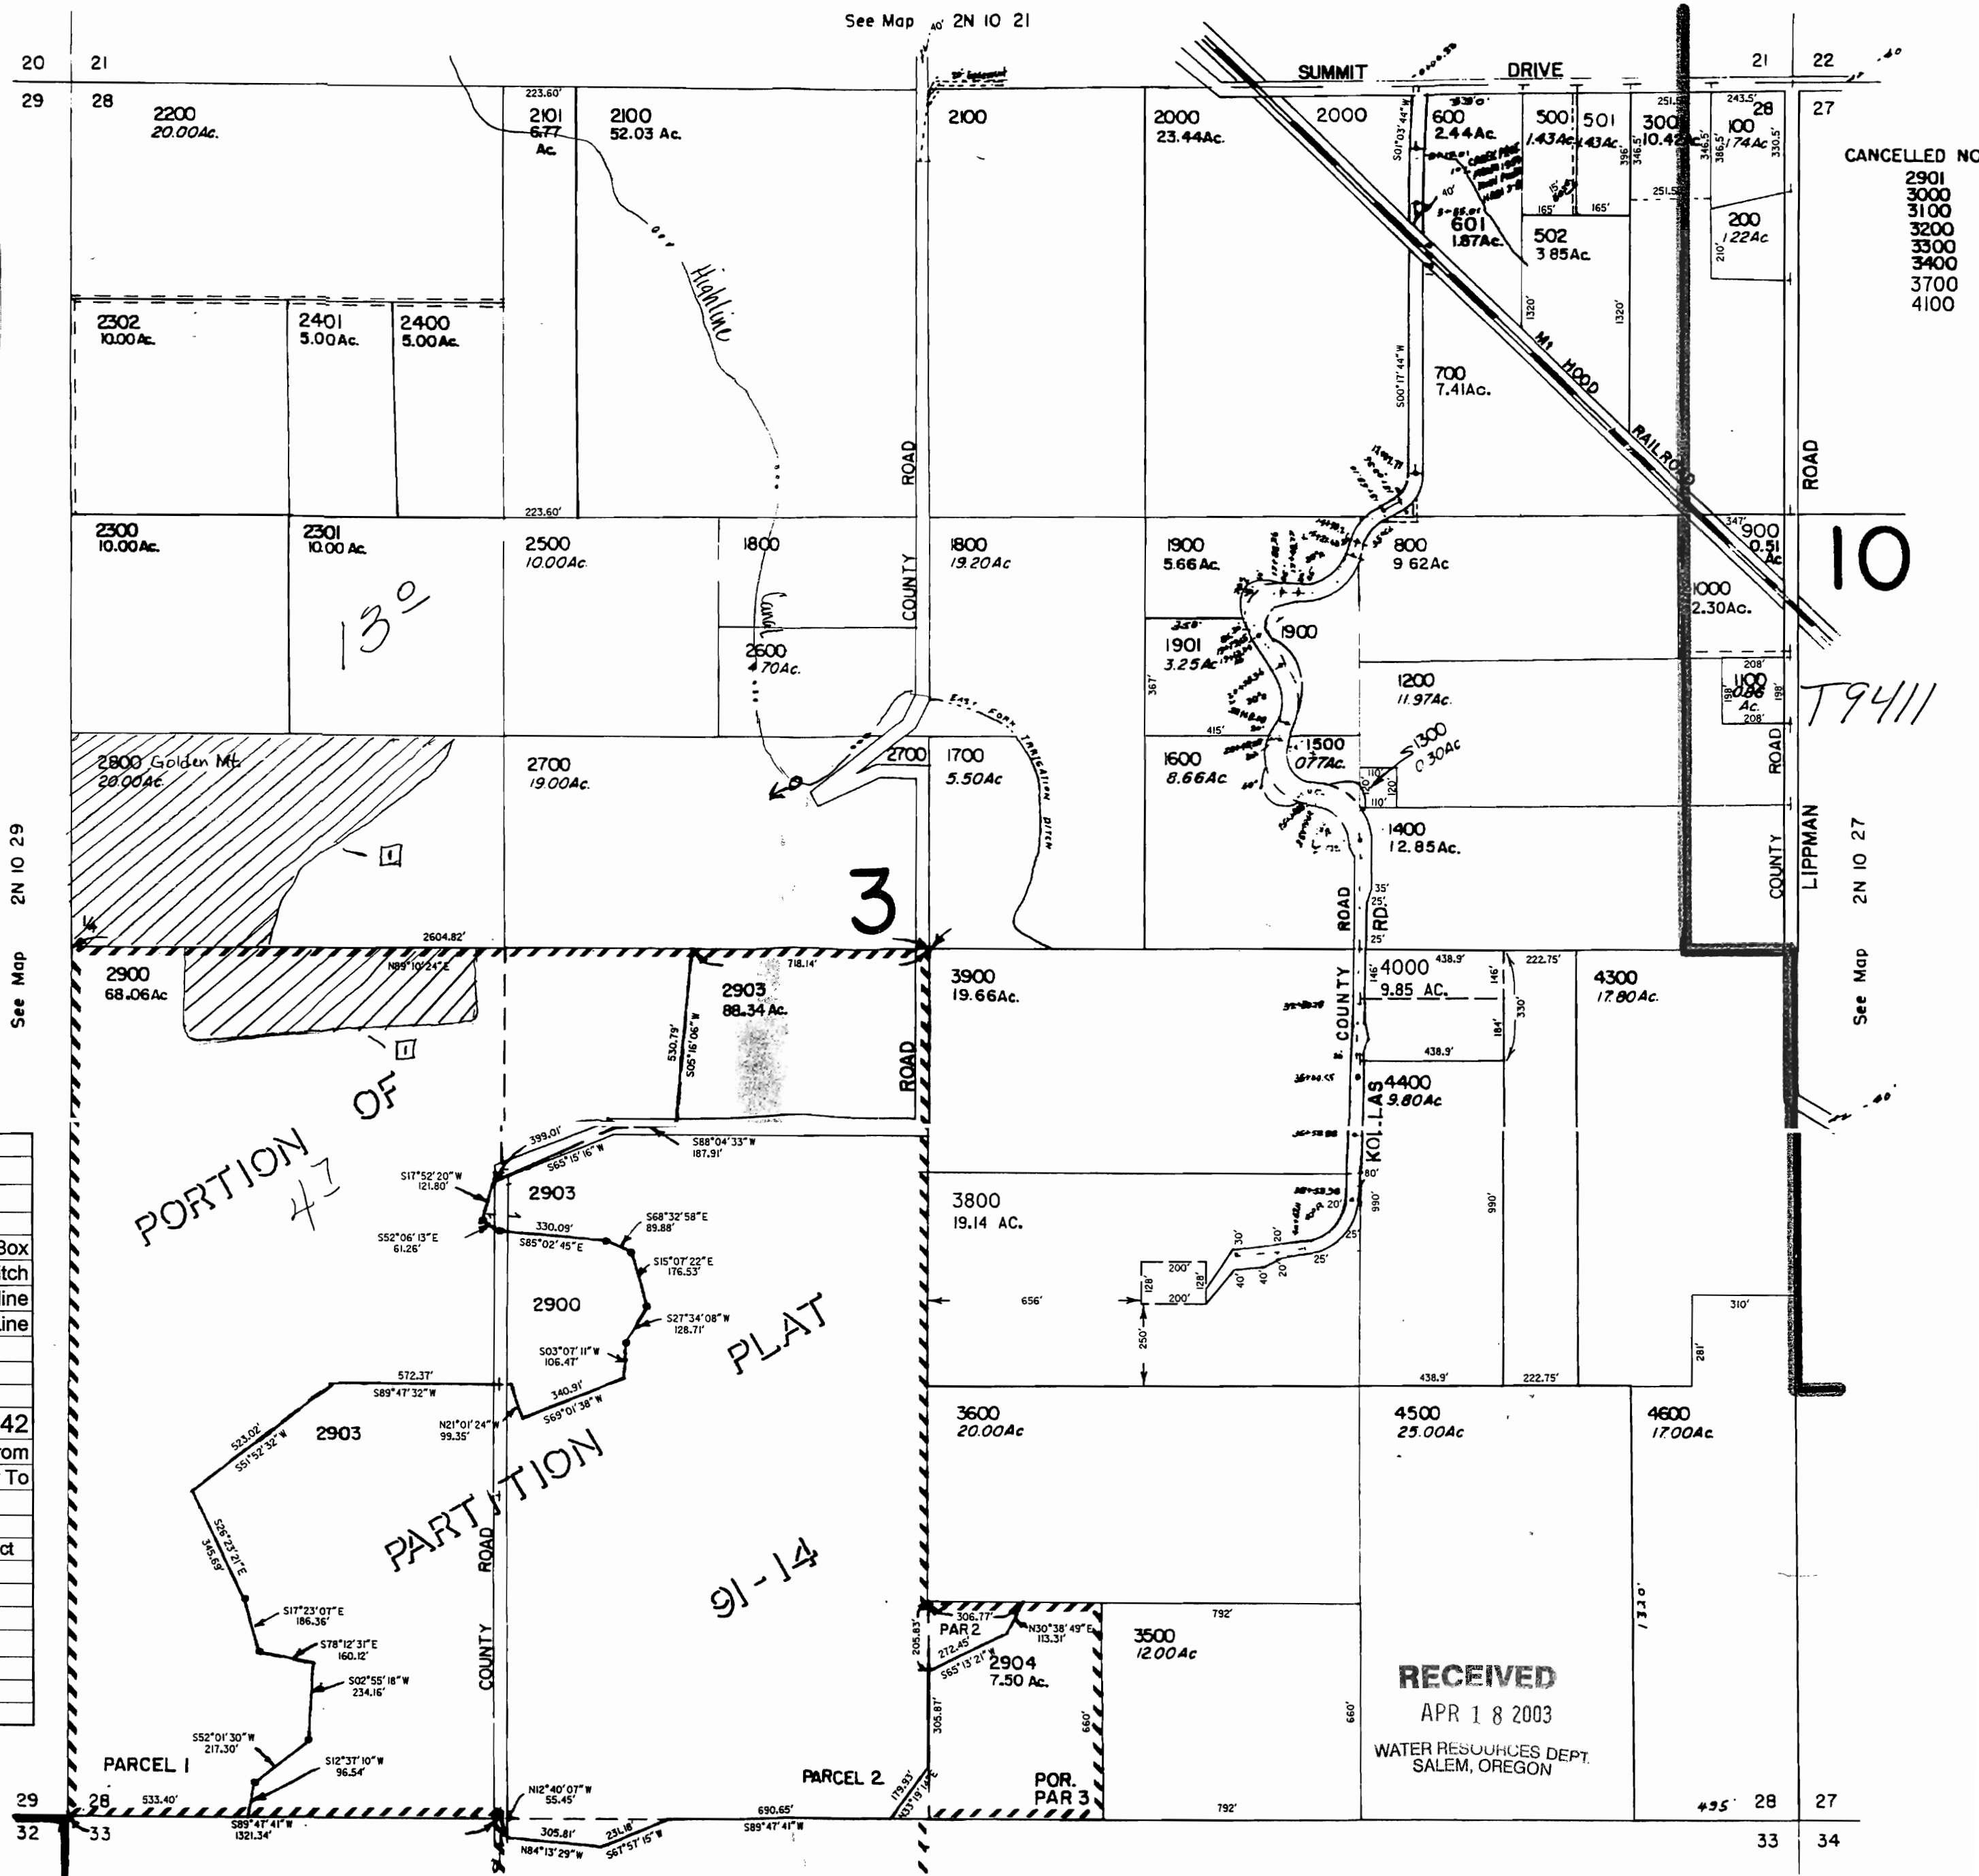

See Map 2N 10 29

CANCELLED NO'S
2901
3000
3100
3200
3300
3400
3700
4100

10

T9411

See Map 2N 10 27

Map Legend

Map Symbols

- Turnout Box
- Open Ditch
- Pipeline
- Property Line

Water Right Certificate

- C-74642
- Transfer From
- Transfer To

East Fork Irrigation District
Hood River, Oregon

Section 28 T2N R10E

Scale 1" = 400' cms

RECEIVED

APR 18 2003

WATER RESOURCES DEPT.
SALEM, OREGON

See Map 2N 10 33

REVISED

