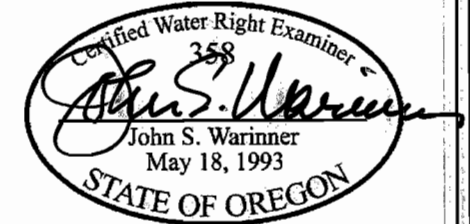





T6N, R35E, S36, WM
 T6N, R36E, S31, WM
 Umatilla County

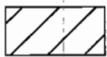


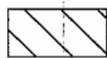
1 inch = 1320 feet

The purpose of this map is to identify the location of a water right. It is not intended to provide information regarding the location of property ownership boundary lines.



- 
Authorized POD
 Point of Diversion is headgate located in the NE/4, NW/4, Section 1, T5N, R35E, WM at a distance 1015 feet S and 450 feet W from N Quarter-Corner of Section 1.
- 
Fish Screen
 Approved gravity drum fish screen located approximately 75 feet N from Authorized POD.
- 
Flowmeter
 Flowmeter located approximately 205 feet N and 40 feet E from Authorized POD.


Authorized POU - Cert 12916
 9.0 acres in SE/4, SE/4, Section 36, T6N, R35E, WM.


Authorized POU - Cert 49291
 1.3 acres in NW/4, SW/4, Section 31, T6N, R36E, WM.
 7.7 acres in SW/4, SW/4, Section 31, T6N, R36E, WM.

RECEIVED
 OCT 15 2007
 WATER RIGHTS DIVISION
 OREGON DEPARTMENT OF AGRICULTURE

FOUNTAINHEAD
 1860 Blue Creek Road
 Walla Walla, WA 99362
 509.529.2646 phone

FINAL PROOF SURVEY MAP
Transfer 9437

in the name of
 SAM LEFORE FRUIT FARMS

Revised 09 OCT 2007