


T.5S. R.4W. WM

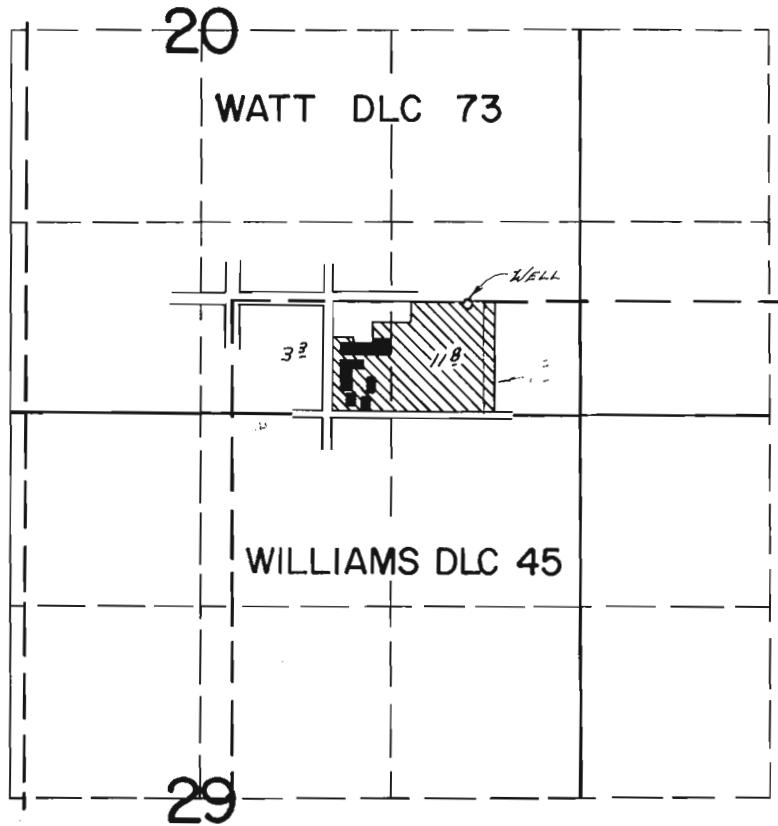

Well Loc.: 1630' E + 10' S FROM NW COR WILLIAMS DLC 45

FINAL PROOF SURVEY
UNDER

Application No. G-52412 Permit No. G-5098
IN NAME OF

AMITY HIGH SCHOOL

Surveyed SEPT 21 1973, by A. F. GOULD

T-8881

1973 T TP