


T.26S., R.18E., W. M.

*Copy*

This map is in error.  
 the section/quarter-quarter  
 lines are off. all land is  
 located ~~at~~ within the 1/2  
 of sections 31 & 32. OK to  
 correct based upon a request  
 of the landowner per OAR  
 690-15-400 when requested

*gab*

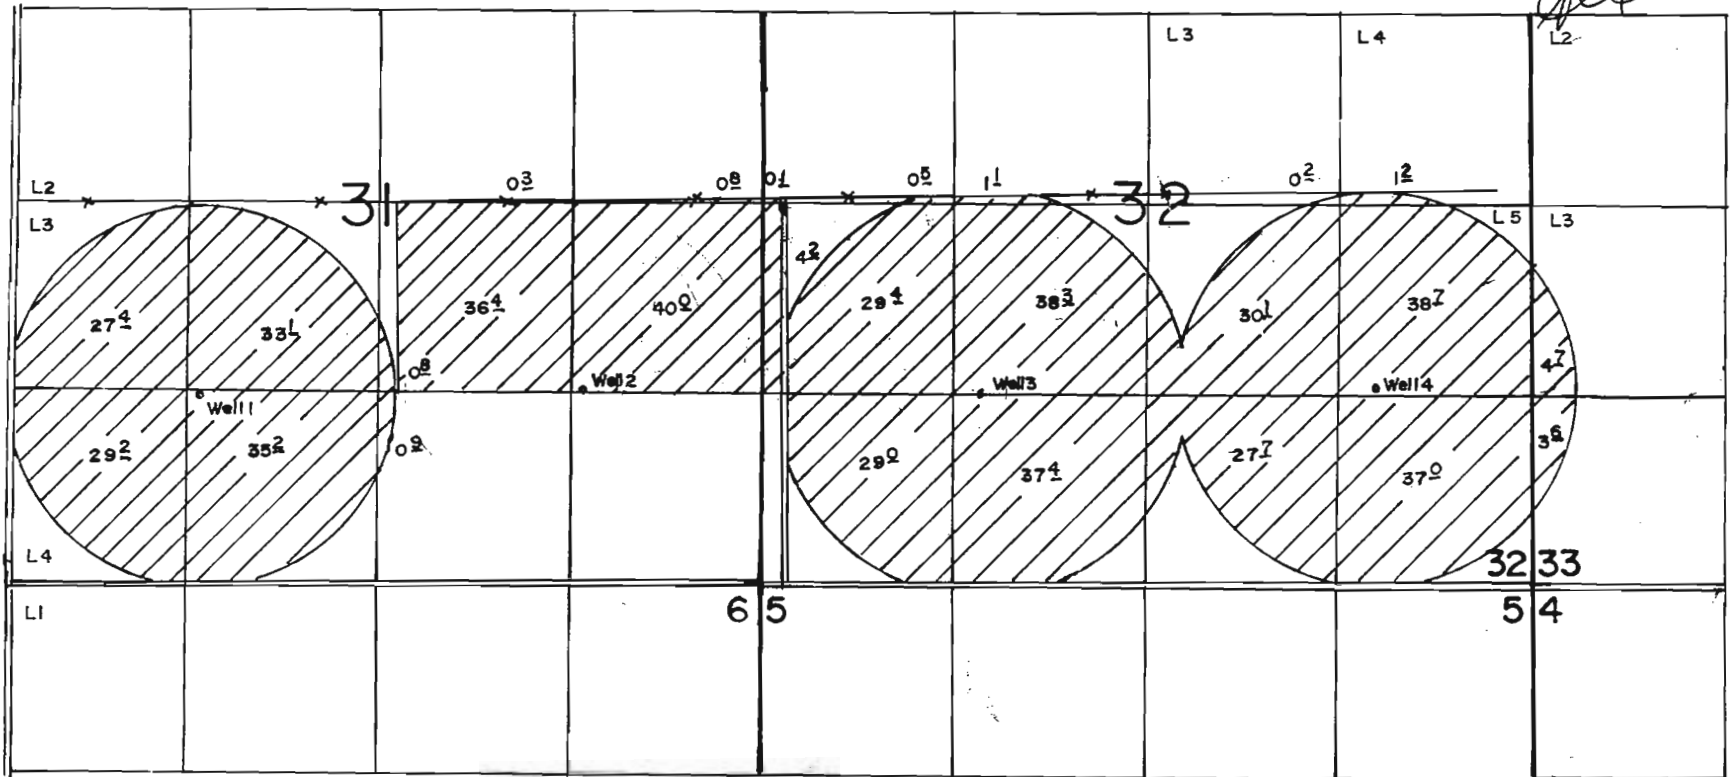

Well 1-1300' N & 1230' W, Well 2-1350' N & 1400' E, Both From S 1/4 Cor. Sec 31 Well 3-1340' N & 1500' W, Well 4-1360' N & 1580' E, Both From S 1/4 Cor Sec 32

**FINAL PROOF SURVEY**

UNDER

Application No G-10071 Permit No G-9124

IN NAME OF

**TERRY L NOFZIGER**

Surveyed June 14 1990 By B.W. BISHOP

PTS II-1990 9-5-90 DLM