


T. 15 & 16 S., R. 10 E., W.M.

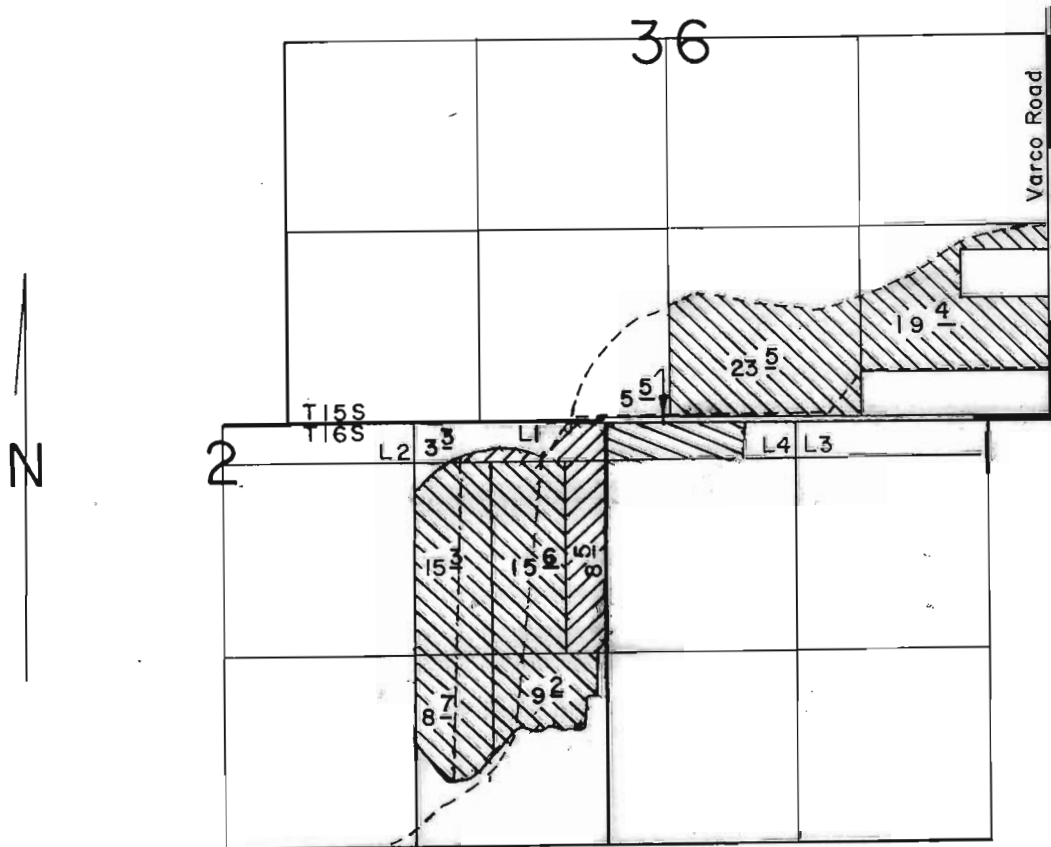

PRIORITY
1886 } ALL HAVE SUPPLEMENTAL RIGHTS
1891 } UNDER PERMIT 12458
1897 }

SCALE: 1" = 1320'

FINAL PROOF SURVEY UNDER

Transfer Nos. V-10 & B-152
IN NAME OF

Surveyed SEPT. 2, 1986, by L.G. OLSON

8-28-92
3-6-92
BWD
41017-179-24L