


T. 1 S. R. 3 W. WM

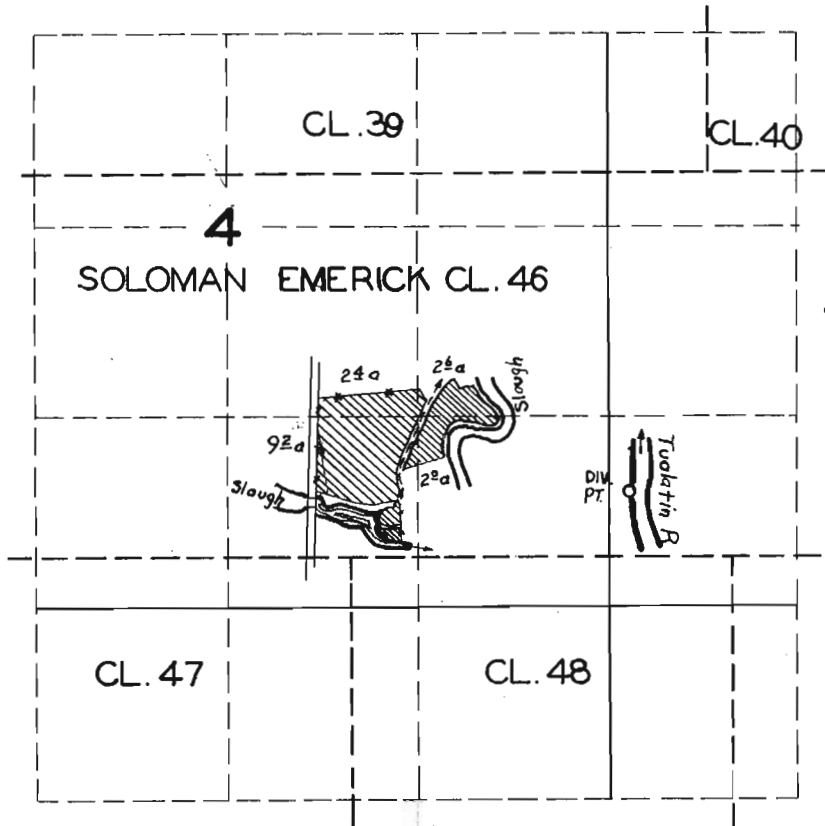

FINAL PROOF SURVEY

UNDER

Application No. 25820 Permit No. 20287

IN NAME OF

D. W. McBETH

Surveyed Apr. 10 1953, by H. L. Coffman