



T 4 N, R 27 E, W.M.,
MORROW COUNTY, OREGON
FINAL PROOF SURVEY

T-8901
IN THE NAME OF JEDEDIAH AYLETT
75816 FRONTAGE ROAD
HERMISTON, OR 97838
541-567-5938

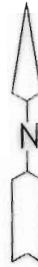

SCALE: 1"=400

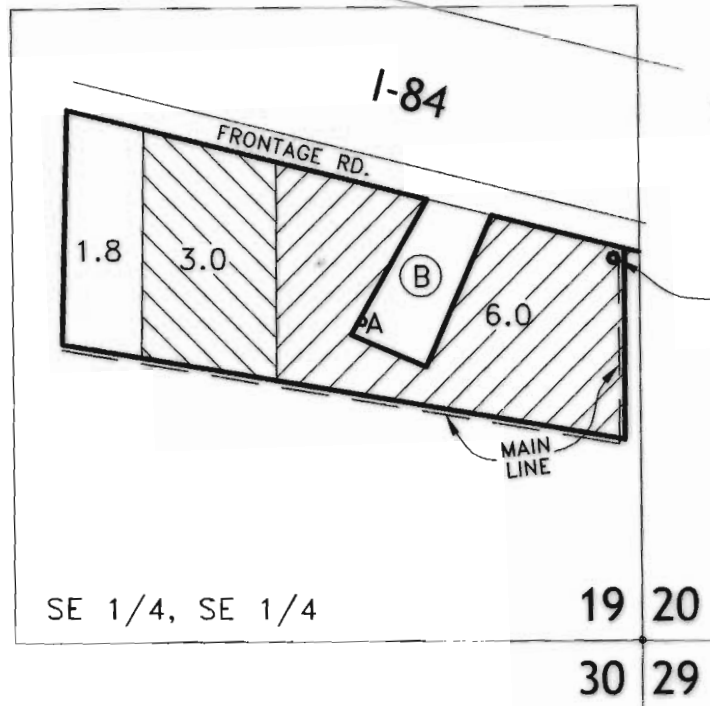

WELL & METER
794' NORTH & 55' WEST
OF SE COR., SEC. 19


- A DOMESTIC WELL
- (B) HOUSE, OUT-BUILDINGS,
DRIVE-WAY & YARD

RECEIVED


JUN 11 2007

**WATER RESOURCES DEPT
SALEM, OREGON**


SUPPLEMENTAL
PERMIT #G 10836

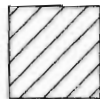

G 190
CERT. #30311

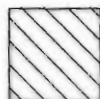

G 2782
CERT. #49076

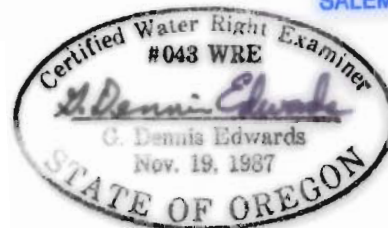

EDWARDS SURVEYING P.O. BOX 763
541-567-3336 HERMISTON, OREGON 97838
9/23/2006 rev. 6/07/07 JOB# W8803009-B
DRAWN BY NJF