
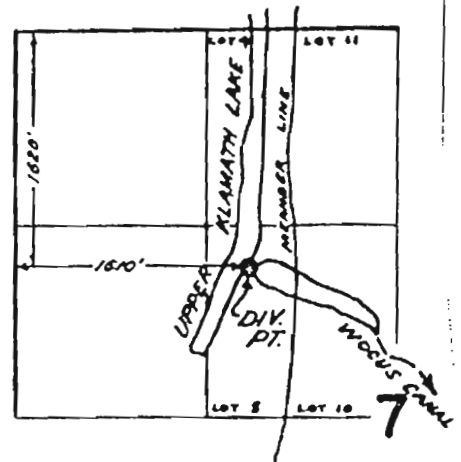


T.38 S.R.8 E.W.M.

RECEIVED

OCT 11 2001

WATER RESOURCES DEPT.  
SALEM, OREGON

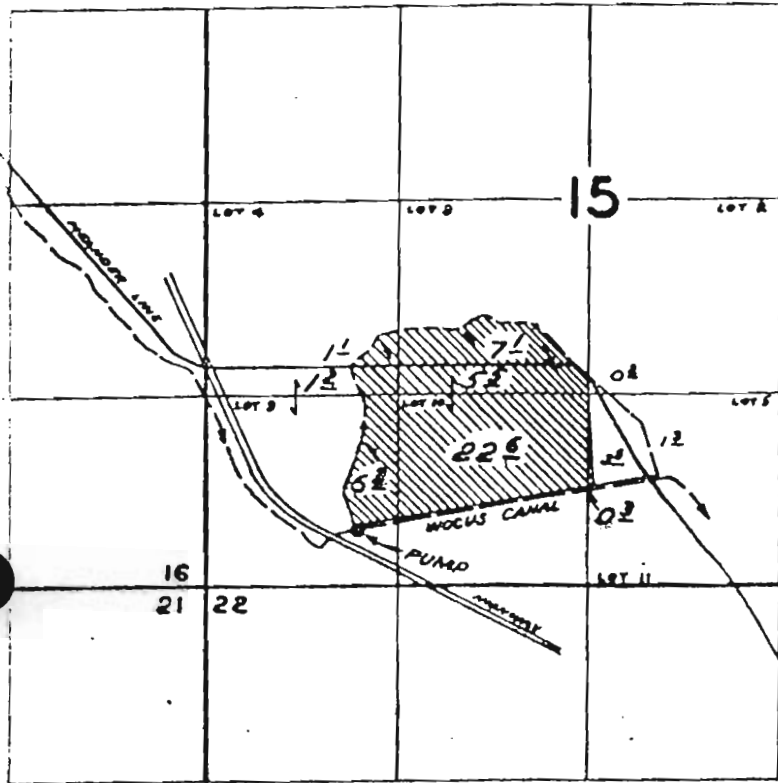

**FINAL PROOF SURVEY**  
UNDER

Application No. 33876 Permit No. 26734  
IN NAME OF

ROLAND W. GEARY

Surveyed SEP. 28, 1965, by R. JACKSON

T-8907