


T. 4 S. R. 3 W. W. M.

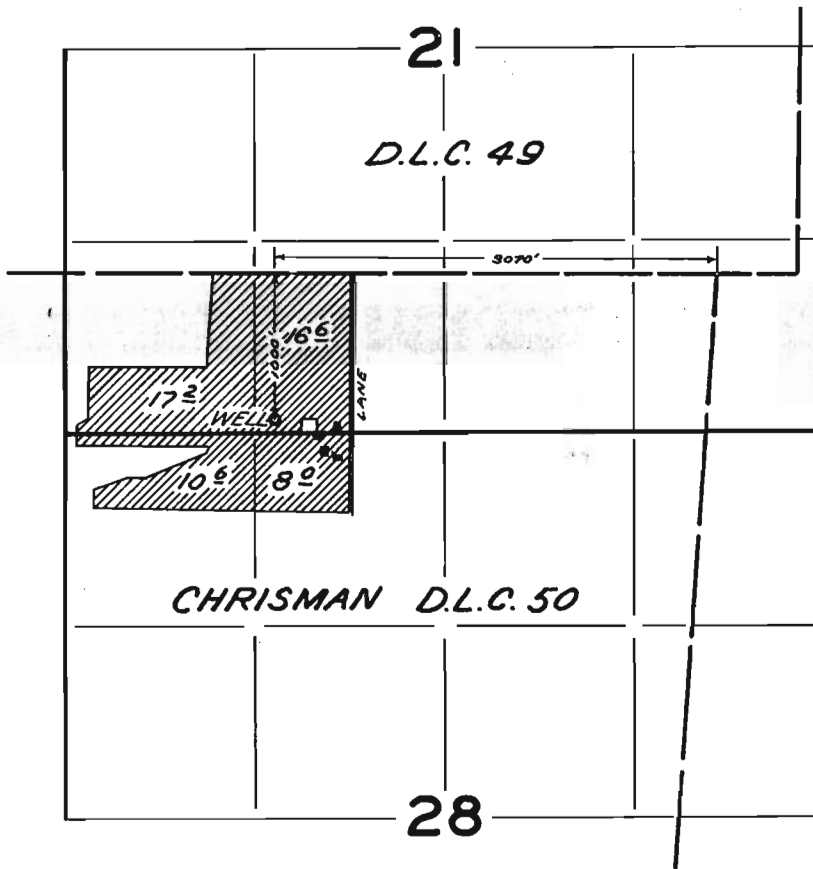

**FINAL PROOF SURVEY**  
UNDER

Application No. 6-2180 Permit No. 6-2010  
IN NAME OF

R. D. McCulloch

Surveyed MAY 5, 1967, by V. GARNER