


RECEIVED

NOV 05 2001

WATER RESOURCES DEPT.
SALEM, OREGON

T.26S.,R.18E.,W.M.

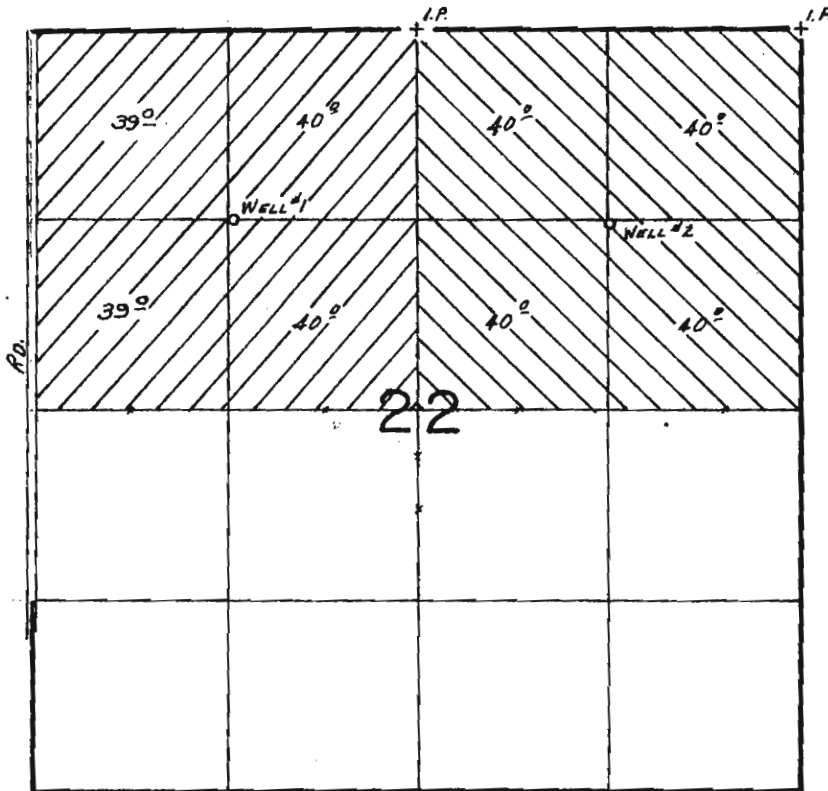

WELLS LOC.: #1-1320'S. & 1280'N, #2-1340'S. & 1340'E, BOTH FROM
N. 1/4 COR. SEC. 22

-  Well no.1
-  Well no.2

SCALE: 1" = 1320'

FINAL PROOF SURVEY
UNDER

Application No. G-9819. Permit No. G-9064....
IN NAME OF

.....GOLDEN RULE FARMS, INC.....

Surveyed Sept., 17... 19.85., by B.W. BISHOP.....