


T.3N.R27E.W.M.

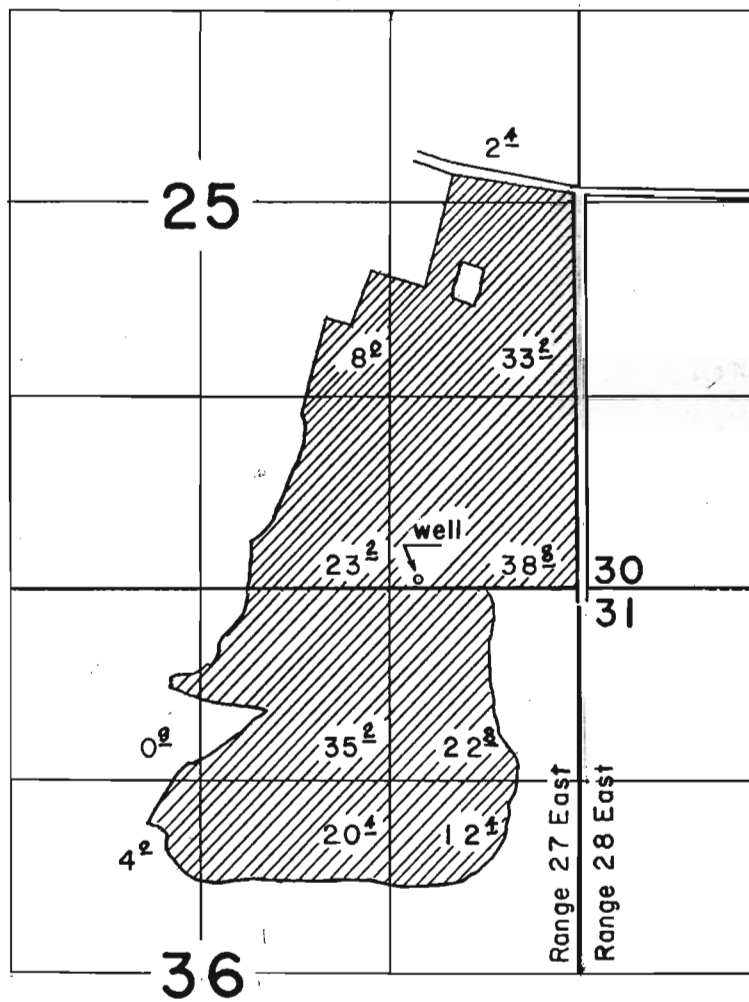

FINAL PROOF SURVEY
UNDER

Application No. G-1845.. Permit No. G-1688...
IN NAME OF

..... **George B. Wallace**

Surveyed Aug. 22.. 1964, by C.J. Gardner...

COPY