


T. 3 N. R. 29 E. W.M.

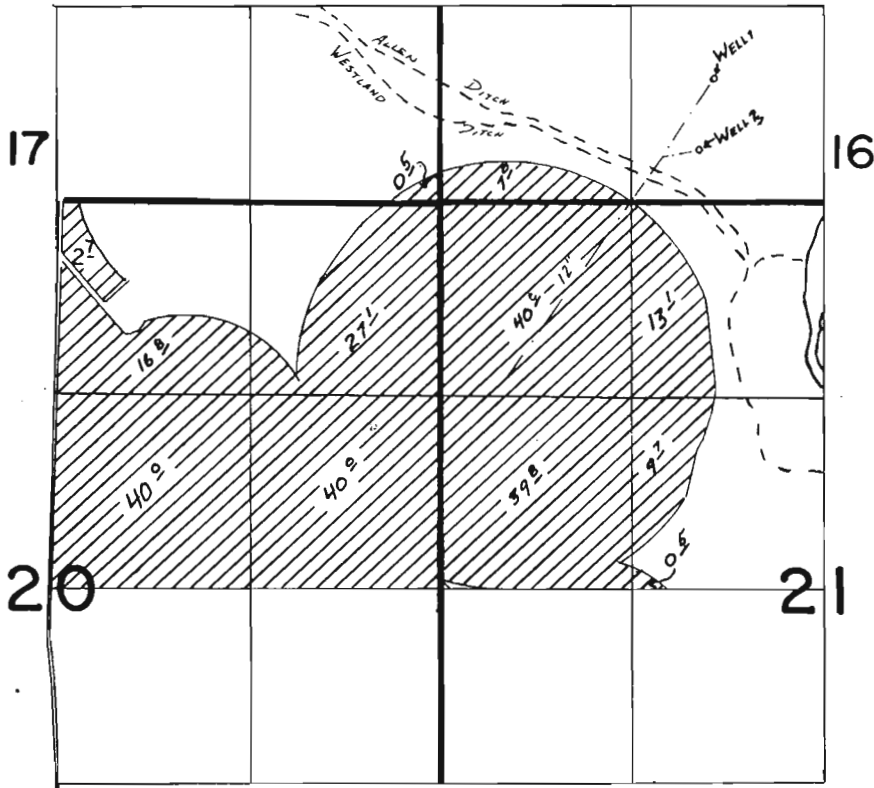

WELL NO.1 LOCATED 850' NORTH AND 750' WEST FROM SOUTH 1/4 COR. SEC.16
WELL NO.3 LOCATED 350' NORTH AND 850' WEST FROM SOUTH 1/4 COR. SEC.16

FINAL PROOF SURVEY UNDER

Application No. **G-7125**. Permit No. **G-6339**....
IN NAME OF

.....**Chester J. Prior et al.**.....

Surveyed **August 18**... **1983**.., by **V.L. CHURCH**.....

COPY