

T-8466 T.7S. R2W.W.M

RECEIVED


DEC 11 1990

WATER RESOURCES DEPT
SALEM, OREGON

RECEIVED

MAR 20 2000

WATER RESOURCES DEPT.
SALEM, OREGON

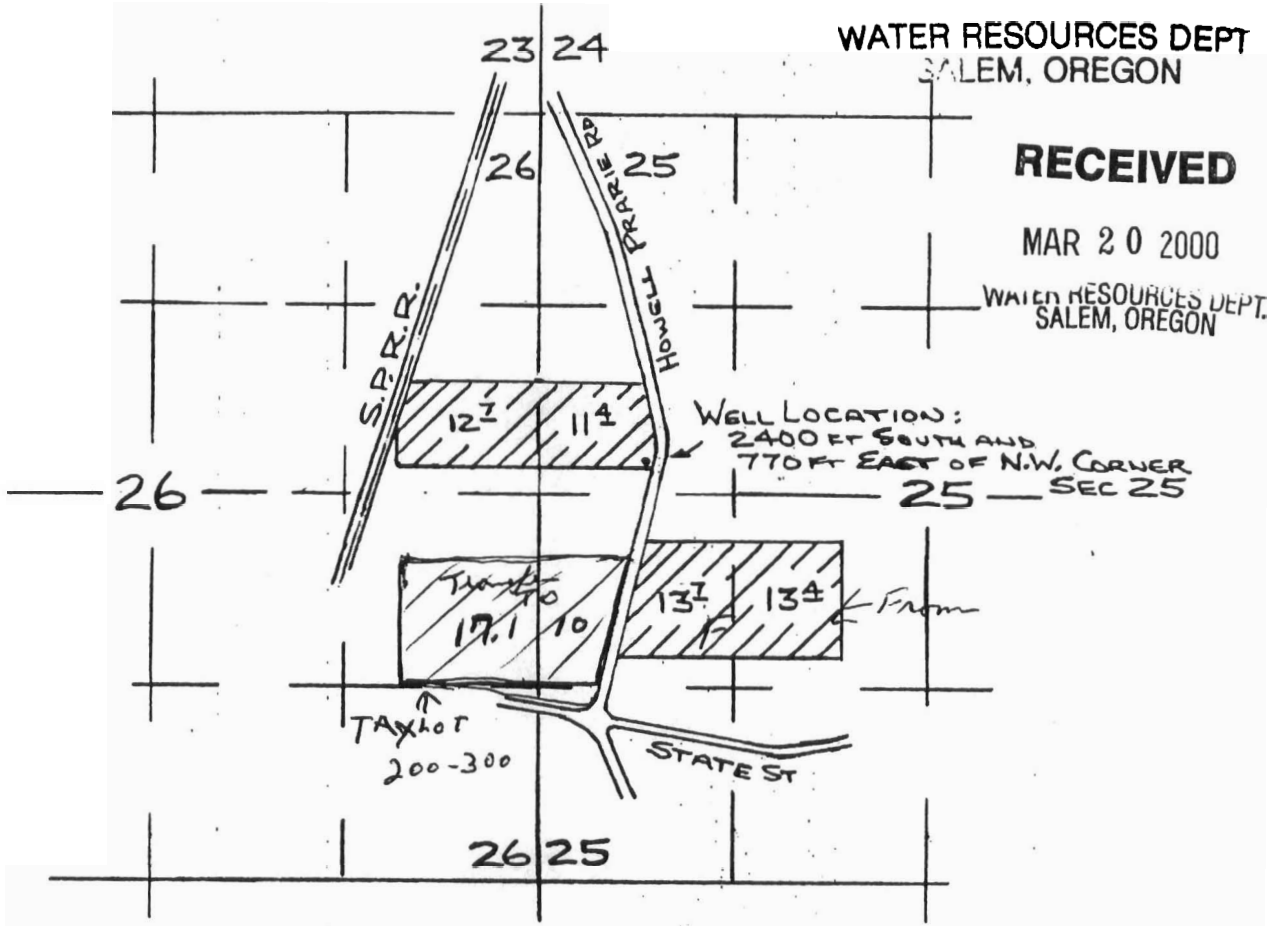

APPLICATION MAP

APPLICATION 9-12337

RANDALL STEFFEN
Nov 30, 1990

SCALE: 1IN: 1320 FT

Permit: G11345

NOTE: MAP IS FOR
PURPOSE OF IDENT-
IFYING LOCATION OF
WATER RIGHT AND HAS
NO INTENT TO DIMEN-
SION OR LOCATE PROPERT
Y OWNERSHIP LINES.

