
## T.35S.,R.1W.,W.M.

## RECEIVED

AUG 2 5 2003

WATER RESOURCES DEPT. SALEM, OREGON

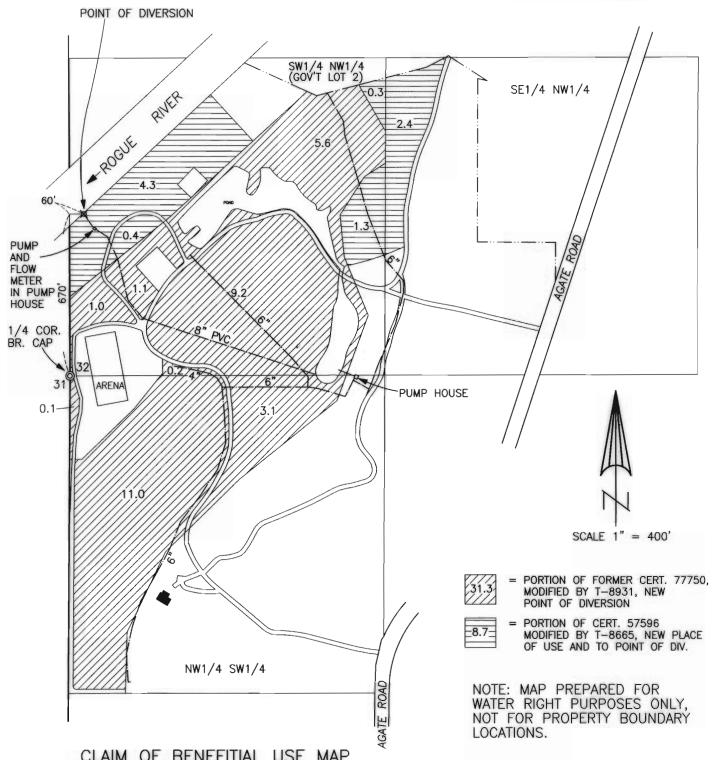

CLAIM OF BENEFITIAL USE MAP APPLICATION Nos. T-8665 AND T-8931

FOR: PHEASANTBROOK, LLC (JAMES BAYER MEMBER) 12155 AGATE ROAD EAGLE POINT, OR. 97524 PREPARED BY: GARY D. KAISER 19440 HWY. 62 EAGLE POINT, OR. 97524

AUGUST 14, 2003

