


**FINAL PROOF MAP**  
 SW1/4NE1/4 and NW1/4SE1/4 Section 13,  
 T. 39 S., R. 3 W., W.M., Jackson County, Oregon  
 For  
 Richard and Adrienne King Hassanein  
 2620 Little Applegate Road  
 Jacksonville, OR. 97530

T. 39 S., R. 3 W., Sec. 13

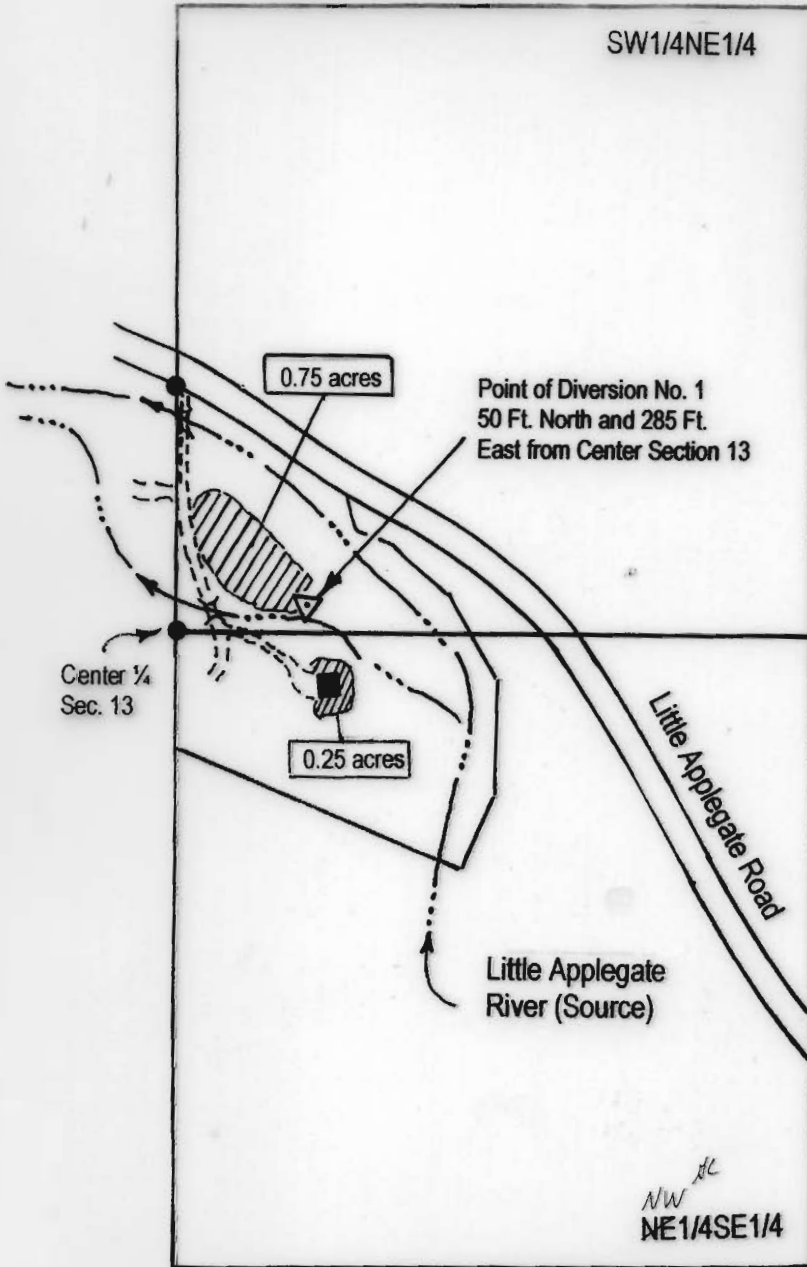

**LEGEND**



Date: July 19, 2005

Scale: 1" = 400'

● Found Survey Monument

■ Denotes Building

▨ Denotes area under Special Order  
 Volume 61, Pages 430-433, Priority  
 Date 1908.

Certified Water Right Examiner  
 HAROLD L. CENTER, P.L.S., C.W.R.E.  
 2604 David Lane - Medford, OR. 97504  
 541-535-6108, Fax 541-535-8752  
 Oregon C.W.R.E. No. 152  
 Certificate Renewal Date, 12/31/05



This map was prepared for the purpose of identifying the location of a water right only and is not intended to provide legal dimensions or location of property ownership.

**RECEIVED**

**AUG 22 2005**

**WATER RESOURCES DEPT  
 SALEM, OREGON**