
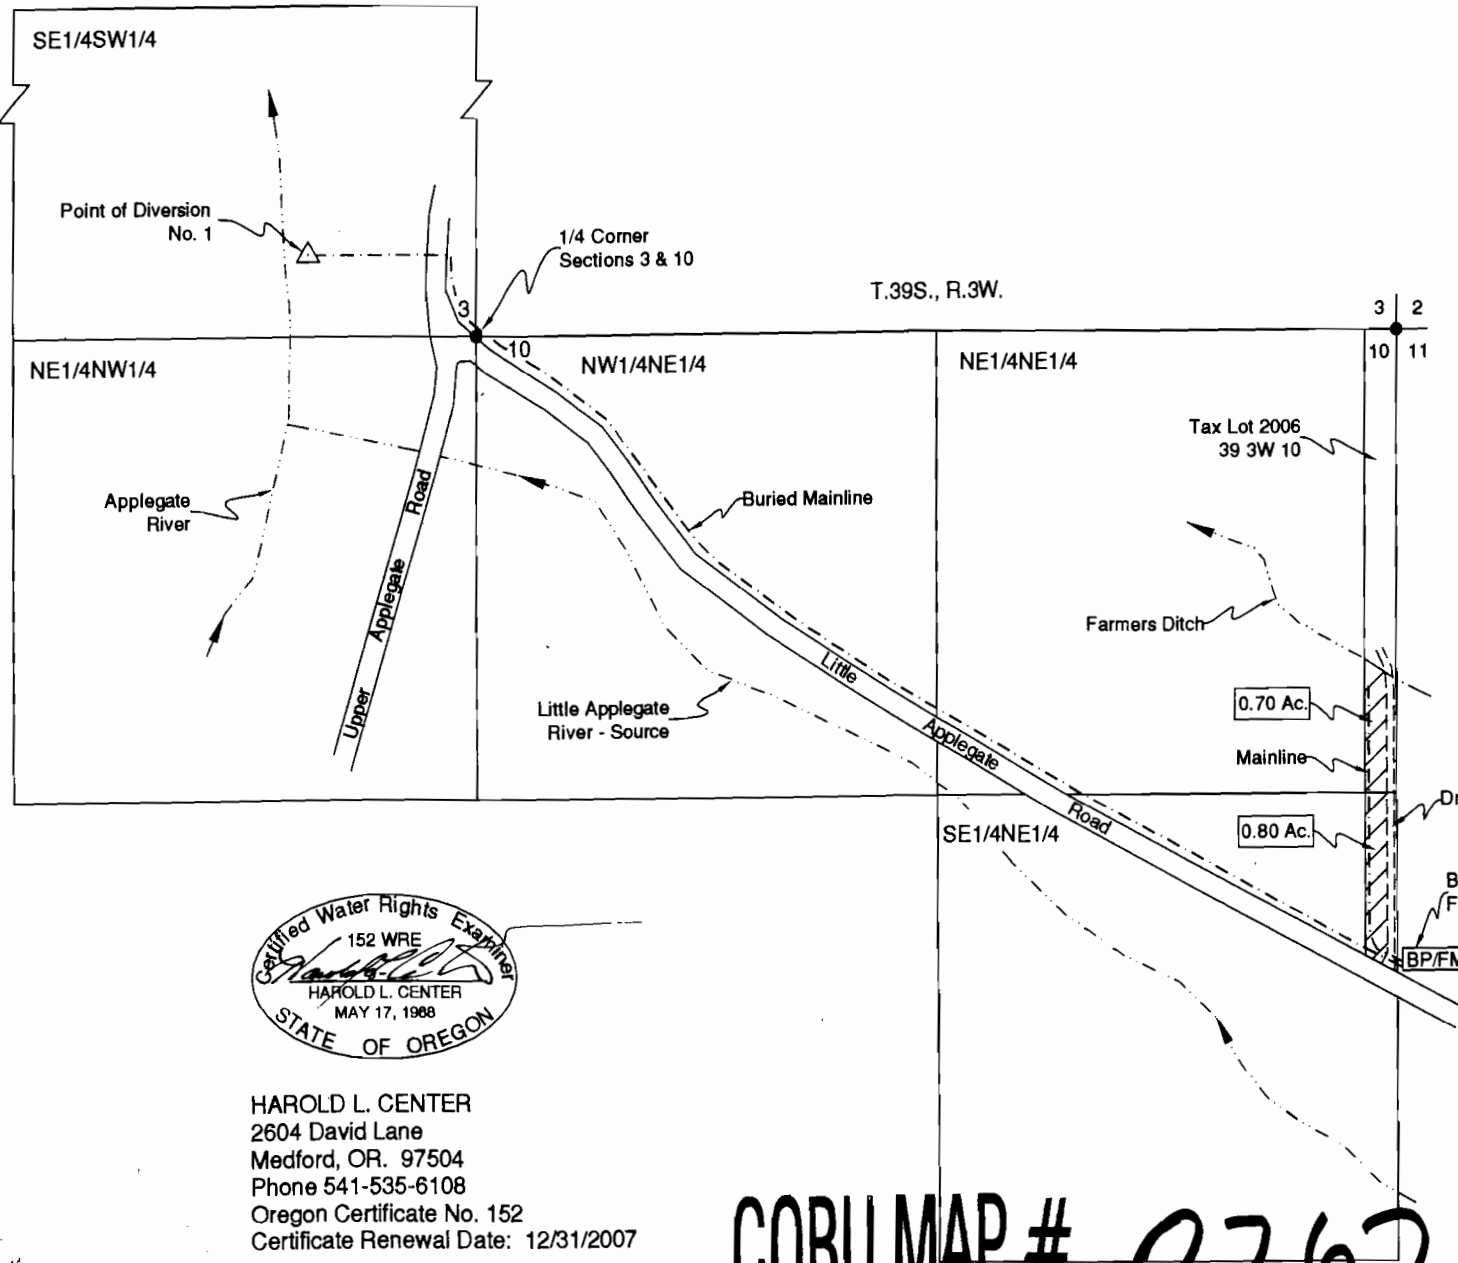


FINAL PROOF MAP T-8964  
 NE1/4NE1/4, SE1/4NE1/4  
 SEC. 10, T.39S., R.3W., W.M.  
 JACKSON COUNTY, OREGON  
 FOR  
 WILLIAM JAMES AND LORI McTAGGART  
 495 LITTLE APPLGATE ROAD  
 JACKSONVILLE, OREGON 97530

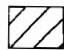

Scale: 1"=400'  
 Date: July 19, 2006

- LEGEND**
- Found Survey Monument
  - === Denotes Driveway
  - - - Denotes Mainline Pipe
  - BP/FM Denotes Booster Pump & Flow Meter
  -  Denotes Area Under Special Order Volume 61, Pages 421-423, Priority Date 1854

Point of Diversion No. 1 - Situated 480' West and 230' North of South One-Quarter Corner, Section 3. Fish Screen at Point of Diversion.

This map was prepared for the purpose of identifying the location of a water right only and is not intended to provide legal dimensions or location of property ownership.



HAROLD L. CENTER  
 2604 David Lane  
 Medford, OR. 97504  
 Phone 541-535-6108  
 Oregon Certificate No. 152  
 Certificate Renewal Date: 12/31/2007

**COBU MAP # 0262**

**RECEIVED**

MAY 09 2006

WATER RESOURCES DIVISION  
 SALEM, OREGON