

TOWNSHIP 6 SOUTH & 7 SOUTH
RANGE 3 WEST, W.M.

N

0 660 1320 2640
SCALE: 1" = 2640' 0"

CITY LIMITS


Marion
County

EXISTING
DELTA WELL
(ABANDONED)

NEW DELTA
WELL SITE

KEIZER


SALEM

WATER USE AREA- 

NOTE: THE NEW DELTA WELL IS 3' WEST AND
37' SOUTH OF THE ORIGINAL ABANDONED
DELTA WELL.

NOTE: MAP IS FOR SOLE PURPOSE
OF IDENTIFYING LOCATION OF WATER
RIGHT AND HAS NO INTENT TO DIMENSION
OR LOCATE ANY PROPERTY OWNERSHIP LINES

APPLICATION _____ PERMIT NO. _____

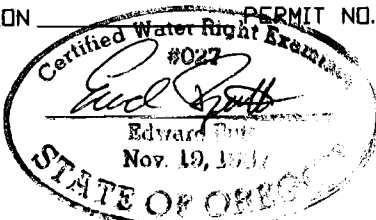

RECEIVED

APR 08 2008

WATER RESOURCES DEPT
SALEM, OREGON

CITY OF KEIZER
DELTA WELL
RIGHTS TRANSFER APPLICATION MAP
OCTOBER 15, 2007

11591