

City of Aumsville Water Map



Church Well is located 190'N & 1300'E from E1/4 cor of Section 25. (This well to be added to permit)

Well #2 (New Park Well) is located 1000'N & 3460'W from SE cor of Section 25. (This well to remain on permit)


Well #1 (Lucas Well) is located 920'S & 620'W from NE cor of Section 25. (This well to be removed from permit)

- CITY LIMITS
- SEWAGE TREATMENT LAGOONS
- ===== URBAN GROWTH BOUNDARY
- RAIL ROAD
- ▨ Area Served

Permit Amendment G-10223

GRAPHIC SCALE
0 200 400 600 800 1000

By:	Date	Revision
SCO	7/1/2010	6.4

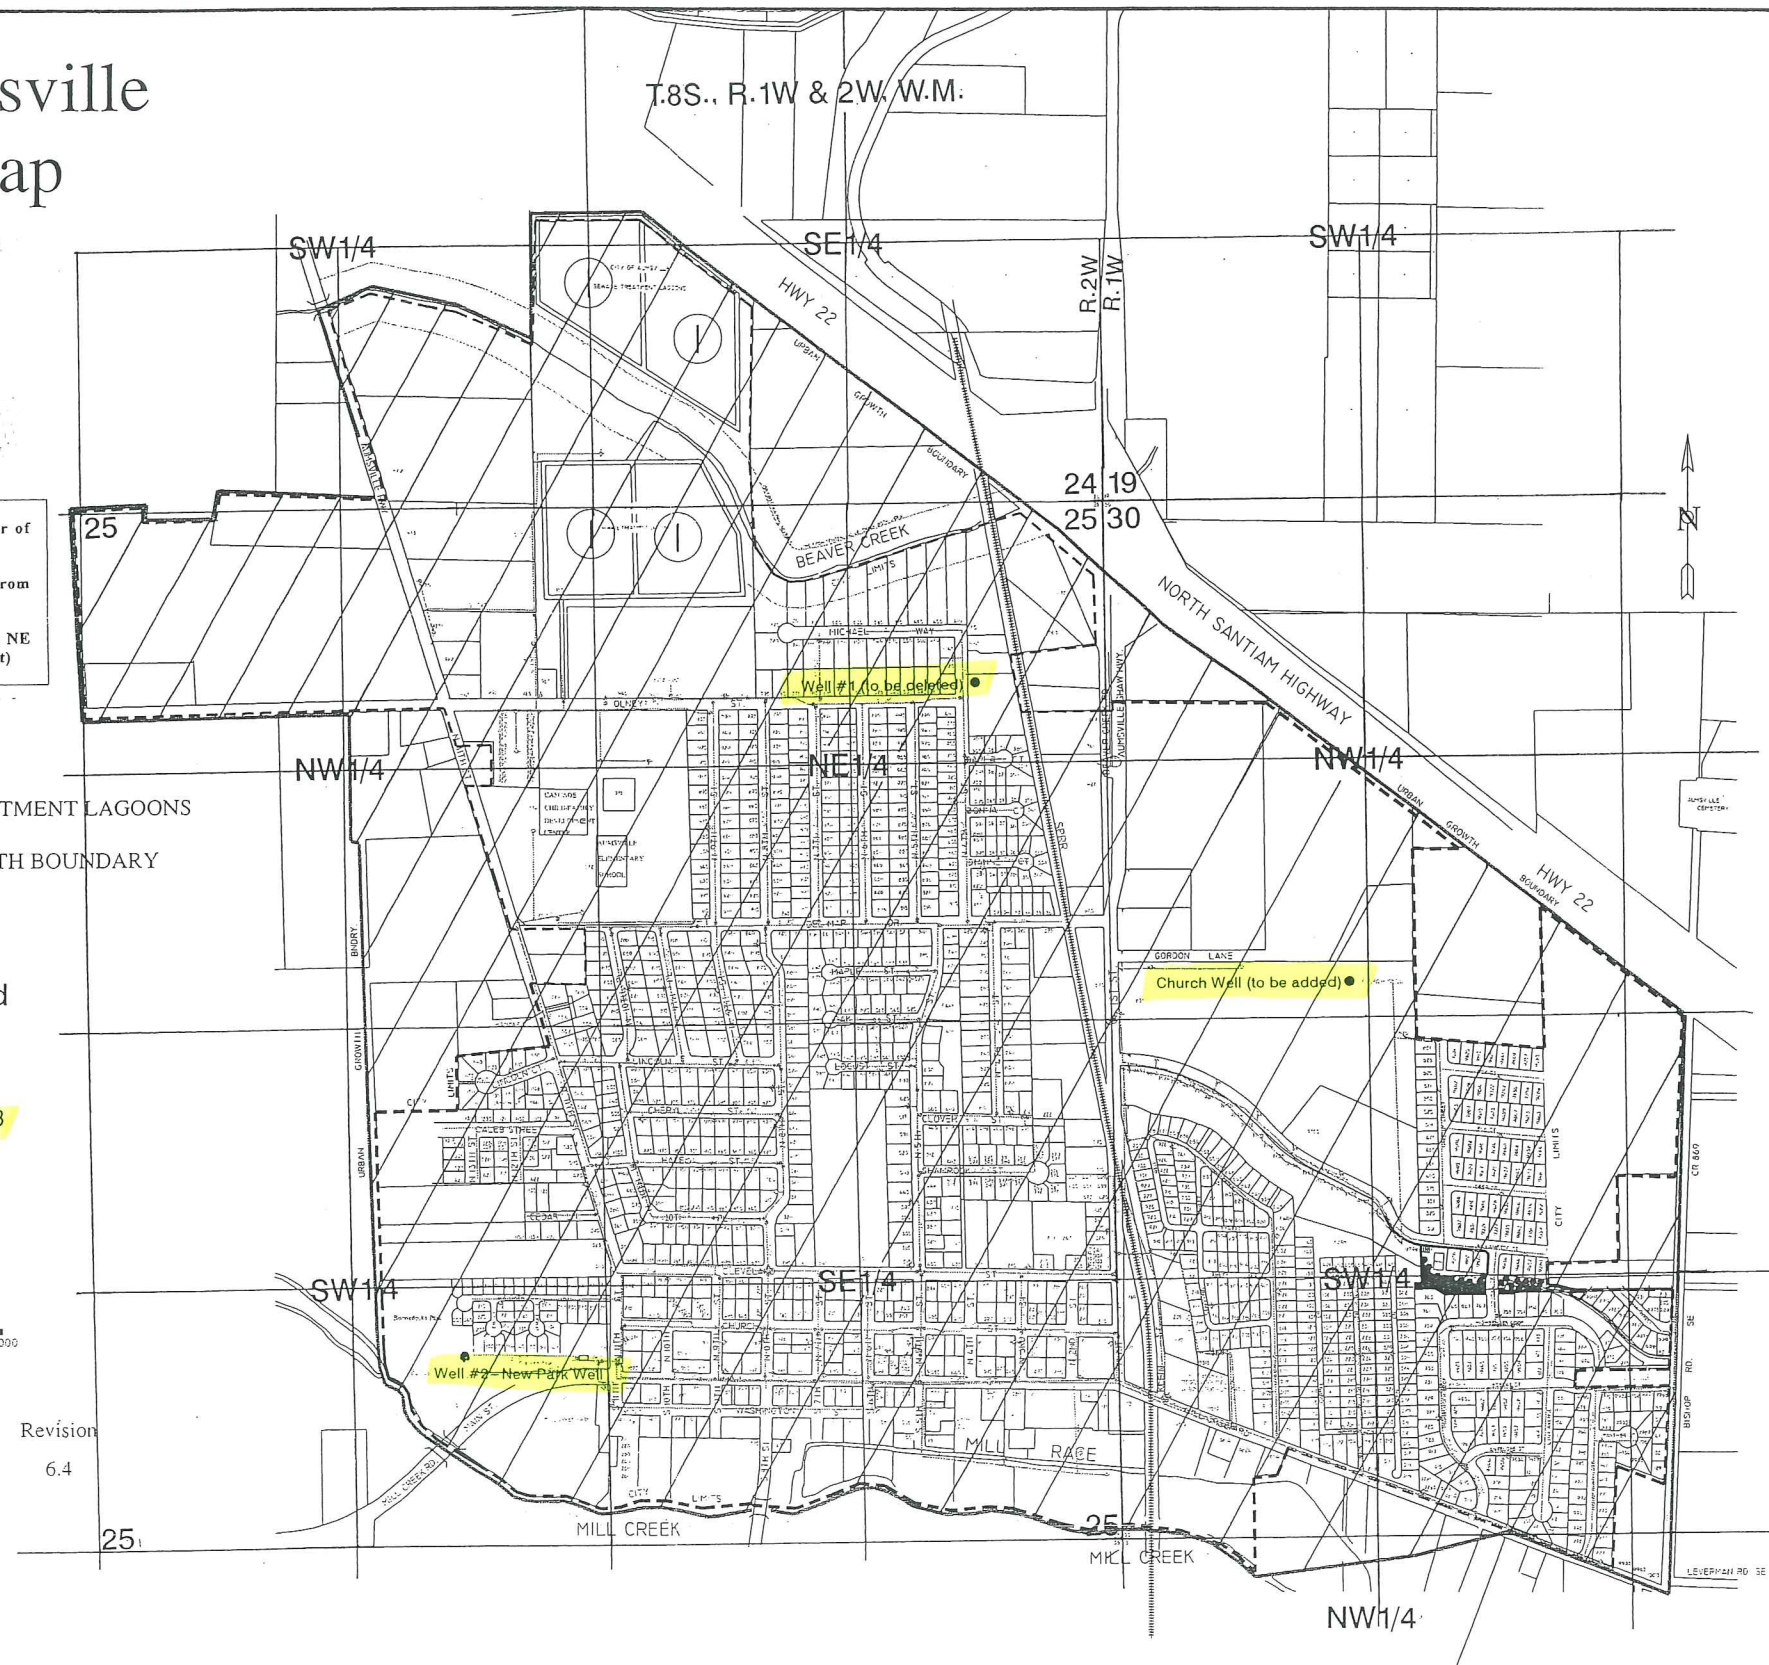


RECEIVED

JAN 18 2011

WATER RESOURCES DEPT
SALEM, OREGON

T 11186

T.8S., R.1W&2W., W.M.

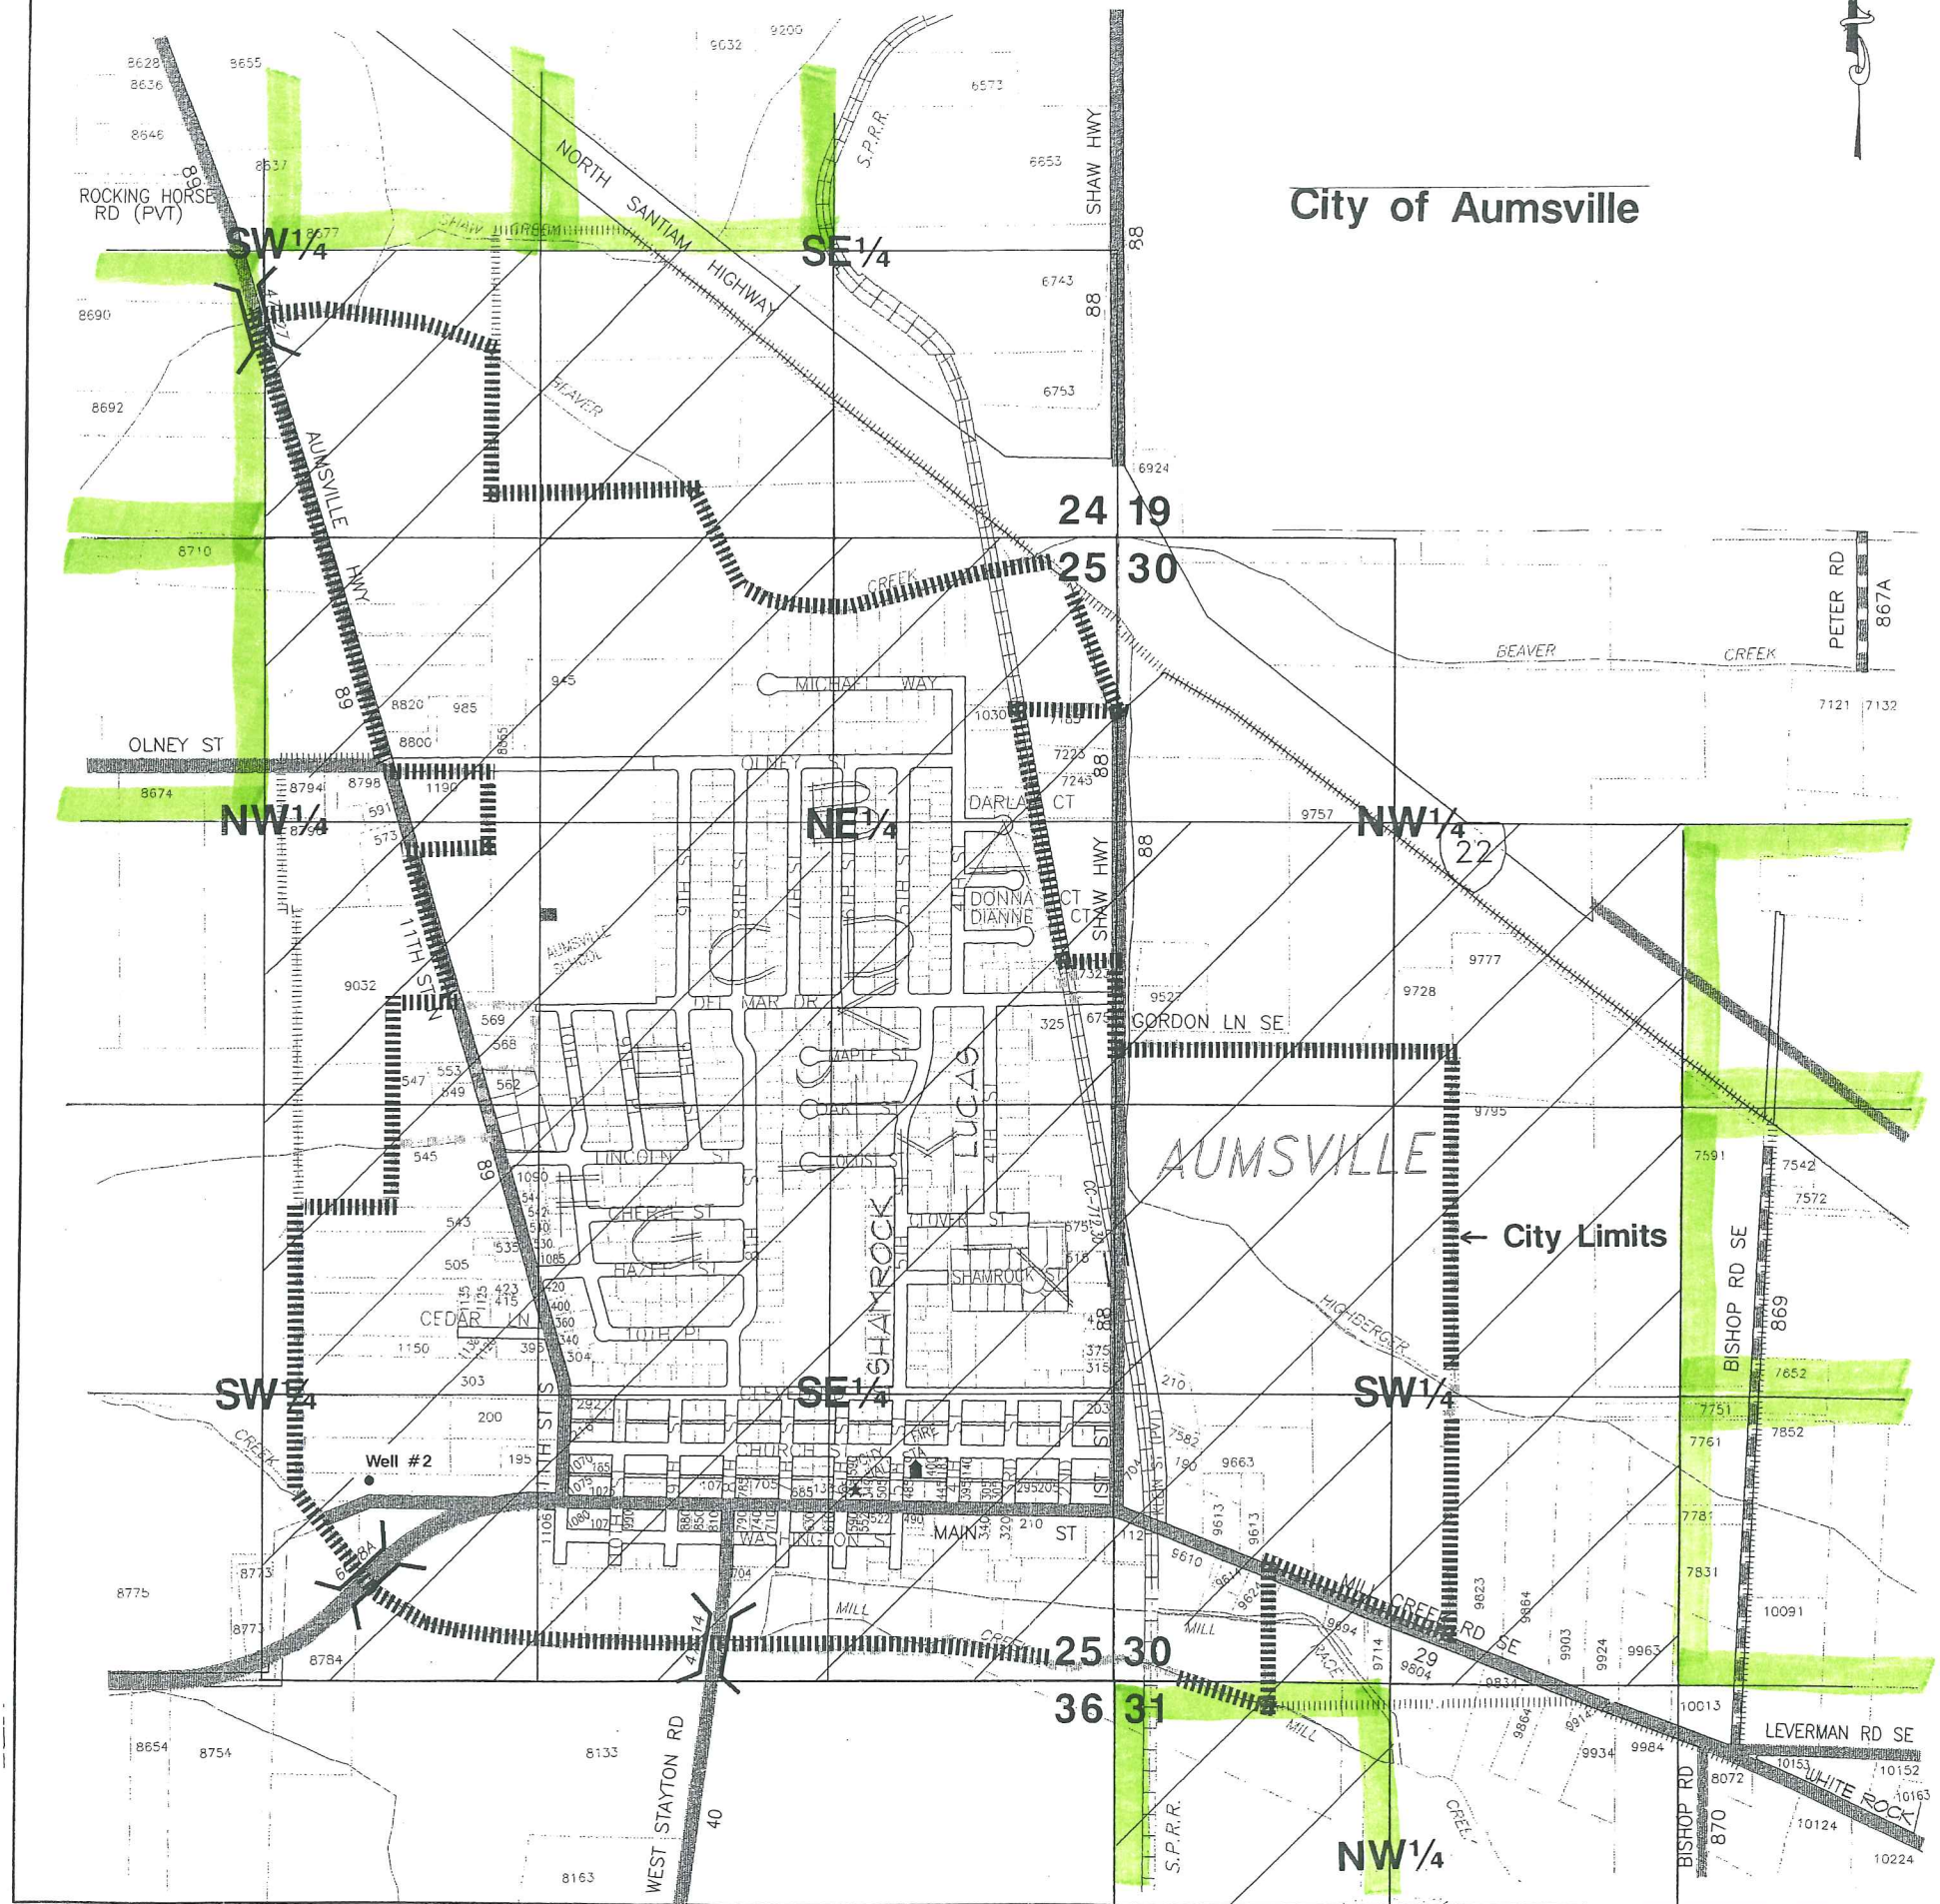

AREAS WITHIN
TO BE ADDED UNDER PERMIT
AMENDMENT G-10223

RECEIVED

JAN 18 2011

WATER RESOURCES DEPT
SALEM, OREGON

T 11186