


ATTACHMENT
'E'

67133

T.37S., R.8&9E., W.M.

MAP - TO LANDS
1 of 2

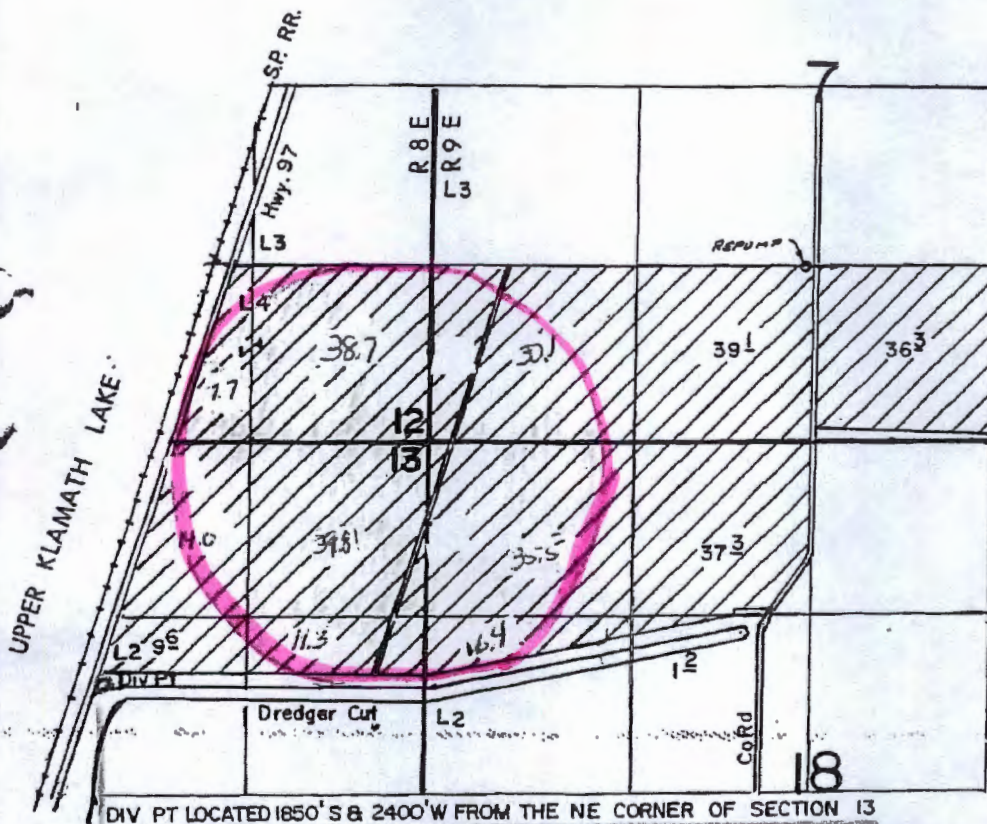

SCALE: 1"=1320'

FINAL PROOF SURVEY UNDER

Application No. 55994... Permit No. 41590.....
IN NAME OF

FORNEY W. & JENNIFER D. SCRONCE

Surveyed APRIL 10, 1990, by B.W. BISHOP.....
Oct. 16 1990

RECEIVED BY OWRD

JUL 20 2015

SALEM, OR

41035-178-179D

REVISED 1-29-91/BWB
6-14-90 DLM.


T 12105

T37S, R88E, W.M.

Source:

Upper Klamath Lake

to Lands

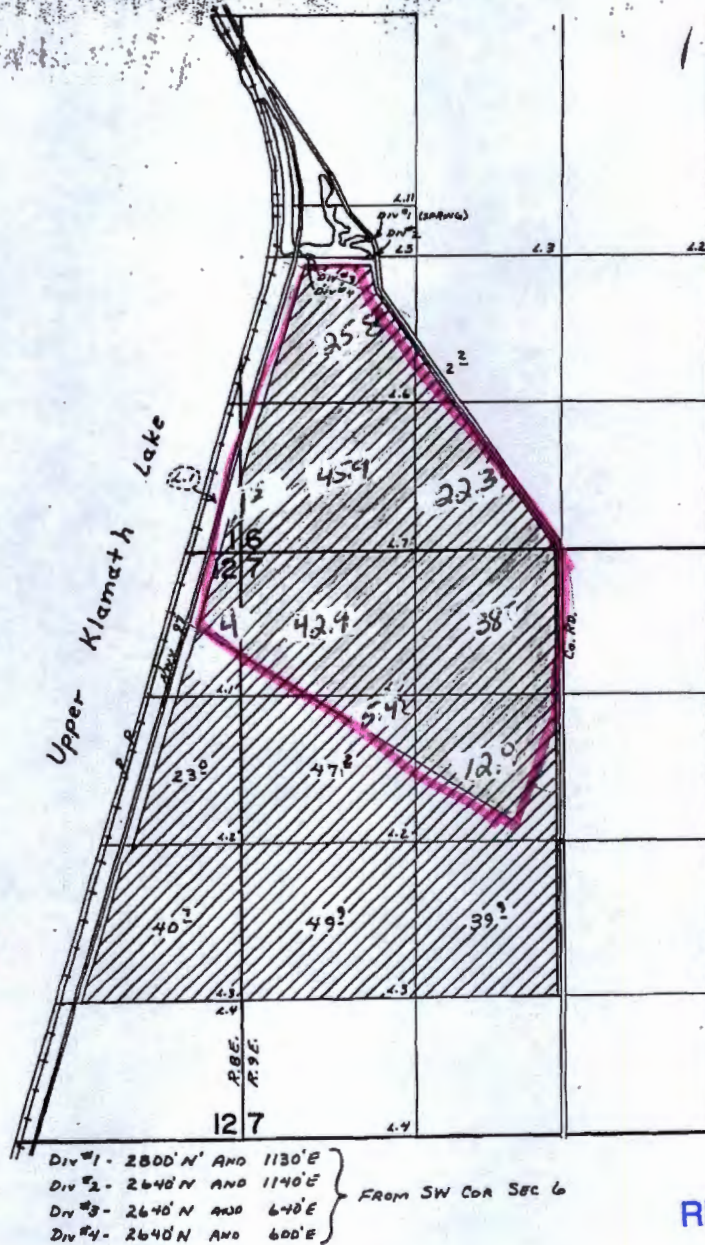

FINAL PROOF SURVEY
UNDER

RECEIVED BY OWRD

JUL 20 2015

SALEM, OR

Application No. 48878 Permit No. 35928. Cert # 44733
 IN NAME OF
 FREDERIC B. ROBERTA SCHILDMAYER

Surveyed July 11, 1975, by L. E. Gould

T 12105

KLAMATH BASIN ADJUDICATION KLAMATH PROJECT LANDS MAP


ATTACHMENT B
"FROM LANDS" MAP
1 of 2

RECEIVED BY OWRD

JUL 20 2015

SALEM, OR

T 12105

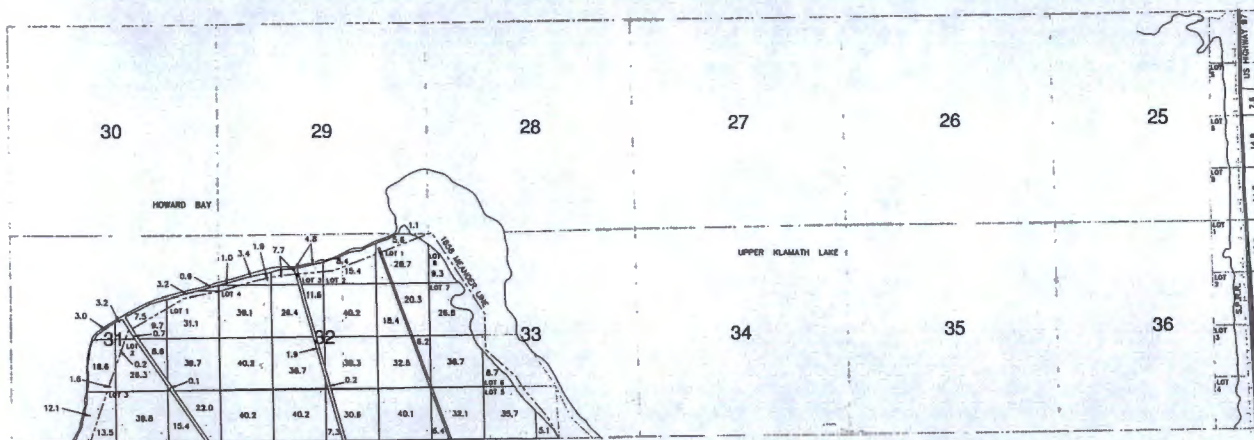

LEGEND

- 30.0 IRRIGATED FIELD ACREAGE WITHIN 1/4 1/4
- LOT 1 GOVERNMENT LOT NUMBER
- SEE INSERT SEE SUPPLEMENTAL MAP SHOWING PLACES OF USE
- PLACE OF USE
- MEANDER LINE
- RAILWAY

THE INFORMATION USED TO PREPARE THIS MAP HAS NOT BEEN FIELD VERIFIED BY ADKINS CONSULTING ENGINEERING, LLC. THIS MAP IS NOT INTENDED TO PROVIDE LEGAL DIMENSIONS OR LOCATIONS OF PROPERTY LINES.



TOWNSHIP 37 SOUTH, RANGE 8 EAST, W.M.

ADKINS

ADKINS CONSULTING ENGINEERING, LLC
2000 Benton Way • Klamath Falls, Oregon 97603 • (530) 824-4444 • FAX (530) 884-6444
Oregon • California
December 13, 2012 1000-100

T37S R8E W.M.

SALEM, OR

ATTACHMENT B
"FROM LANDS" MAP
2 of 2



30.0	IRRIGATED FIELD ACREAGE WITHIN 1/4 1/4
LOT 1	GOVERNMENT LOT NUMBER
SEE INSERT	SEE SUPPLEMENTAL MAP SHOWING PLACES OF USE
	PLACE OF USE
	MEANDER LINE
	RAILWAY

THE INFORMATION USED TO PREPARE THIS MAP HAS NOT BEEN FIELD VERIFIED BY ADAMS CONSULTING ENGINEERING, L.L.C. THIS MAP IS NOT INTENDED TO PROVIDE LEGAL DIMENSIONS OR LOCATIONS OF PROPERTY LINES.



ADKINS

3600 Shasta Way • Roseville, CA, 95767 • (916) 864-0022 • FAX (916) 864-0225
Oregon • California 1500-4

T37SR09E W.M.

2 ←

EVIDENCE OF USE



T 12105

JUL 20 2015

SALEM, OR