


APPLICATION MAP FOR
CITY OF INDEPENDENCE
OCTOBER 28, 2015
SCALE: 1" = 1320' 0"

-  SIGNIFIES AREA OF POINT OF USE
-  CITY LIMITS
-  URBAN GROWTH BOUNDARY (WATER USE AREA)

APPLICATION _____


NOTE: MAP IS FOR SOLE PURPOSE
OF IDENTIFYING LOCATION OF WATER
RIGHT AND HAS NO INTENT TO DIMENSION
OR LOCATE ANY PROPERTY OWNERSHIP LINES

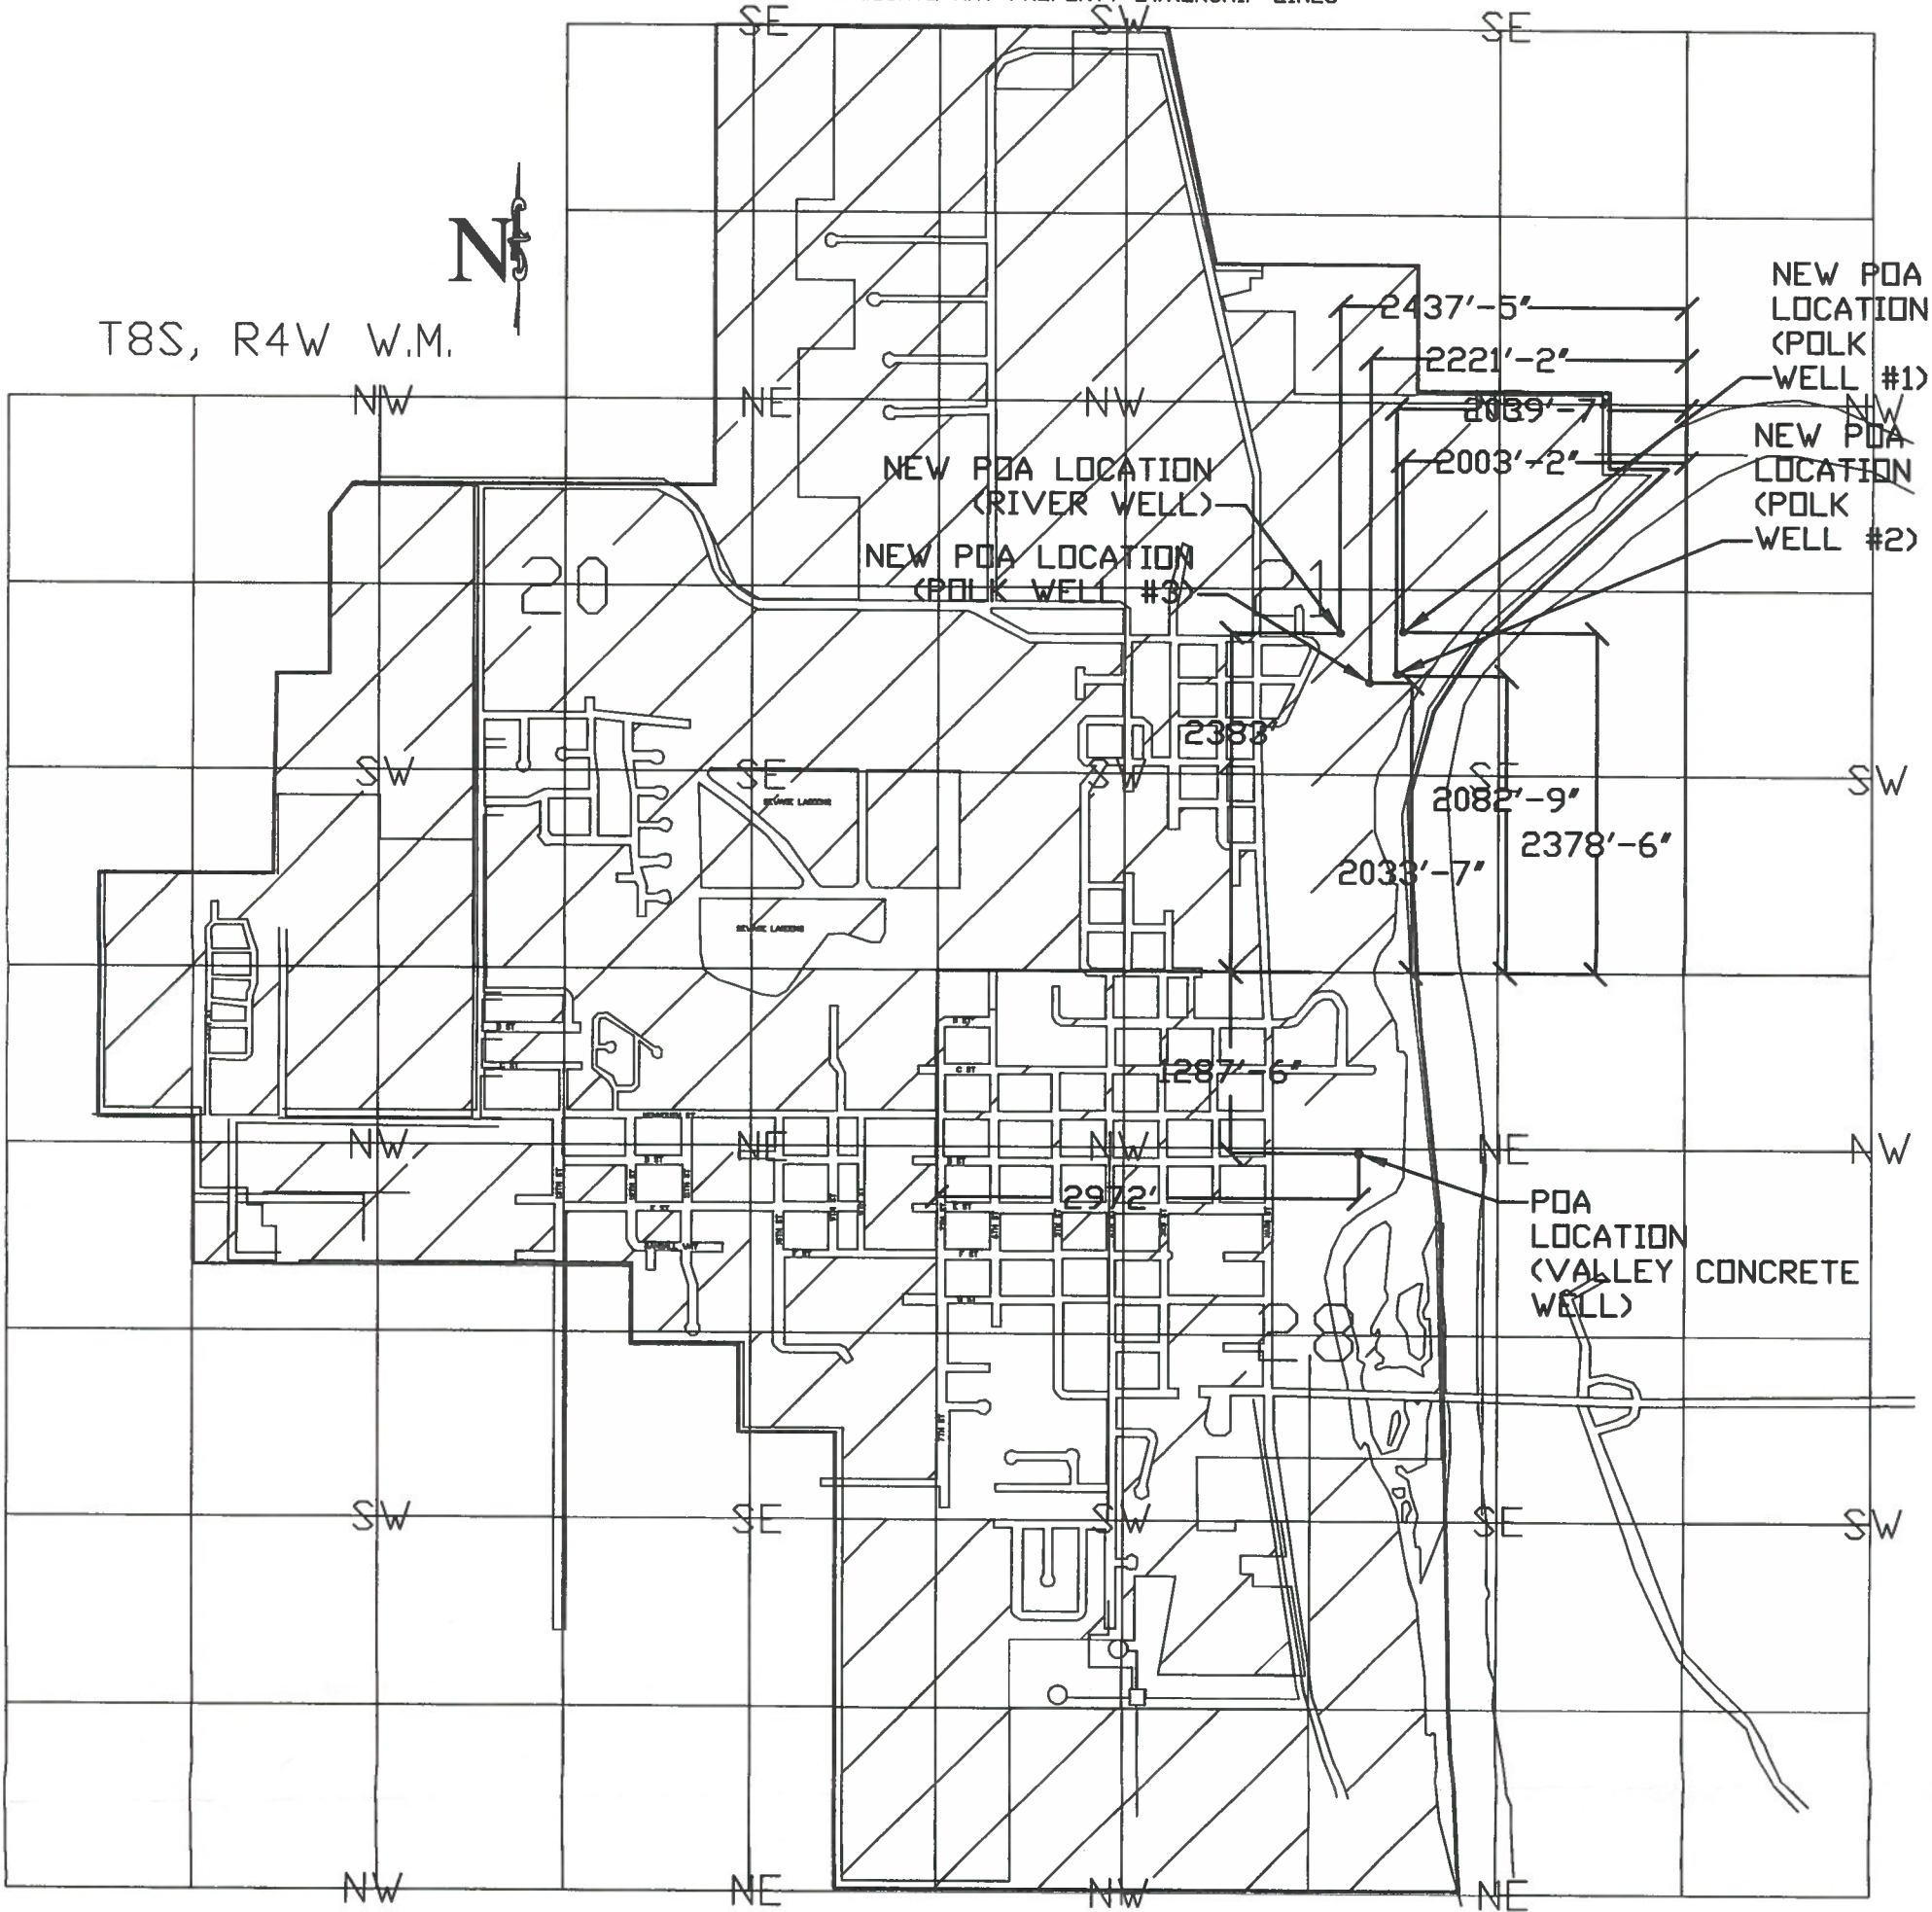

NOTE: EXISTING POA IS 2,972' EAST AND 1,287'-6' SOUTH OF THE NW CORNER OF TOWNSHIP 8S, RANGE 3W SECTION 28.

NEW POA FOR RIVER WELL IS 2383' NORTH AND 2437'-5' WEST OF THE SE CORNER OF SECTION 21, T8S, R4W, W.M.
NEW POA FOR POLK WELL #1 IS 2378'-6' NORTH AND 2003'-2' WEST OF THE SE CORNER OF SECTION 21, T8S, R4W, W.M.
NEW POA FOR POLK WELL #2 IS 2082'-9' NORTH AND 2039'-7' WEST OF THE SE CORNER OF SECTION 21, T8S, R4W, W.M.
NEW POA FOR POLK WELL #3 IS 2033'-7' NORTH AND 2221'-2' WEST OF THE SE CORNER OF SECTION 21, T8S, R4W, W.M.

RECEIVED
FEB 04 2016
OWRD

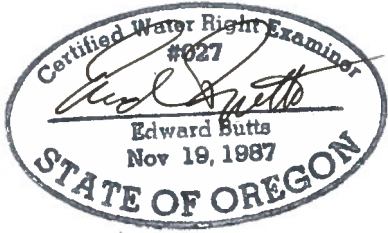


TOWN OF
HENRY HILL'S
INDEPENDENCE

'C' ST.

'D' ST. MAIN ST.

1/4 CORNER BETWEEN SEC. 21 & SEC. 28
& S.E. CORNER THORPS D.L.G.

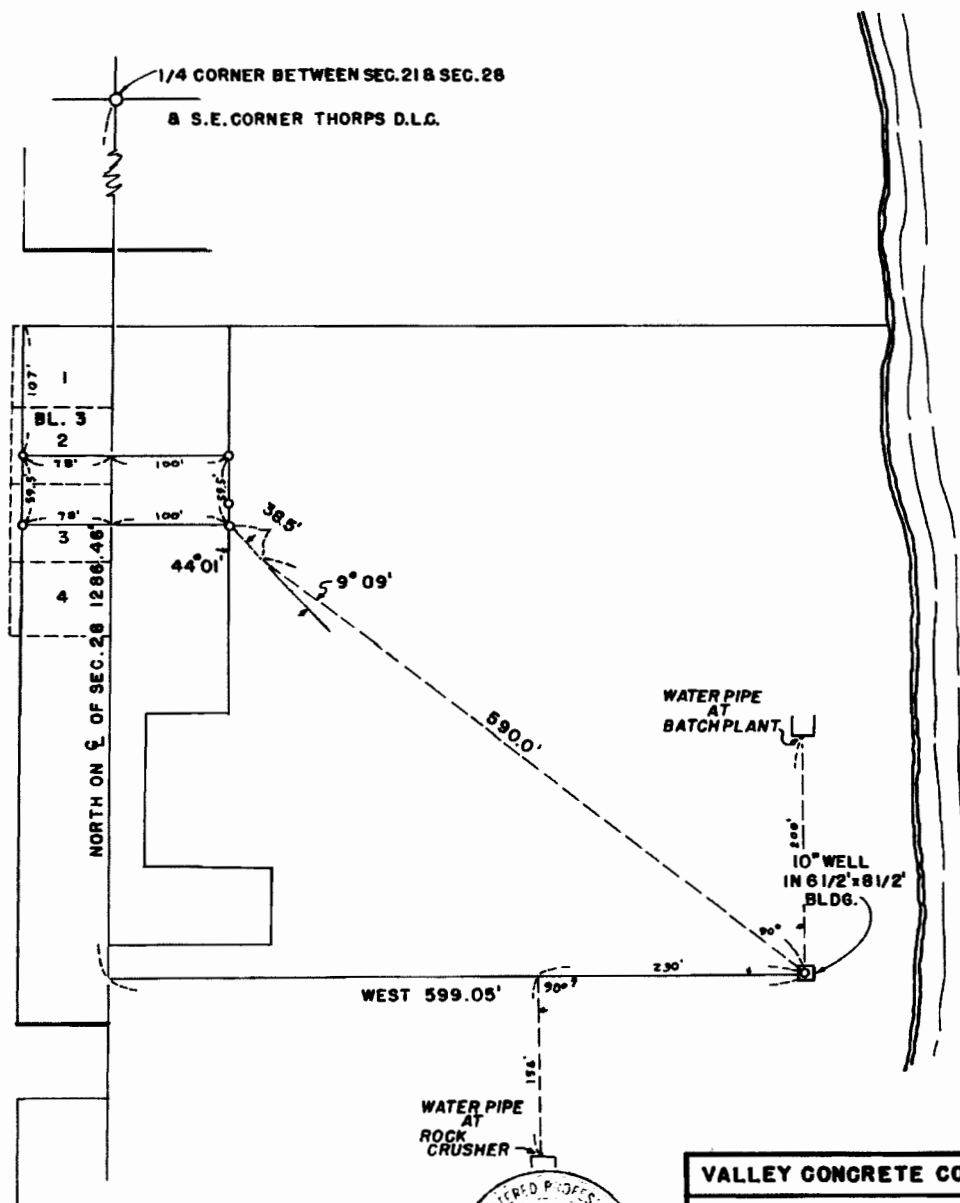

WILLAMETTE RIVER
NORTH

Applicant No. G-2469
Permit No. G-2279

WATER PIPE
AT
ROCK
CRUSHER



VALLEY CONCRETE CO.		INDEPENDENCE, ORE.	
WELL LOCATION			
SEC. 28, T8S, R4W, W.M.		POLK COUNTY, ORE.	
SC: 1" = 100'	8 OCTOBER 1962		J.O. 62102
SRVY: ACG	CLARK & GROFF ENGRS. 3240 TRIANGLE DR. S.E. SALEM, OREGON		8-122
DRW: FTS			
CHK: WWC			

RECEIVED
FEB 04 2016
OWRD

T 1204