


Transfer Application - Certificate 82863 AcreTrader 184, LLC

0 660 1,320 2,640 Feet

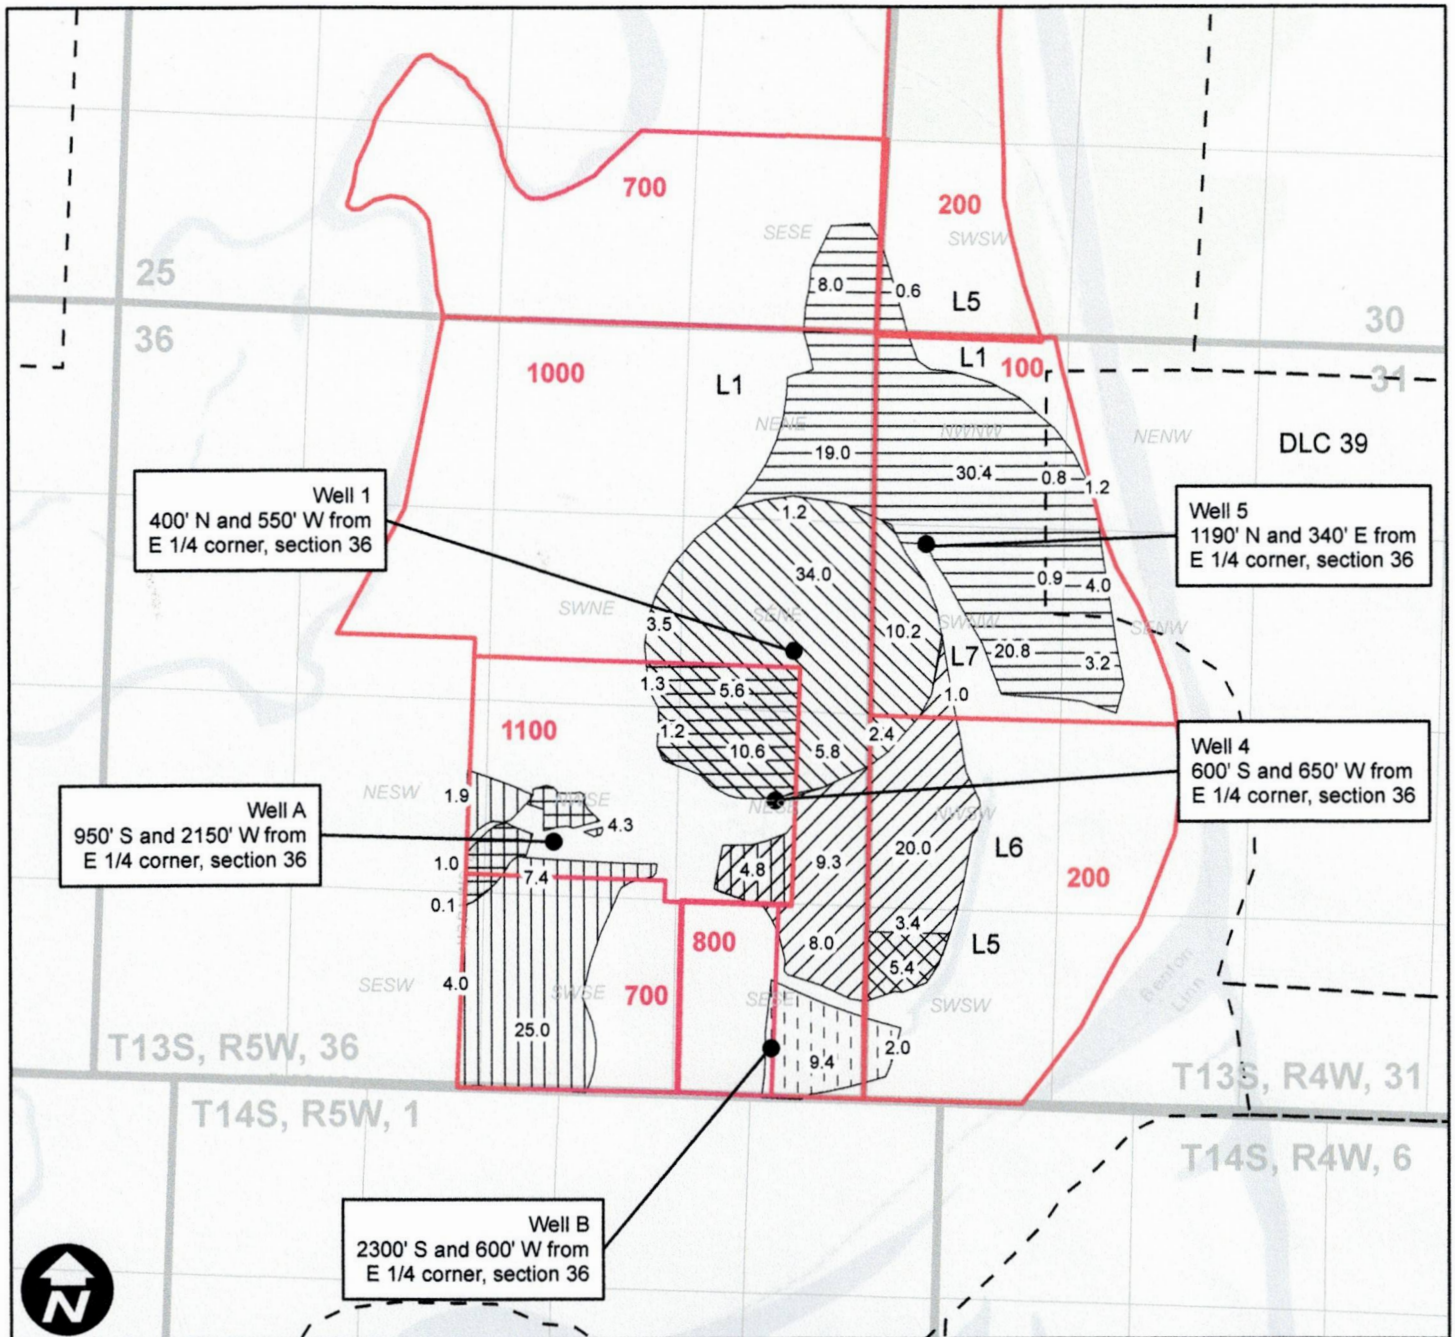

Legend

- No Change 82863 - Well 1 POU
- Cert. 82863 POA Change Only (Well 1 Authorized, Well 4/A Proposed)
- No Change 82863 - Well 4 POU
- Cert. 82863 POA Change Only (Well 4 Authorized, Well 1/5/B Proposed)
- No Change 82863 - Well 5 POU
- Cert. 82863 From - POU
- No Change 82863 - Well A POU
- Cert. 82863 To - POU/APOA (Well A)
- No Change 82863 - Well B POU
- DLC
- Tax Lot



EXPIRES: 12-31-2026



Transfer Application - Certificate 82864 IGH Properties Inc.

RECEIVED

JUL 26 2022



OWRD

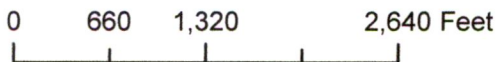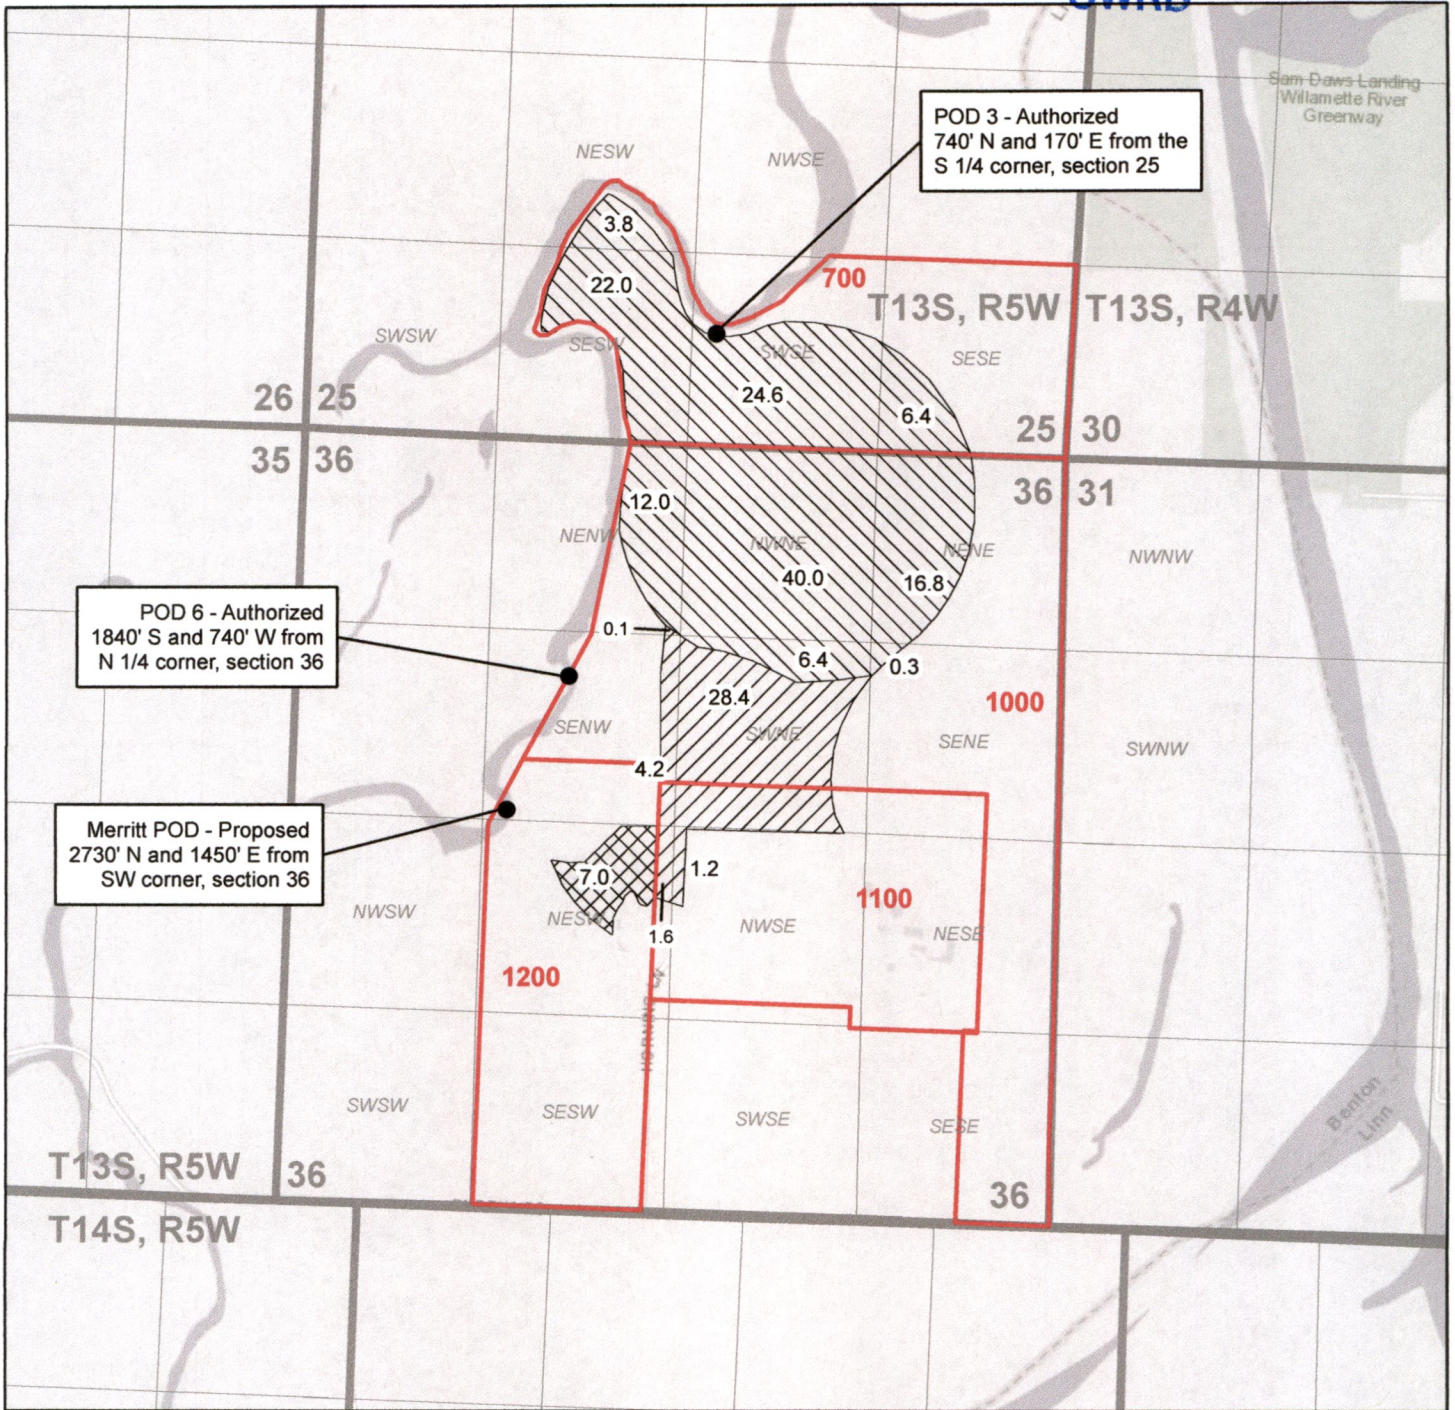

Legend

-  Transfer Cert. 82864 - APOD
-  Cert. 82864 - POD 6 POU
-  Cert. 82864 - POD 3 POU
-  Tax Lot





14053

EXPIRES: 12-31-2022

Transfer Application - Certificate 82865
 IGH Properties Inc.

RECEIVED

JUL 26 2022

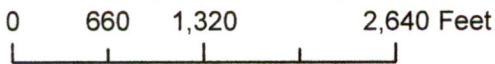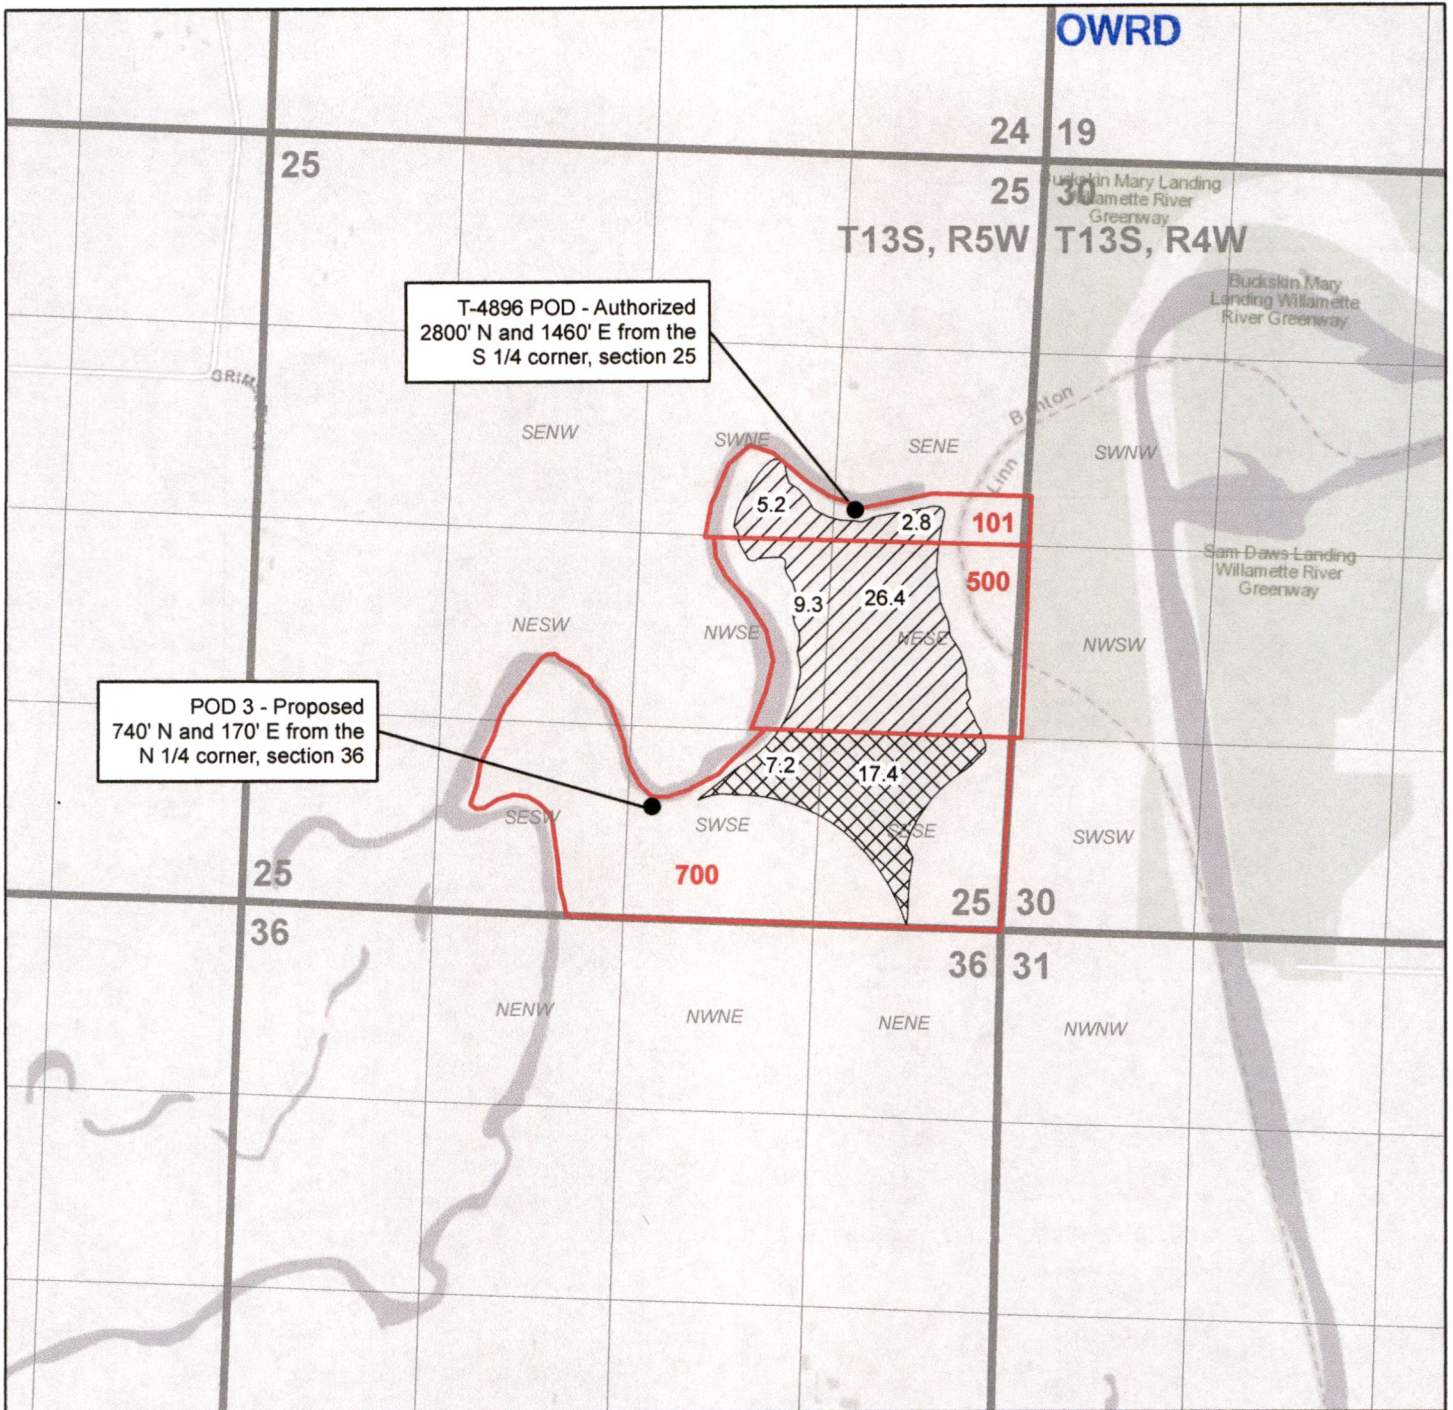

Legend

- Transfer Cert. 82865 - Change POD
- Cert. 82865 - No Change
- Tax Lot




Transfer Application - Certificate 82863

IGH Properties Inc.

SUPERSEDED
RECEIVED

0 660 1,320 2,640 Feet
JUL 26 2022

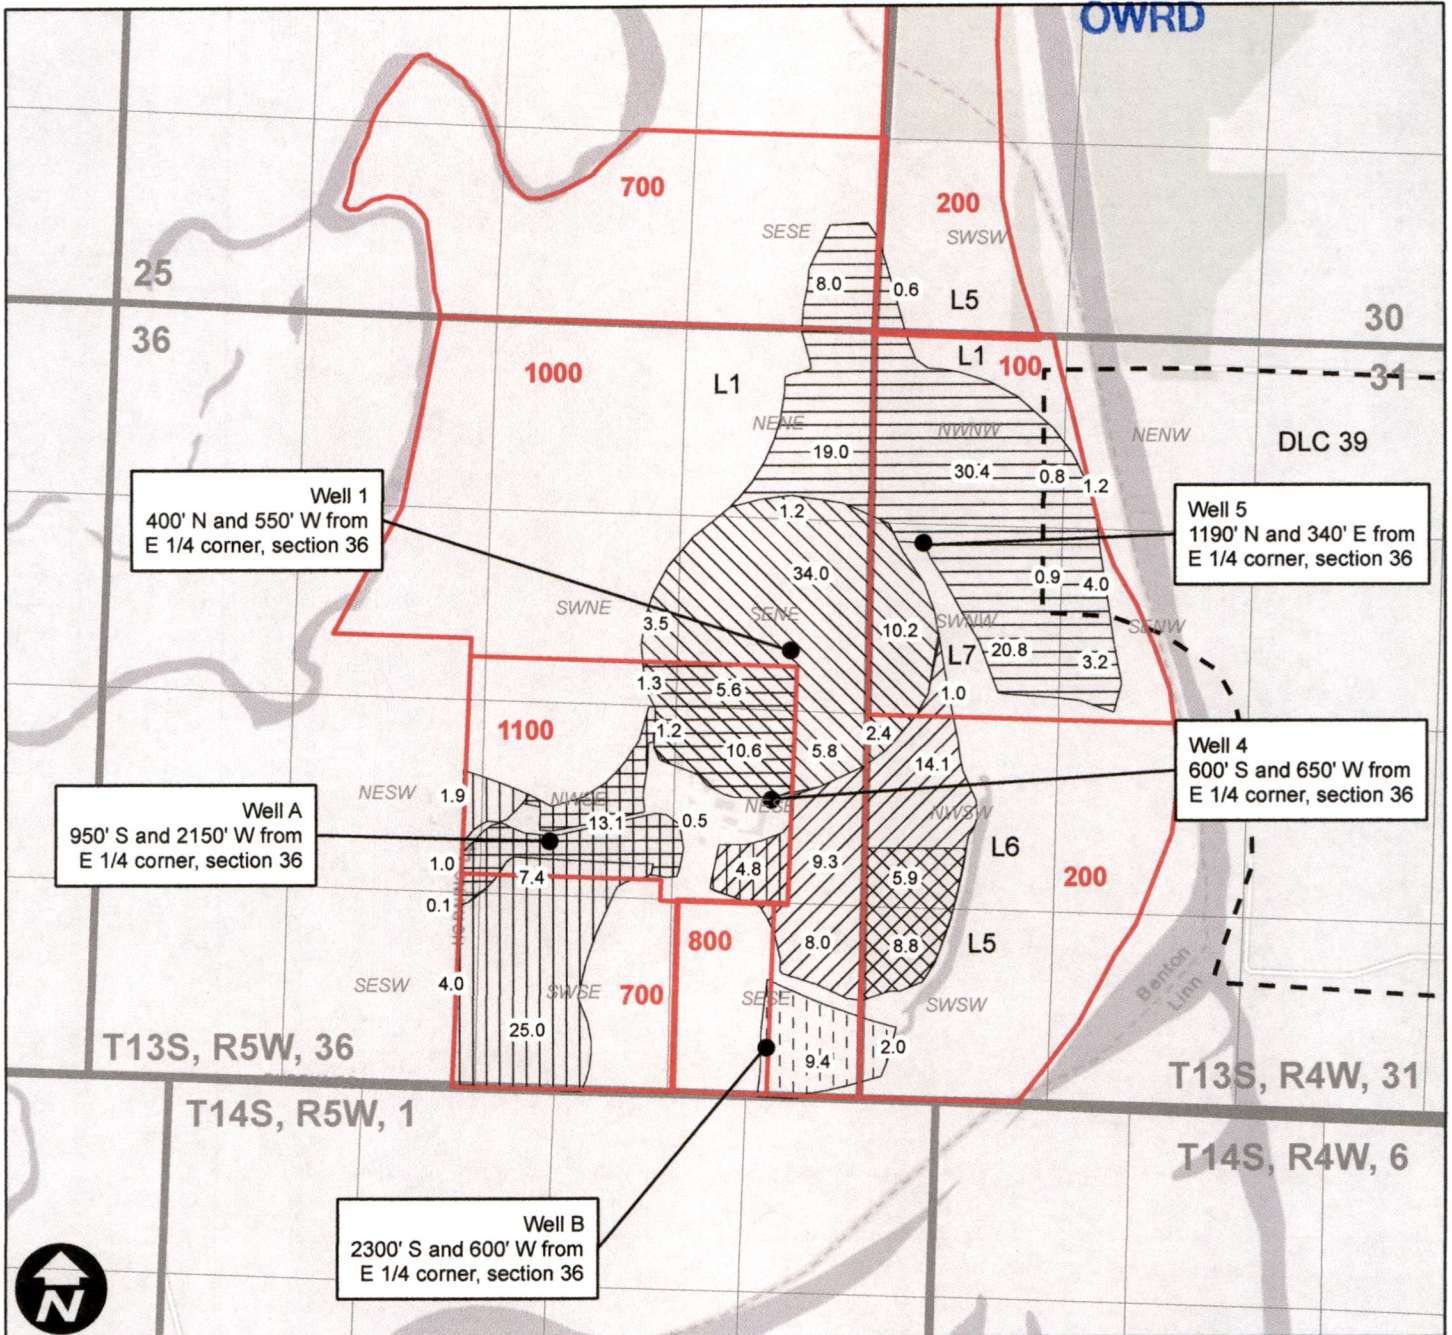

Legend

- | | | | |
|--|------------------------------|--|--|
| | No Change 82863 - Well 1 POU | | Cert. 82863 POA Change Only (Well 1 Authorized, Well 4/A Proposed) |
| | No Change 82863 - Well 4 POU | | Cert. 82863 POA Change Only (Well 4 Authorized, Well 1/5/B Proposed) |
| | No Change 82863 - Well 5 POU | | Cert. 82863 To - POU/APOA (Well A) |
| | No Change 82863 - Well A POU | | Cert. 82863 From - POU |
| | No Change 82863 - Well B POU | | DLC |
| | Tax Lot | | |

14053

