



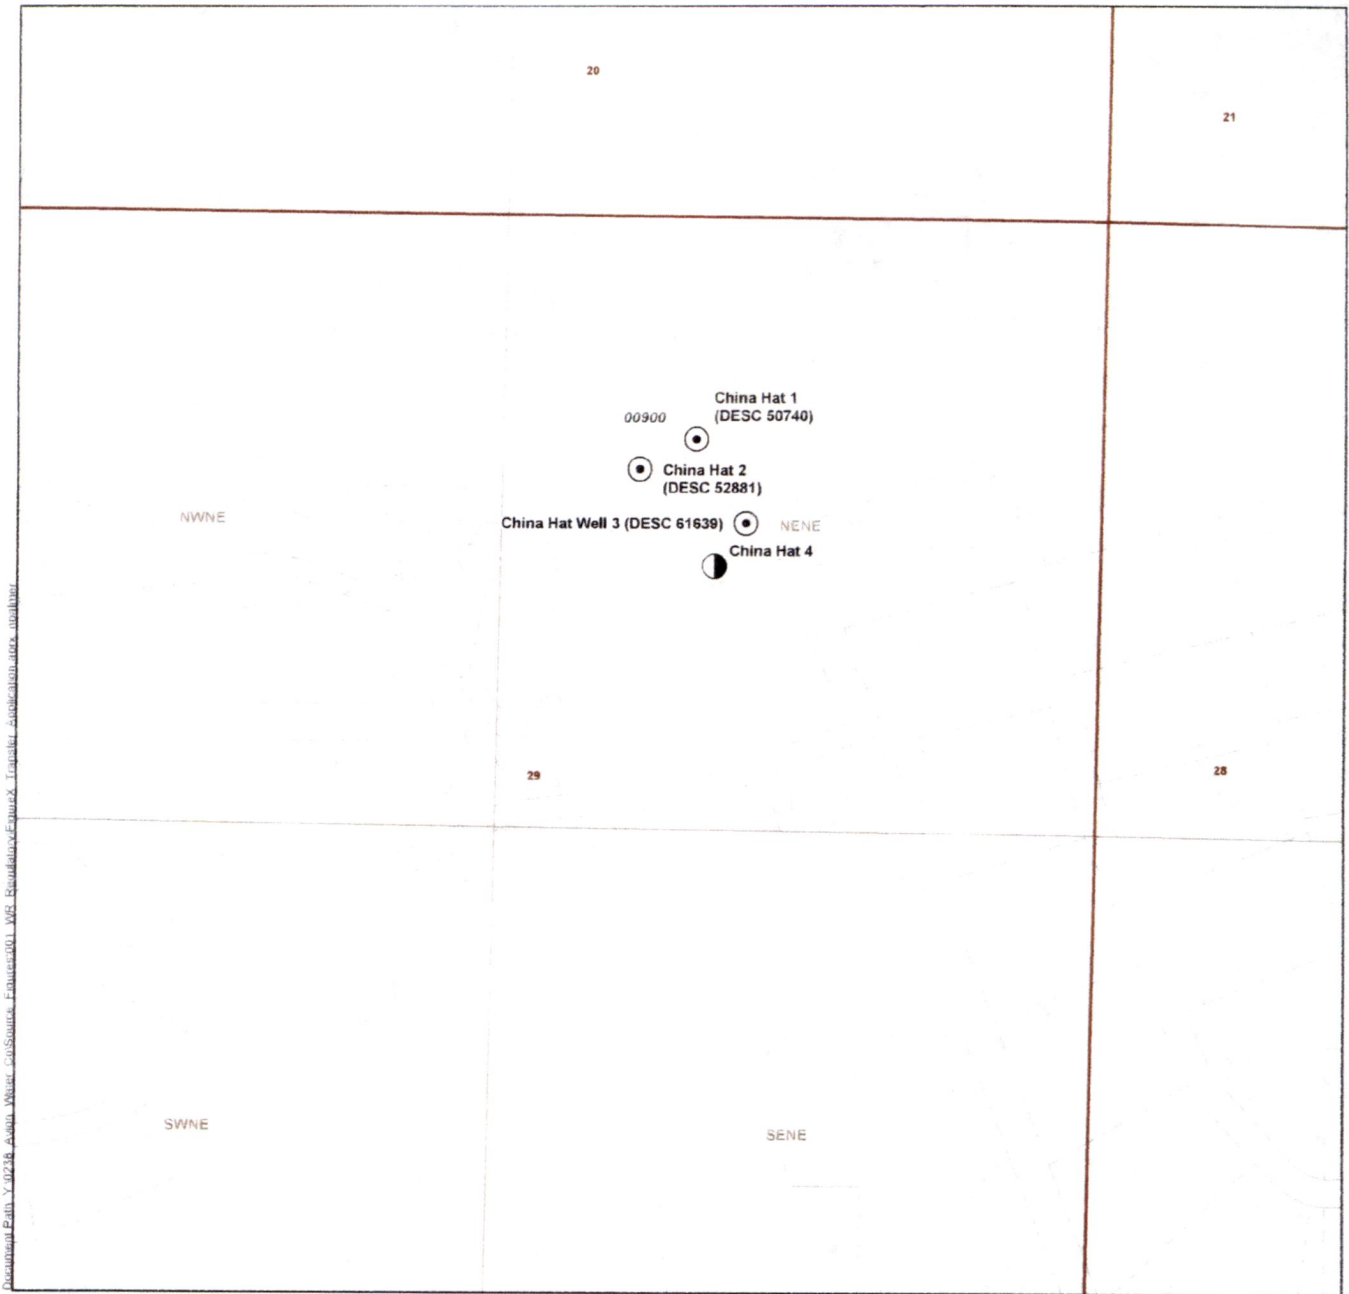

LEGEND

- Proposed Additional Point of Appropriation (POA)
- Authorized Point of Appropriation (POA)
- Tax Lot
- Watercourse
- Waterbody

CERTIFIED WATER RIGHTS EXAMINER STAMP

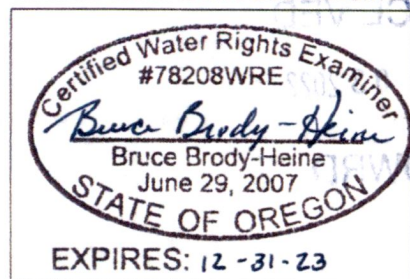

POA LOCATION DESCRIPTION

Proposed Additional POAs

China Hat 4: Located 760 feet South and 840 feet West from the NE corner of Section 29.

Authorized POAs

China Hat 1 (DESC 50740): Located 400 feet South and 900 feet West from the NE corner of Section 29.

China Hat 2 (DESC 52881): Located 400 feet South and 1024 feet West from the NE corner of Section 29.

China Hat 3 (DESC 61639): Located 663 feet South and 771 feet West from the NE corner of Section 29.

Transfer Application for Certificate 96354 Avion Water Company, Inc. Points of Appropriation Map

Deschutes County Oregon
Township 18 South Range 12 East (W.M.)

RECEIVED


OCT 03 2022

OWRD

DISCLAIMER

This map was prepared for the purpose of identifying the location of a water right only and it is not intended to provide legal dimensions or location of property ownership lines.


Date: July 19, 2022
Data Sources: BLM, ESRI, OWRD, USGS

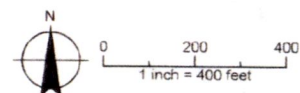

14104

RECEIVED
OCT 03 2022
OWRD

GREATER AVION
SYSTEM OVERVIEW MAP
Proposed Place of Use
Groundwater Application

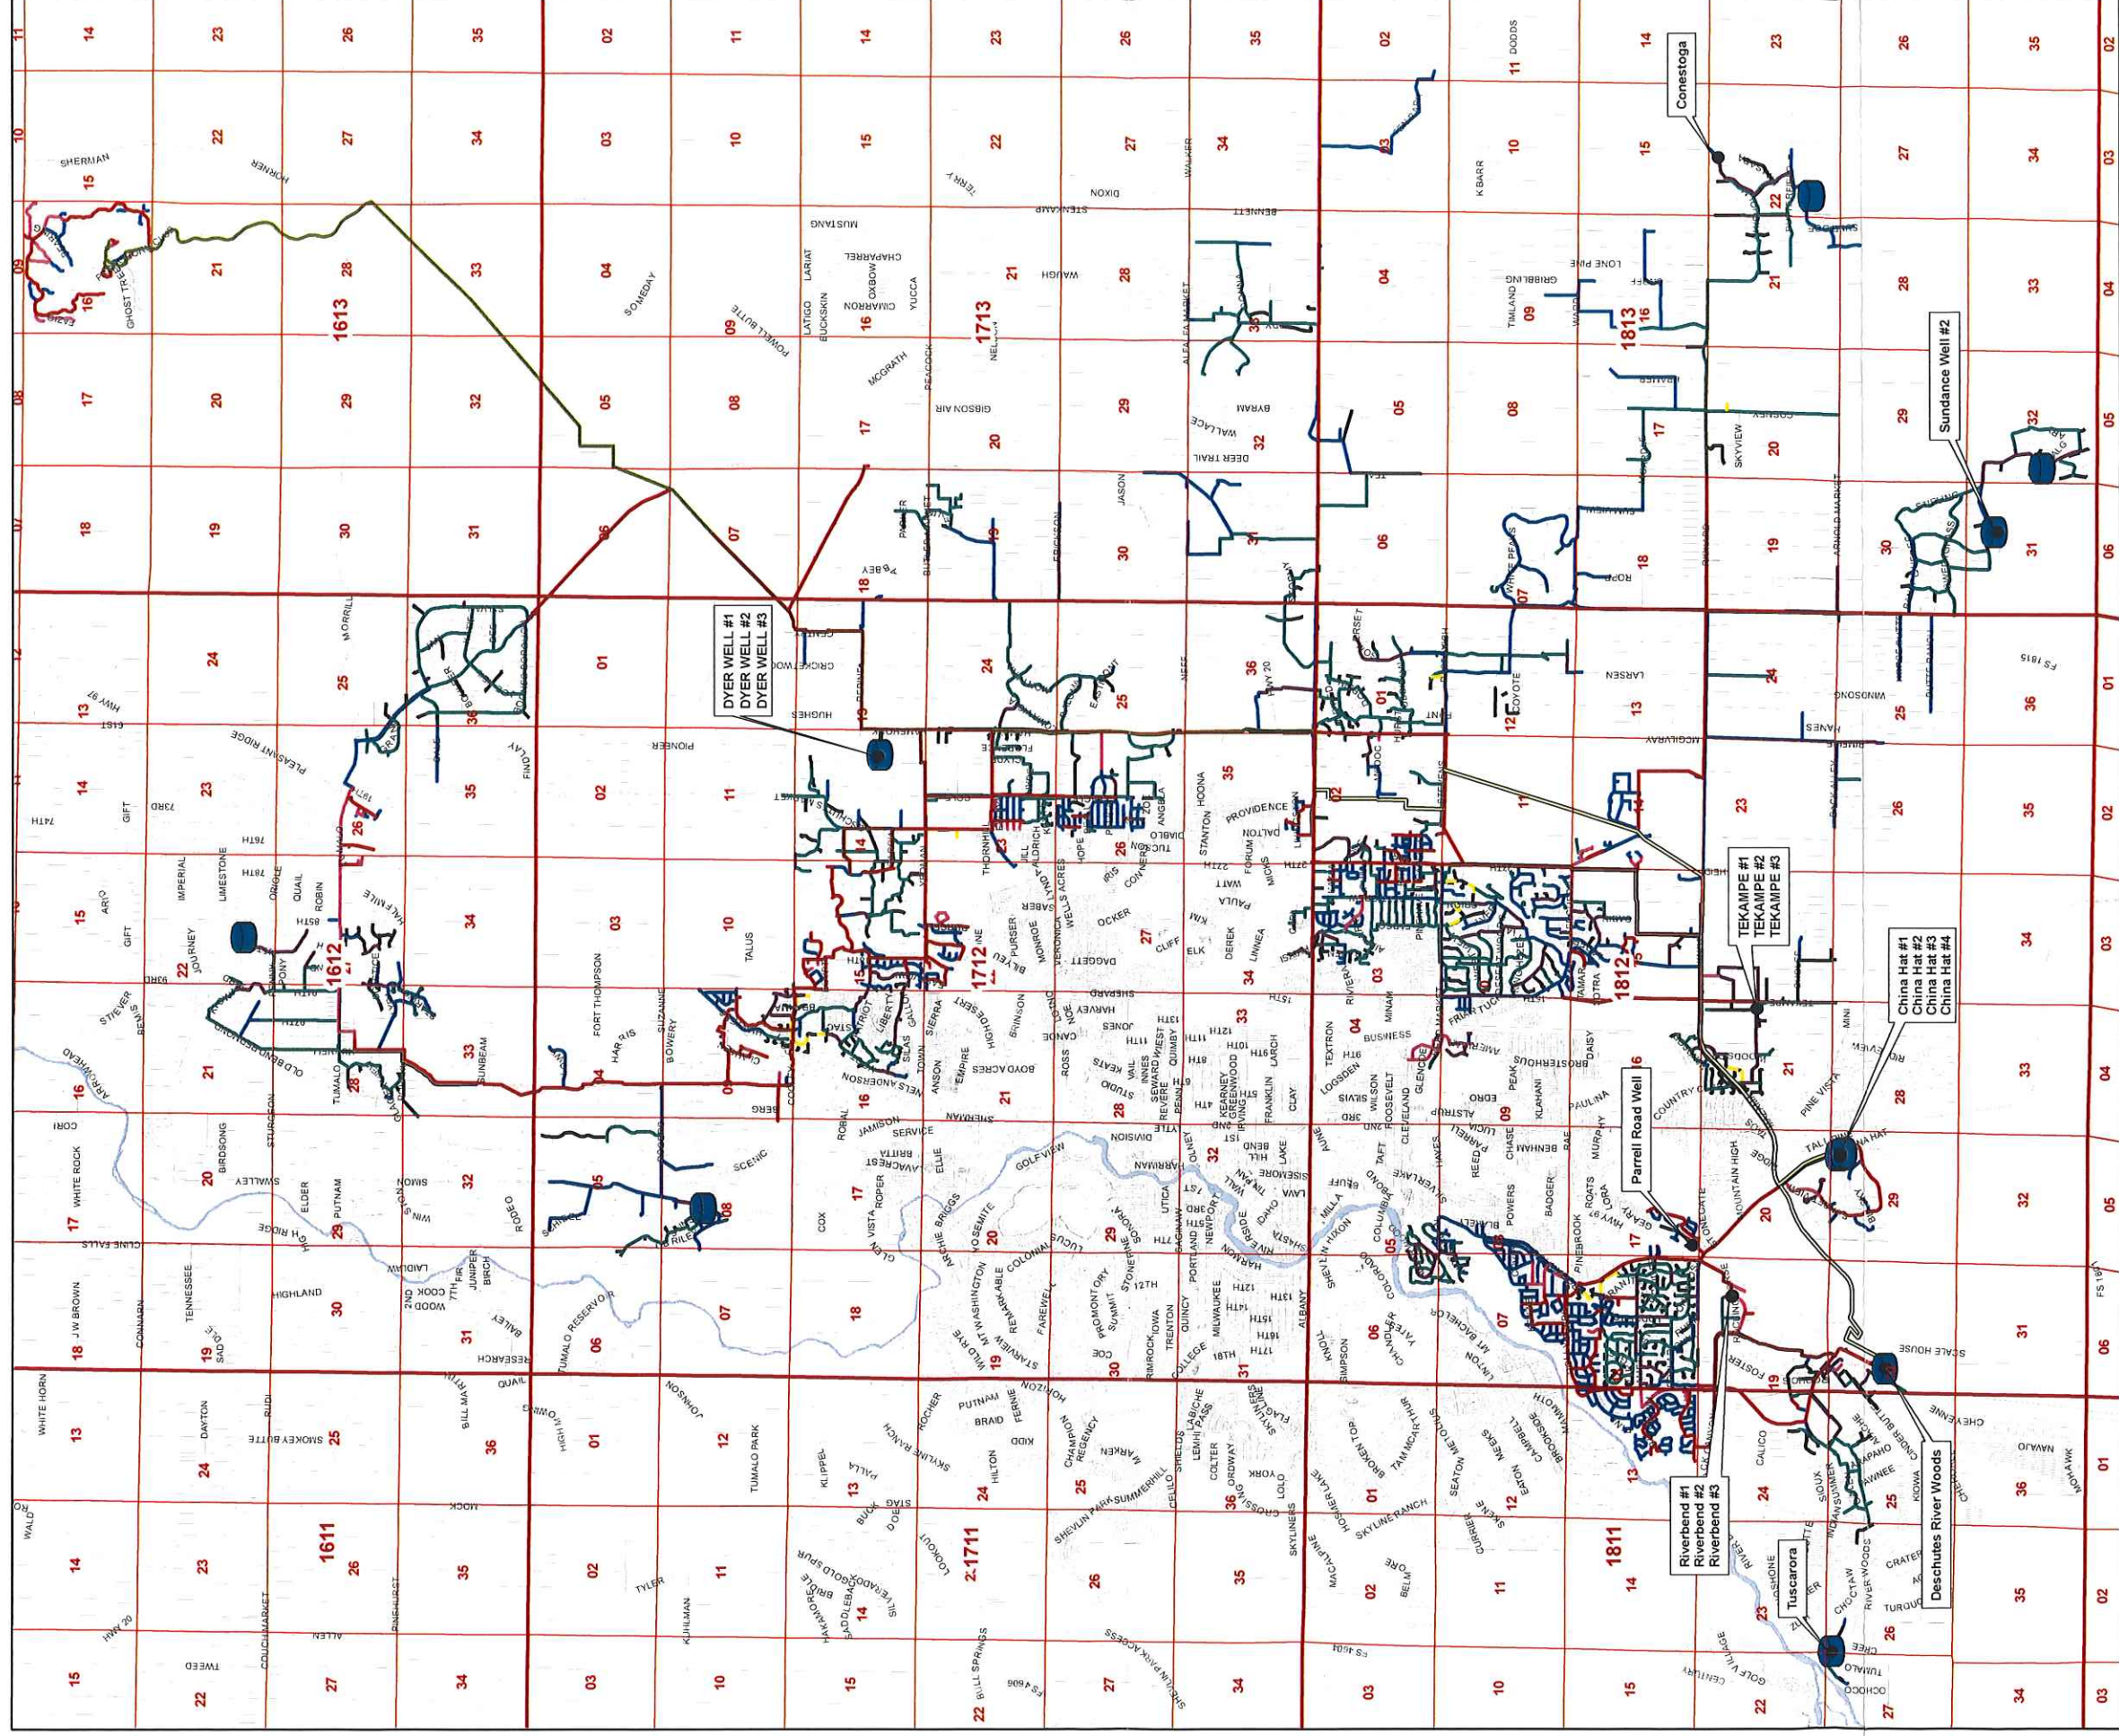

1 inch = 7,000 feet




- Points of Appropriation
- Storage

DRAWN BY: TANNER LEMMON
AVION WATER GIS DEPARTMENT
JULY, 2012

DISCLAIMER:
This map was prepared for the purpose
of identifying the location of water rights
only and is not intended to provide legal
dimensions or locations of property
ownership lines.

- 24-dom — 12-dom — 4-dom
- 20-dom — 10-dom — 3-dom
- 18-dom — 8-dom — 2-dom
- 16-dom — 6-dom
- 14-dom — 5-dom

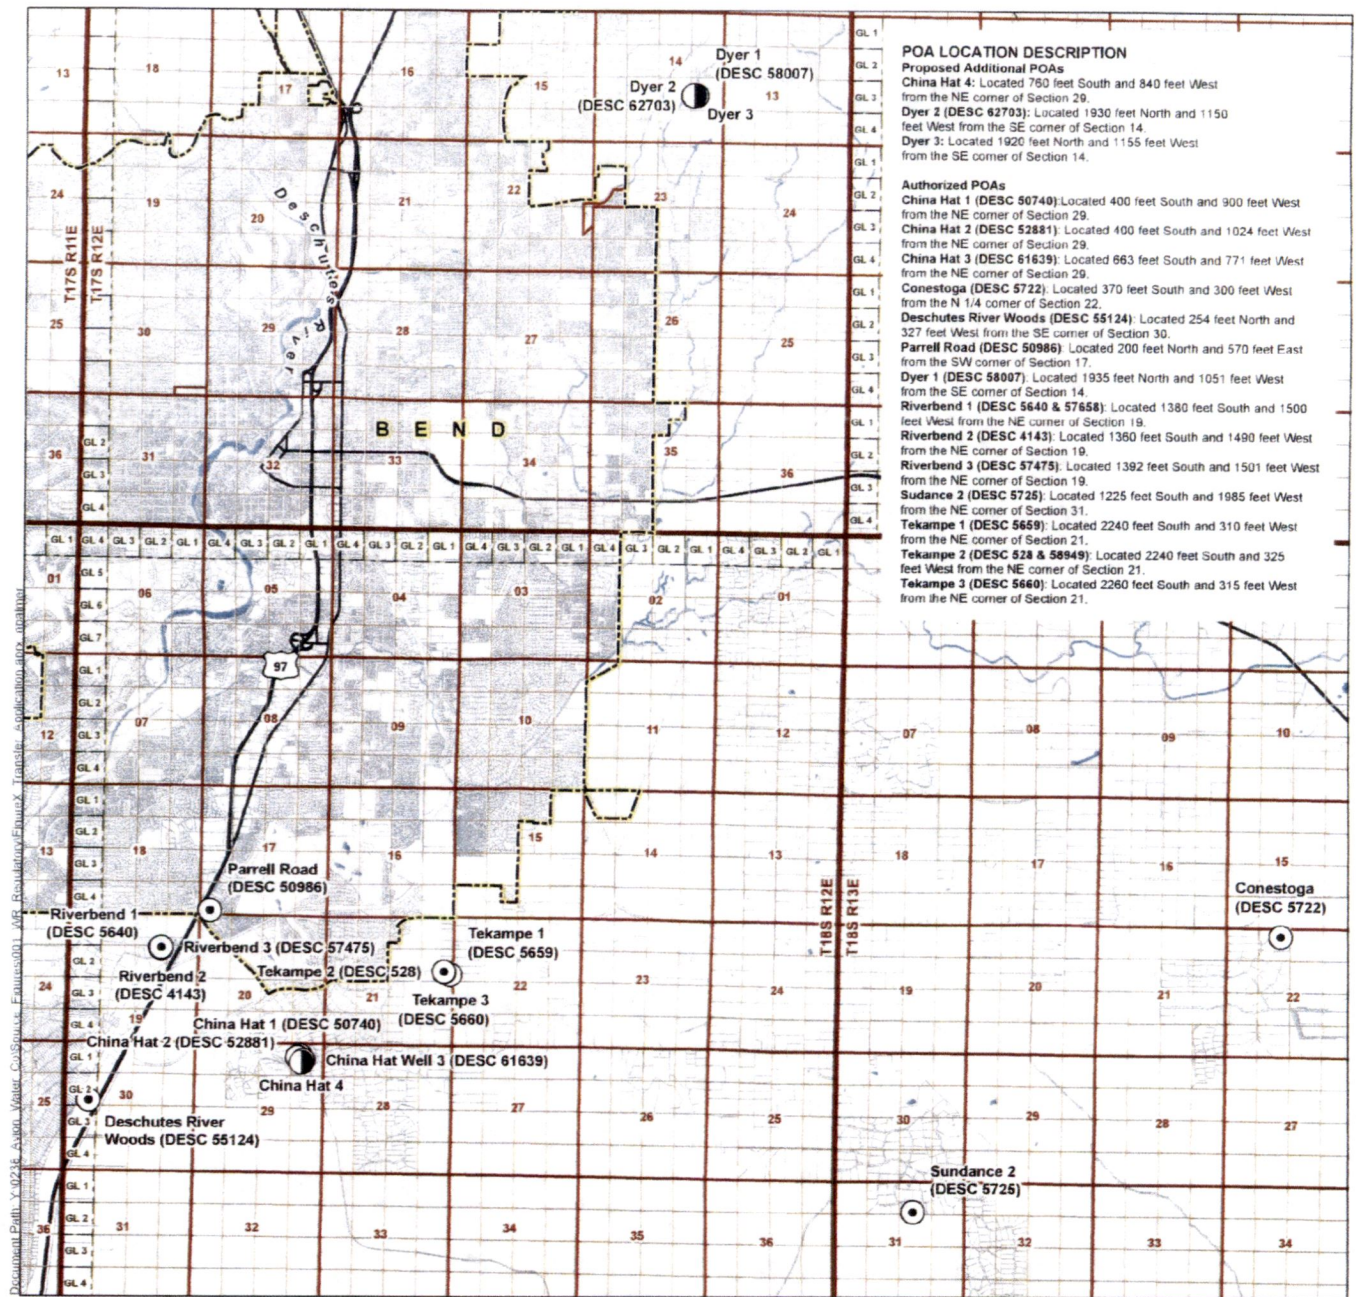


LEGEND

- Proposed Additional Point of Appropriation (POA)
- ⊙ Authorized Point of Appropriation (POA)
- Tax Lot
- Government Lot (GL)
- City Boundary
- Major Road
- Watercourse
- Waterbody

Transfer Application for Certificate 96354 Avion Water Company, Inc. Points of Appropriation Map

Deschutes County Oregon
Township 17/18 South Range 12/13 East (W.M.)


CERTIFIED WATER RIGHTS EXAMINER STAMP

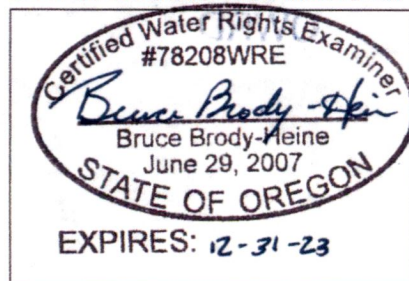

RECEIVED

OCT 03 2022

OWRD

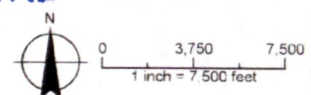

DISCLAIMER

This map was prepared for the purpose of identifying the location of a water right only and it is not intended to provide legal dimensions or location of property ownership lines.

Date: July 19, 2022

Data Sources: BLM, ESRI, OWRD, USGS




AVION WATER CO, INC.
PLACE OF USE
 APPLICATION G-12924, PERMIT G-12788
 PERMIT AMENDMENTS T-7778; T-10407
 DESCHUTES COUNTY



1 inch equals 10,560 feet
 0 0.5 1 2 Miles

DISCLAIMER:
 This map was prepared for the purpose of identifying the location of water rights only and is not intended to provide legal dimensions or locations of property ownership lines.

DRAWN BY: TANNER LEMMON
 AVION WATER GIS DEPARTMENT
 MARCH, 2008

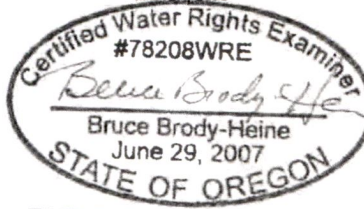

EXPIRES: 12-31-09


NOTE:
 REFER TO THE OVERVIEW MAP
 IN ATTACHMENT 1 FOR
 TAX LOT INFORMATION.

This QtrQtr is not part of the POU.

PLACE OF USE

14104


RECEIVED
OCT 03 2022
OWRD

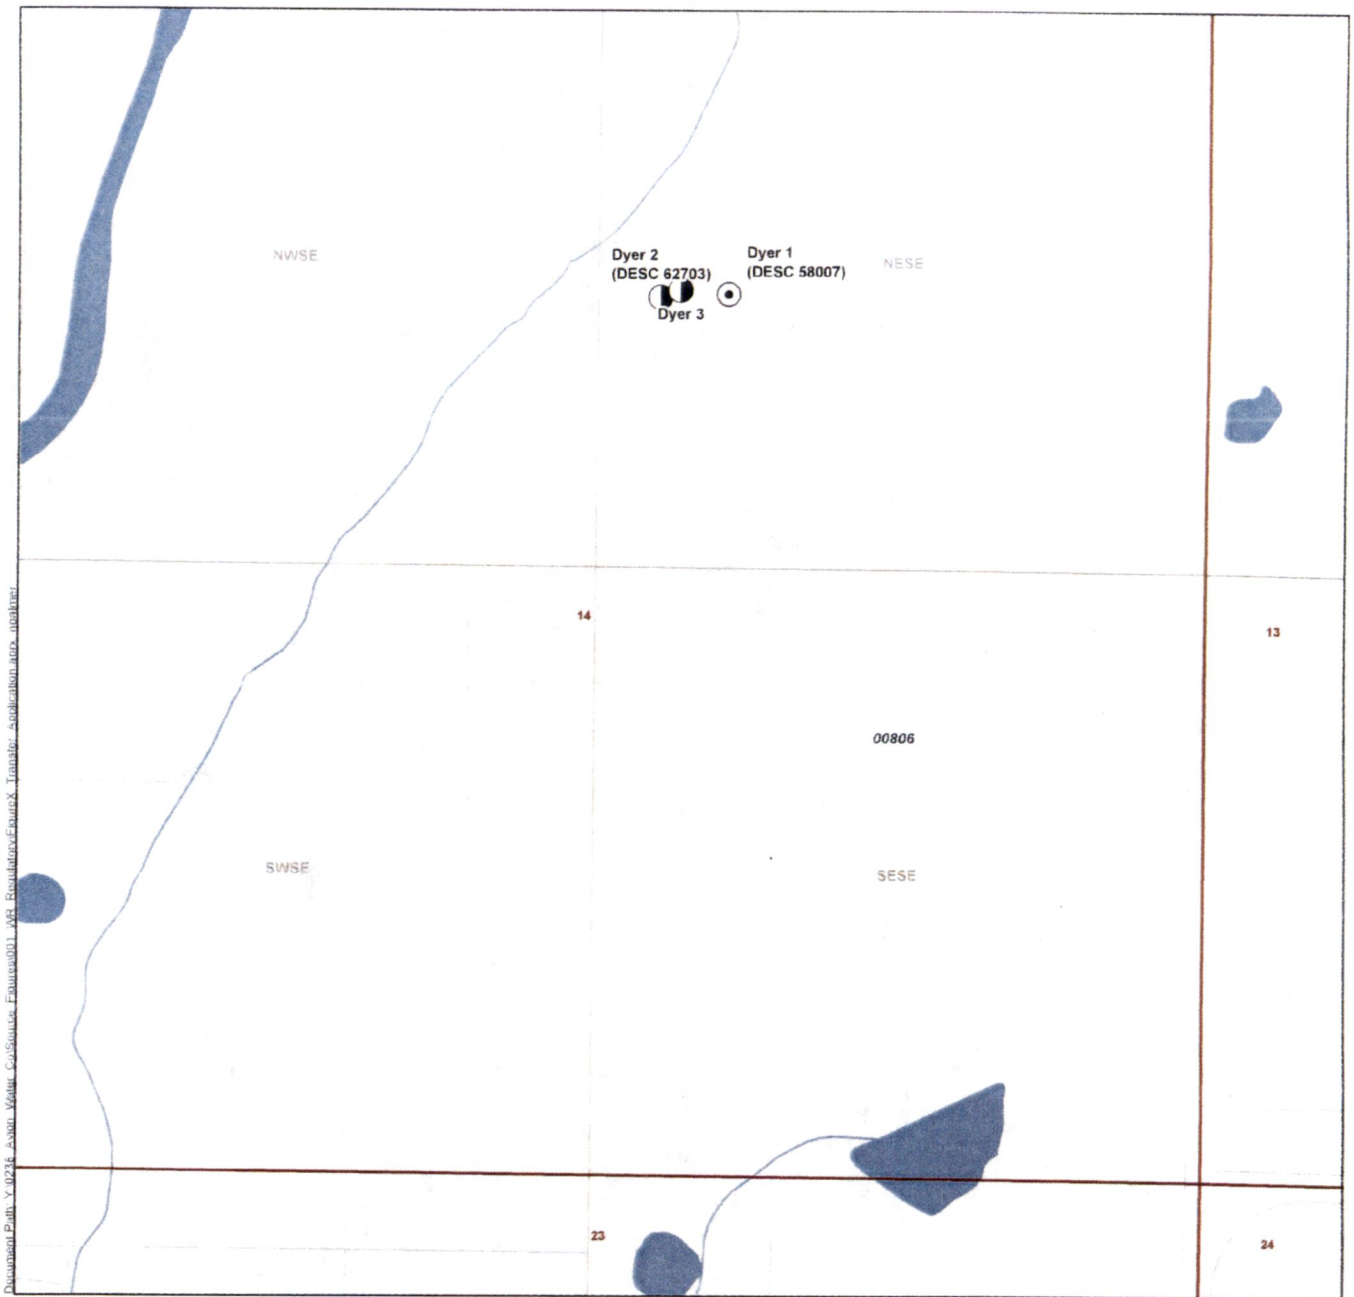

LEGEND

- Proposed Additional Point of Appropriation (POA)
- Authorized Point of Appropriation (POA)
- Tax Lot
- Watercourse
- Waterbody

CERTIFIED WATER RIGHTS EXAMINER STAMP

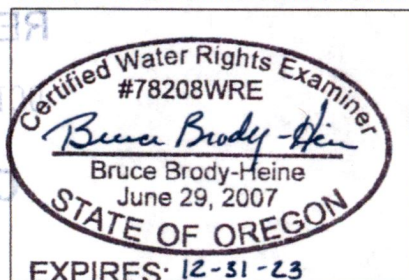

Transfer Application for Certificate 96354 Avion Water Company, Inc. Points of Appropriation Map

Deschutes County Oregon
Township 17 South Range 12 East (W.M.)

RECEIVED

OCT 03 2022

OWRD

POA LOCATION DESCRIPTION

Proposed Additional POAs

Dyer 2 (DESC 62703): Located 1930 feet North and 1150 feet West from the SE corner of Section 14.
Dyer 3: Located 1920 feet North and 1155 feet West from the SE corner of Section 14.

Authorized POAs


Dyer 1 (DESC 58007): Located 1935 feet North and 1051 feet West from the SE corner of Section 14.


DISCLAIMER

This map was prepared for the purpose of identifying the location of a water right only and it is not intended to provide legal dimensions or location of property ownership lines.

Date: July 19, 2022

Data Sources: BLM, ESRI, OWRD, USGS

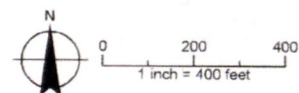


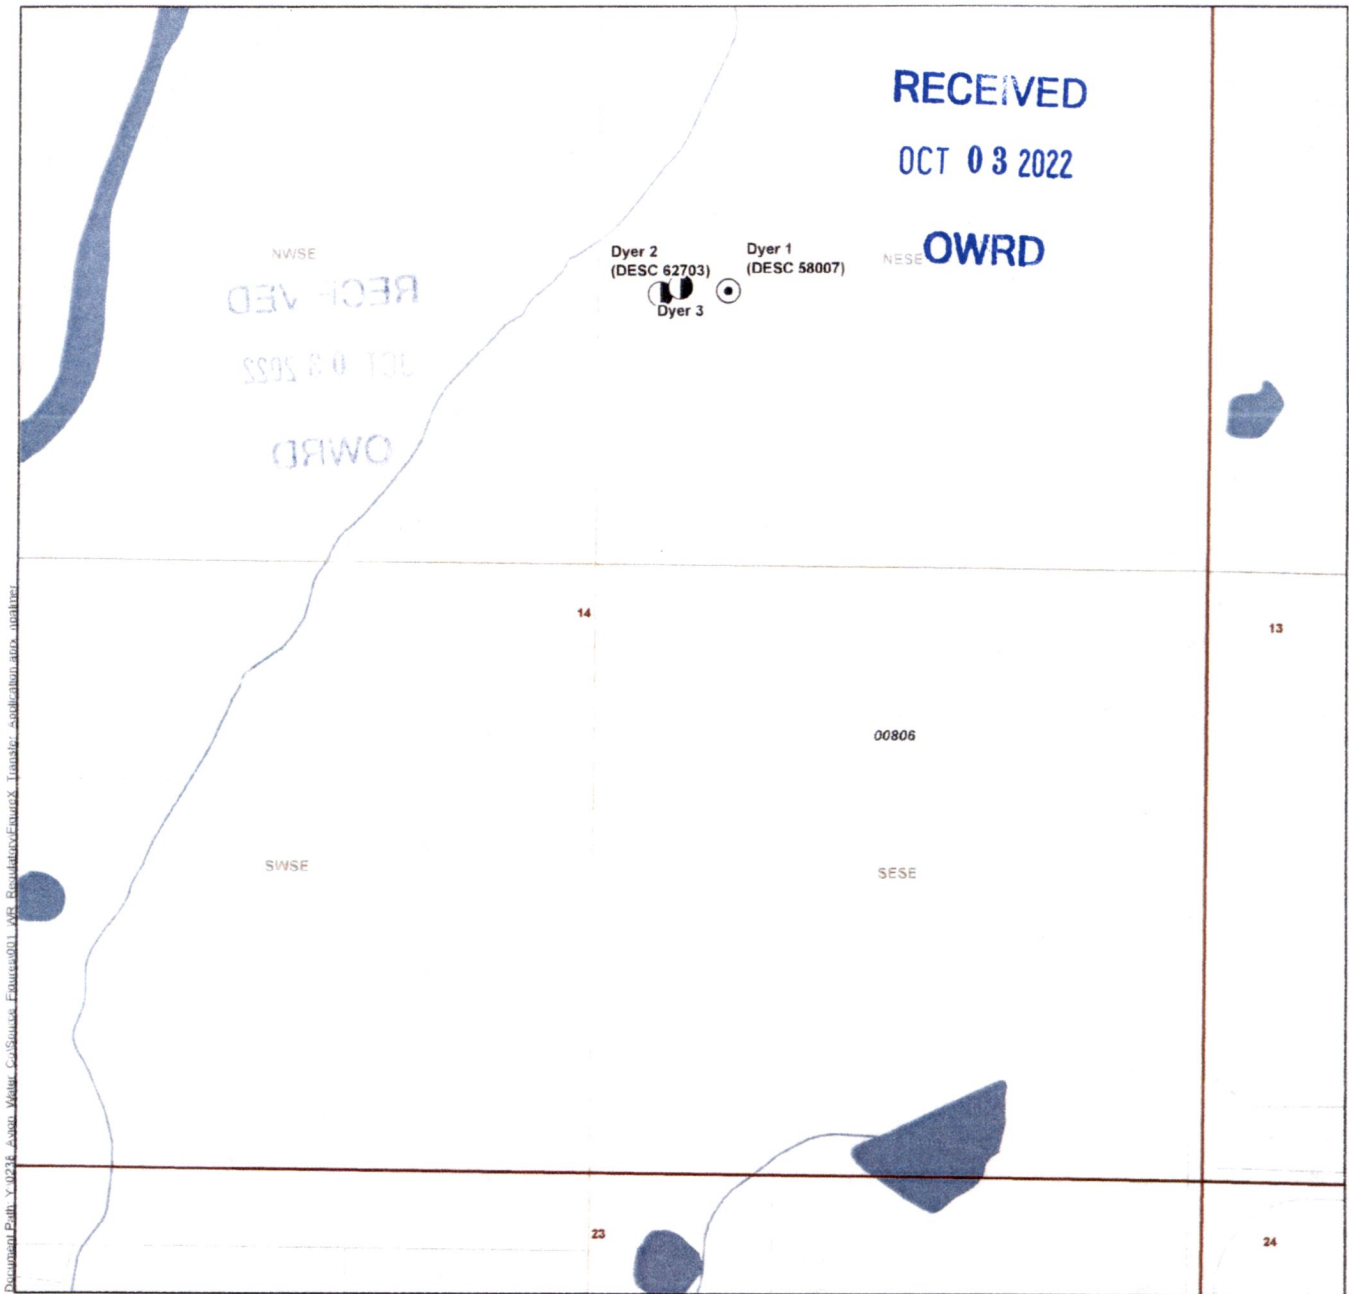

LEGEND

- Proposed Additional Point of Appropriation (POA)
- Authorized Point of Appropriation (POA)
- Tax Lot
- Watercourse
- Waterbody

CERTIFIED WATER RIGHTS EXAMINER STAMP

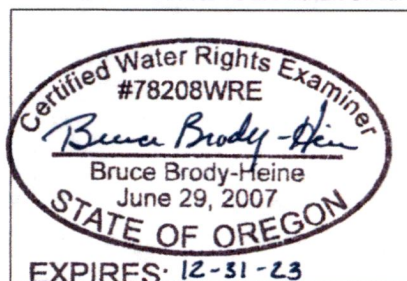

POA LOCATION DESCRIPTION

Proposed Additional POAs

Dyer 2 (DESC 62703): Located 1930 feet North and 1150 feet West from the SE corner of Section 14.

Dyer 3: Located 1920 feet North and 1155 feet West from the SE corner of Section 14.

Authorized POAs

Dyer 1 (DESC 58007): Located 1935 feet North and 1051 feet West from the SE corner of Section 14.

Transfer Application for Certificate 96354 Avion Water Company, Inc. Points of Appropriation Map

Deschutes County Oregon
Township 17 South Range 12 East (W.M.)

14104

DISCLAIMER

This map was prepared for the purpose of identifying the location of a water right only and it is not intended to provide legal dimensions or location of property ownership lines.


Date: July 19, 2022

Data Sources: BLM, ESRI, OWRD, USGS



0 200 400
1 inch = 400 feet




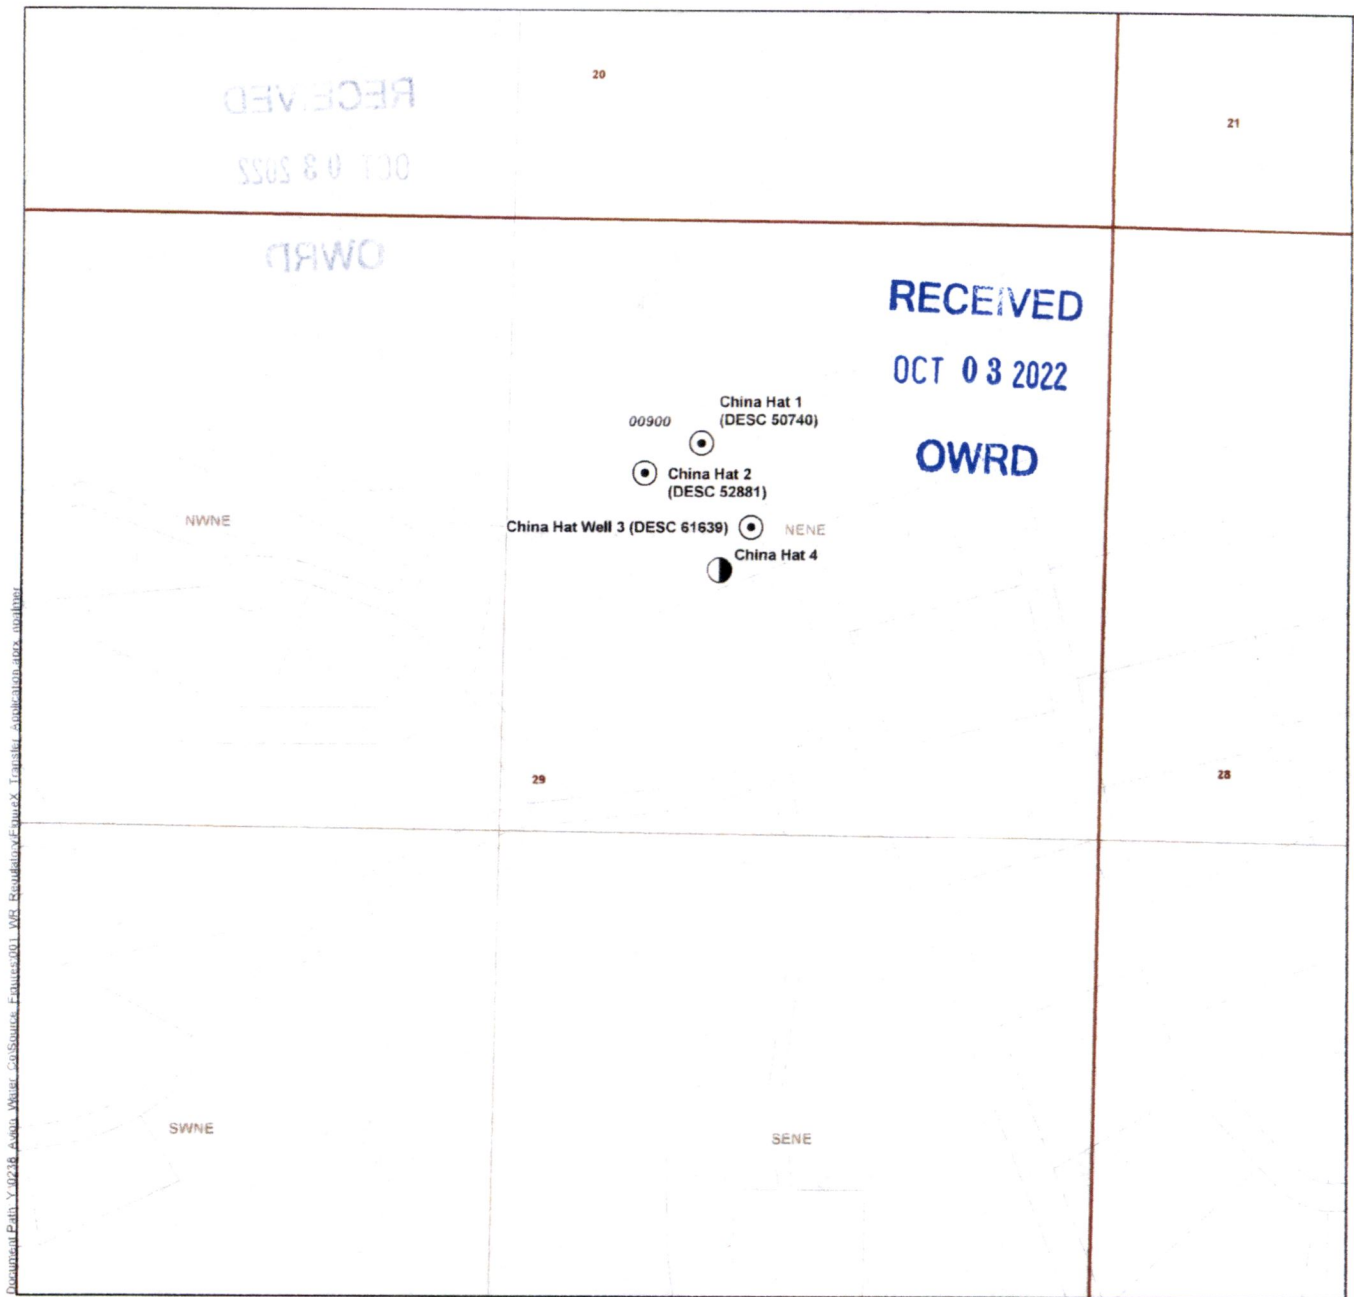

LEGEND

- Proposed Additional Point of Appropriation (POA)
- Authorized Point of Appropriation (POA)
- Tax Lot
- Watercourse
- Waterbody

CERTIFIED WATER RIGHTS EXAMINER STAMP

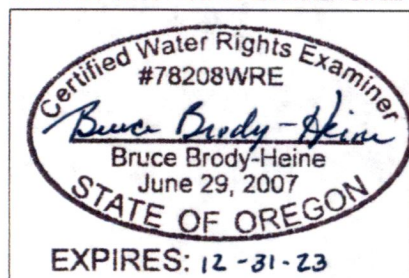

POA LOCATION DESCRIPTION

Proposed Additional POAs

China Hat 4: Located 760 feet South and 840 feet West from the NE corner of Section 29.

Authorized POAs

China Hat 1 (DESC 50740): Located 400 feet South and 900 feet West from the NE corner of Section 29.
China Hat 2 (DESC 52881): Located 400 feet South and 1024 feet West from the NE corner of Section 29.
China Hat 3 (DESC 61639): Located 663 feet South and 771 feet West from the NE corner of Section 29.

Transfer Application for Certificate 96354 Avion Water Company, Inc. Points of Appropriation Map


Deschutes County Oregon
Township 18 South Range 12 East (W.M.)


DISCLAIMER

This map was prepared for the purpose of identifying the location of a water right only and it is not intended to provide legal dimensions or location of property ownership lines.

Date: July 19, 2022

Data Sources: BLM, ESRI, OWRD, USGS

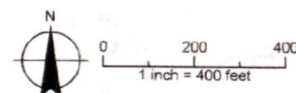

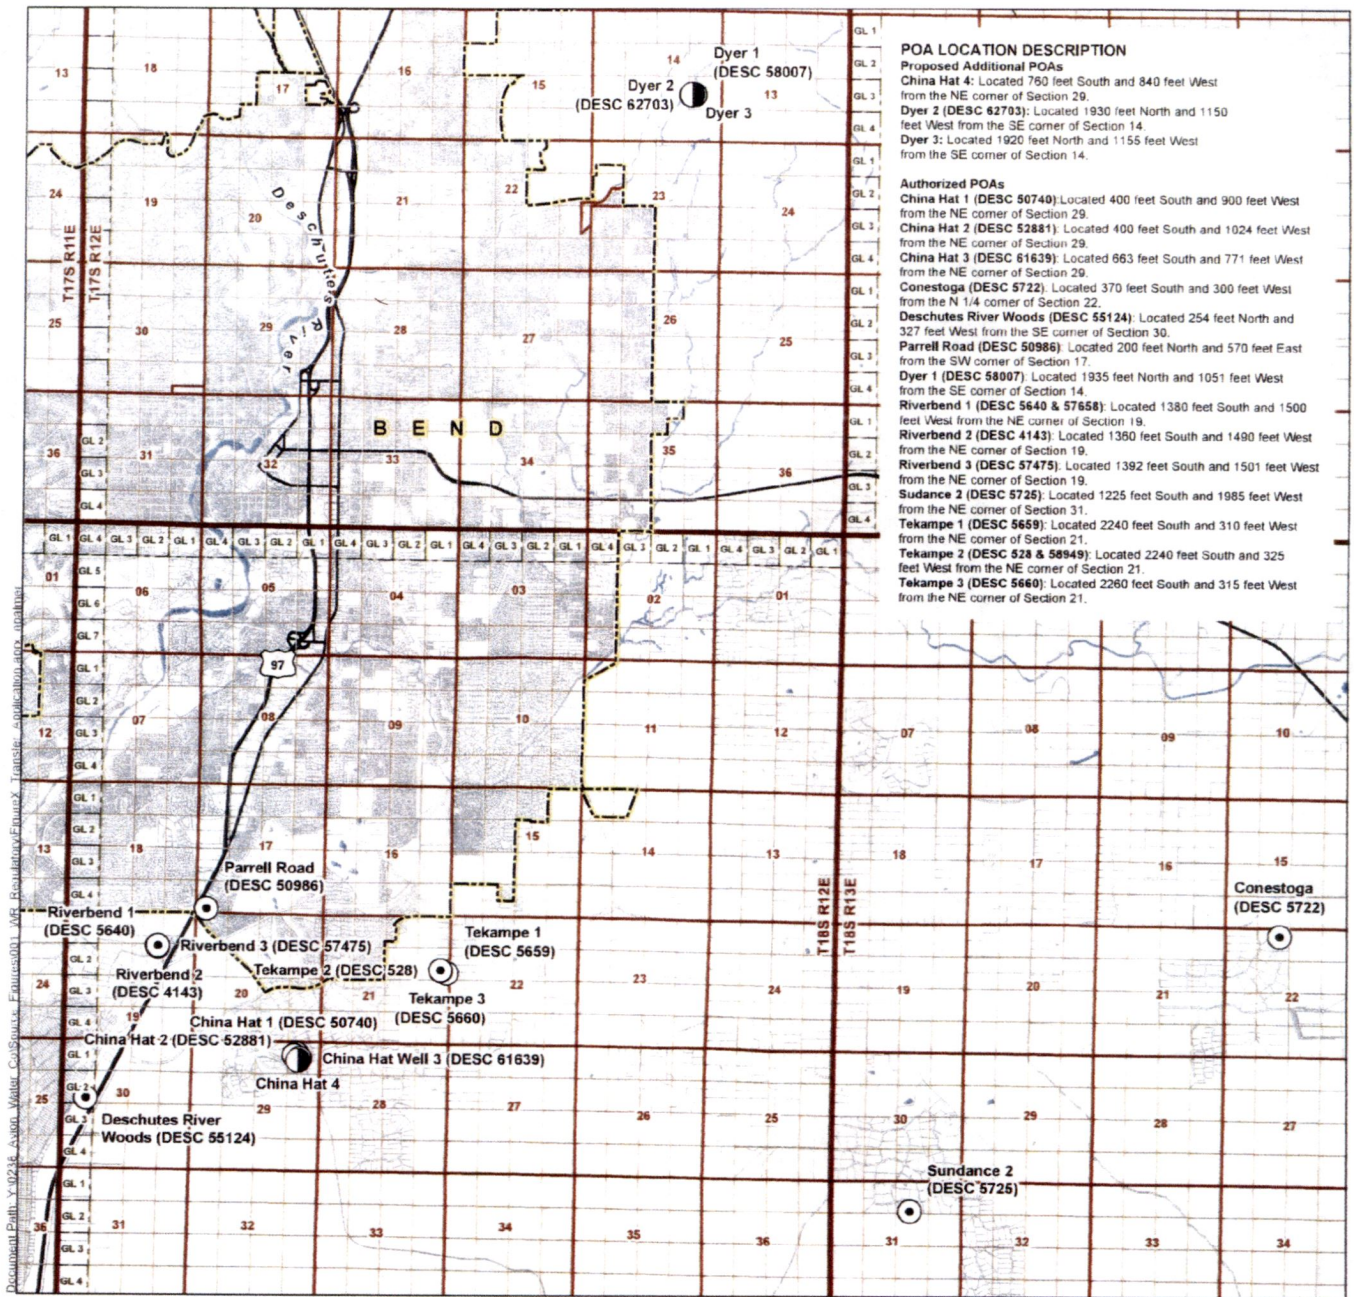

POA LOCATION DESCRIPTION

Proposed Additional POAs

China Hat 4: Located 760 feet South and 840 feet West from the NE corner of Section 29.
Dyer 2 (DESC 62703): Located 1930 feet North and 1150 feet West from the SE corner of Section 14.
Dyer 3: Located 1920 feet North and 1155 feet West from the SE corner of Section 14.

Authorized POAs

China Hat 1 (DESC 50740): Located 400 feet South and 900 feet West from the NE corner of Section 29.
China Hat 2 (DESC 52881): Located 400 feet South and 1024 feet West from the NE corner of Section 29.
China Hat 3 (DESC 61639): Located 663 feet South and 771 feet West from the NE corner of Section 29.
Conestoga (DESC 5722): Located 370 feet South and 300 feet West from the N 1/4 corner of Section 22.
Deschutes River Woods (DESC 55124): Located 254 feet North and 327 feet West from the SE corner of Section 30.
Parrell Road (DESC 50986): Located 200 feet North and 570 feet East from the SW corner of Section 17.
Dyer 1 (DESC 58007): Located 1935 feet North and 1051 feet West from the SE corner of Section 14.
Riverbend 1 (DESC 5640 & 57658): Located 1380 feet South and 1500 feet West from the NE corner of Section 19.
Riverbend 2 (DESC 4143): Located 1350 feet South and 1490 feet West from the NE corner of Section 19.
Riverbend 3 (DESC 57475): Located 1392 feet South and 1501 feet West from the NE corner of Section 19.
Sundance 2 (DESC 5725): Located 1225 feet South and 1985 feet West from the NE corner of Section 31.
Tekampe 1 (DESC 5659): Located 2240 feet South and 310 feet West from the NE corner of Section 21.
Tekampe 2 (DESC 528 & 58949): Located 2240 feet South and 325 feet West from the NE corner of Section 21.
Tekampe 3 (DESC 5660): Located 2260 feet South and 315 feet West from the NE corner of Section 21.

LEGEND


- Proposed Additional Point of Appropriation (POA)
- ⊙ Authorized Point of Appropriation (POA)
- Tax Lot
- Government Lot (GL)
- City Boundary
- Major Road
- Watercourse
- Waterbody

RECEIVED

OCT 03 2022

OWRD

CERTIFIED WATER RIGHTS EXAMINER STAMP

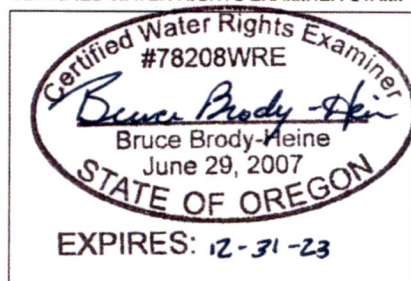

Transfer Application for Certificate 96354 Avion Water Company, Inc. Points of Appropriation Map

Deschutes County Oregon
Township 17/18 South Range 12/13 East (W.M.)

14104

DISCLAIMER

This map was prepared for the purpose of identifying the location of a water right only and it is not intended to provide legal dimensions or location of property ownership lines.

Date: July 19, 2022

Data Sources: BLM, ESRI, OWRD, USGS



0 3,750 7,500
1 inch = 7,500 feet



RECEIVED

OCT 03 2022

OWRD

AVION WATER CO, INC.

PLACE OF USE

APPLICATION G-12924, PERMIT G-12788

PERMIT AMENDMENTS T-7778; T-10407

DESCHUTES COUNTY




1 inch equals 10,560 feet

0 0.5 1 2 Miles

DISCLAIMER:

This map was prepared for the purpose of identifying the location of water rights only and is not intended to provide legal dimensions or locations of property ownership lines.

DRAWN BY: TANNER LEMMON
AVION WATER GIS DEPARTMENT
MARCH 2008

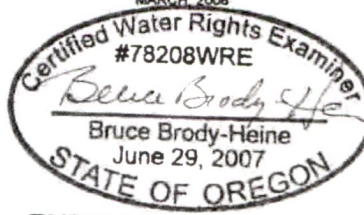

EXPIRES: 12-31-09

NOTE:

REFER TO THE OVERVIEW MAP
IN ATTACHMENT 1 FOR
TAX LOT INFORMATION.

This QtrQtr is not part
of the POU.

PLACE OF USE

14104