

PERMIT AMENDMENT MAP FOR  
CITY OF MONMOUTH  
MAY 5, 2023  
SCALE: 1" = 1320' 0"

APPLICATION: G-8926  
PERMIT NO: G-8579


 SIGNIFIES AREA OF POINT OF USE  
 CITY LIMITS  
 URBAN GROWTH BOUNDARY (WATER USE AREA)



NOTE: MAP IS FOR SOLE PURPOSE  
OF IDENTIFYING LOCATION OF WATER  
RIGHT AND HAS NO INTENT TO DIMENSION  
OR LOCATE ANY PROPERTY OWNERSHIP LINES

T8S, R4W W.M.

T8S, R5W W.M.

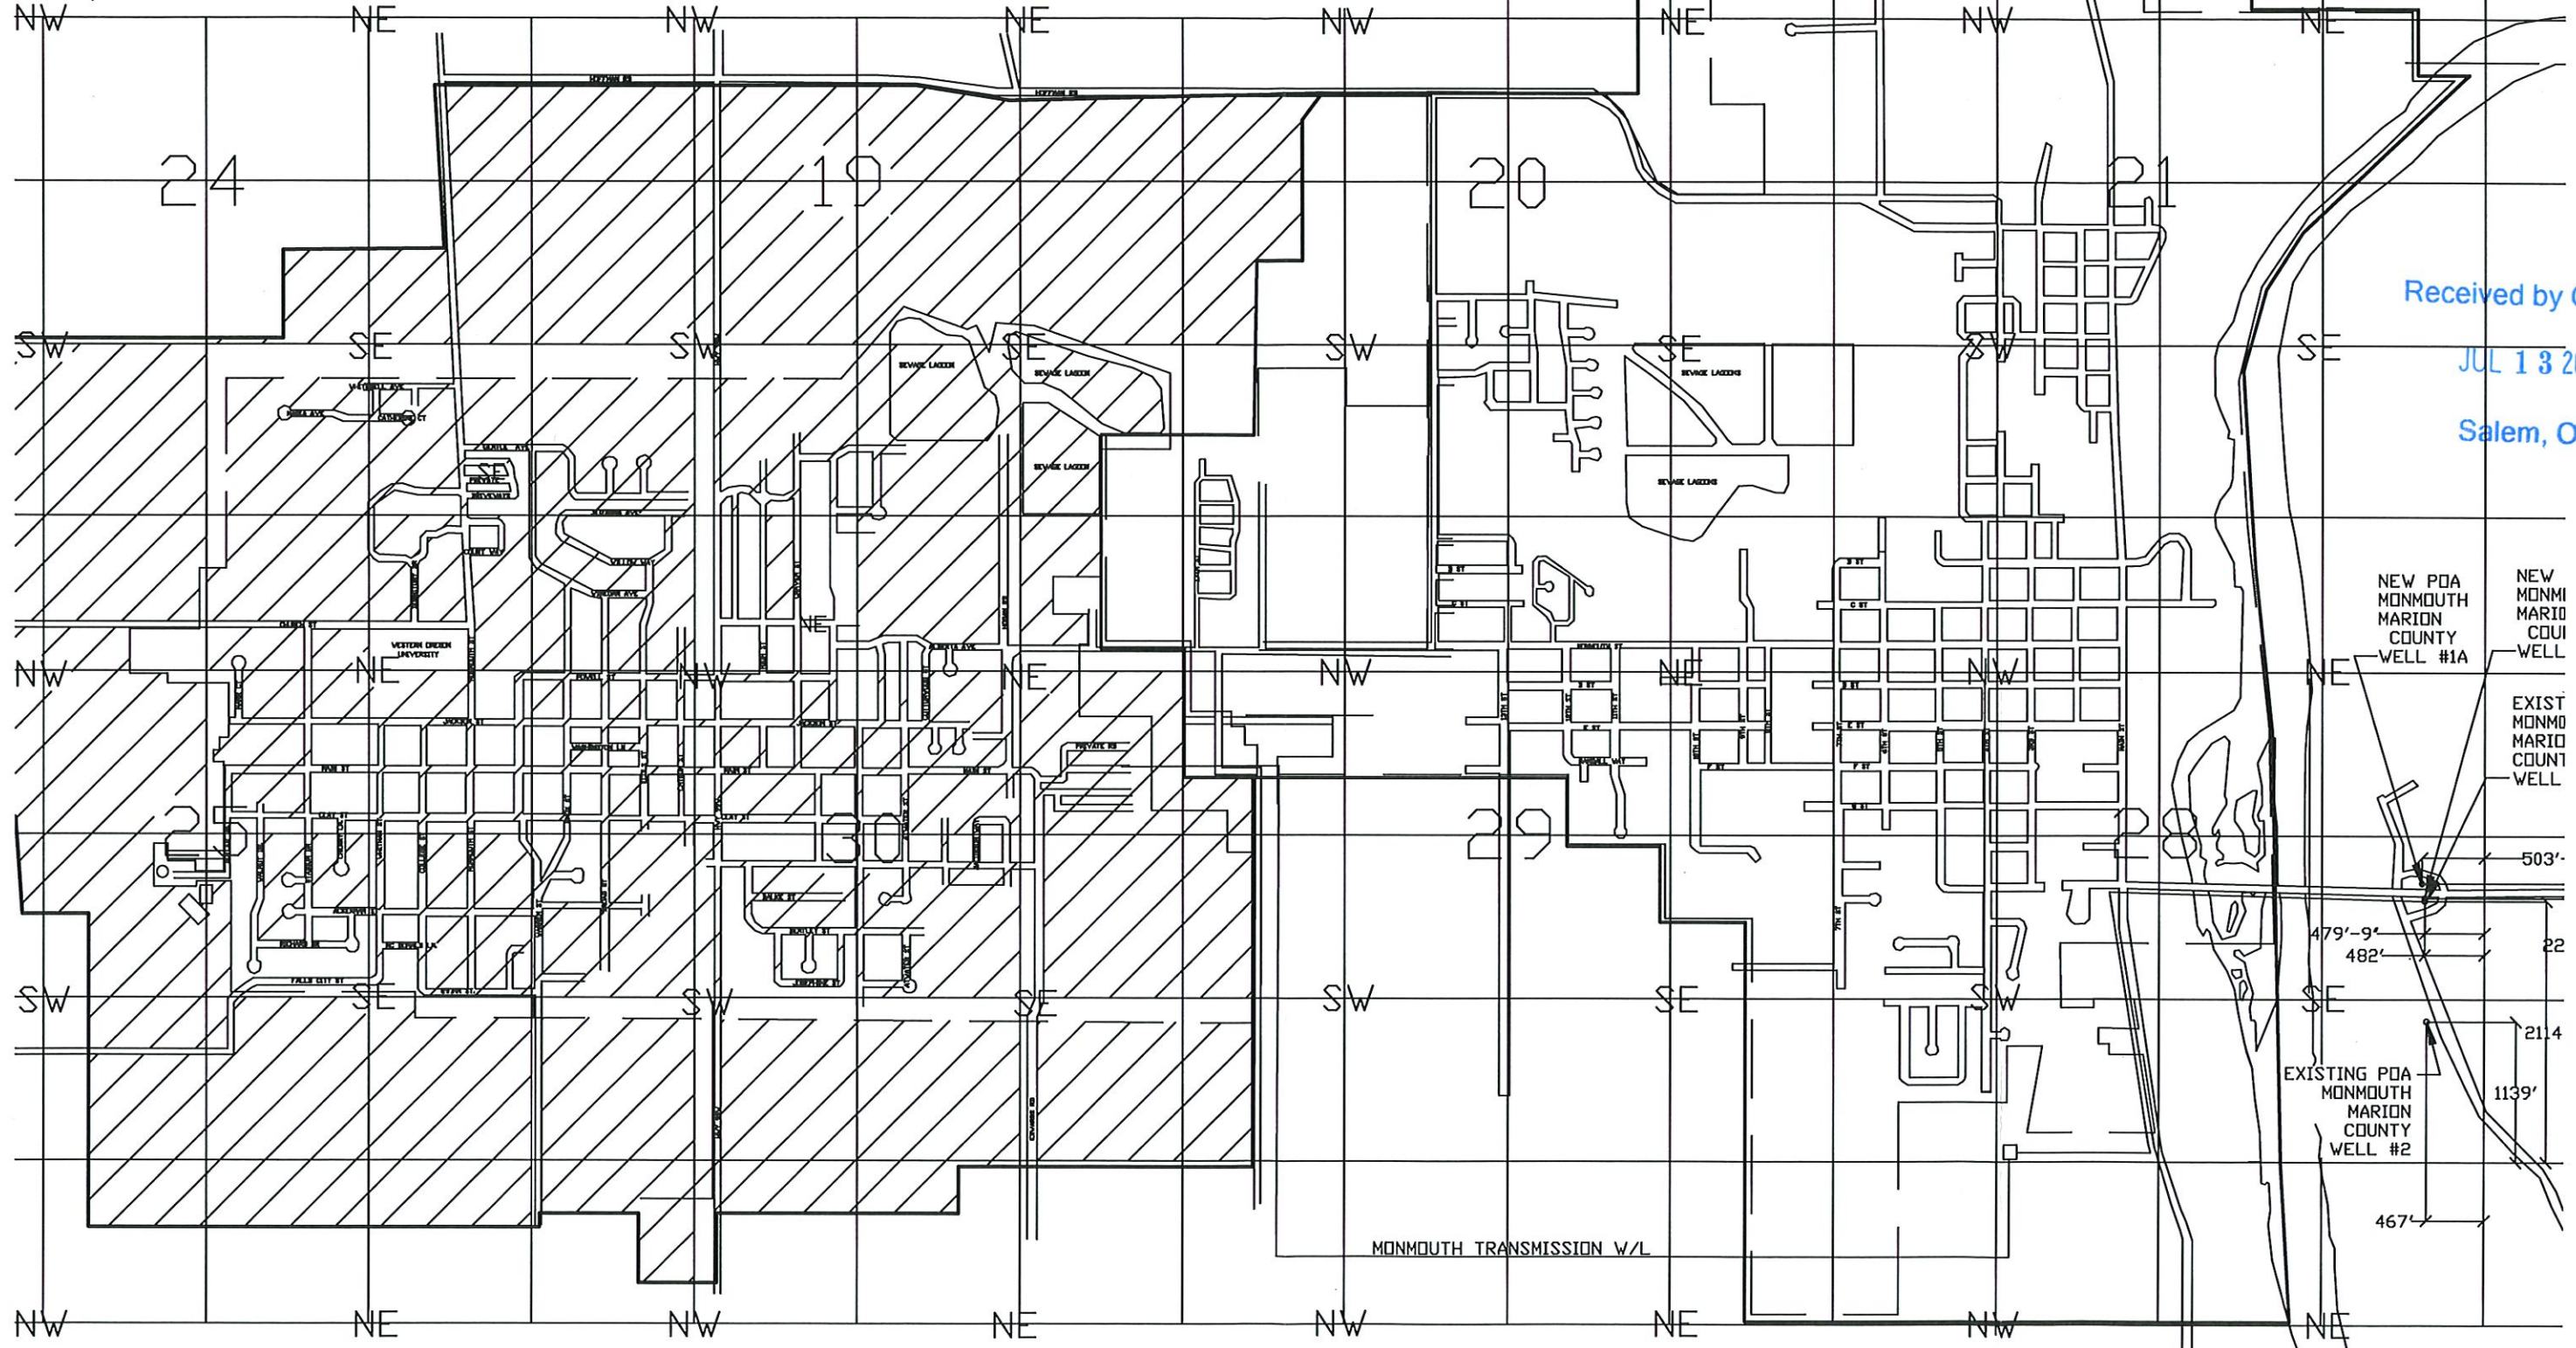

Received by OWRD

JUL 13 2023

Salem, OR

NEW POA  
MONMOUTH  
MARION  
COUNTY  
WELL #1A

NEW MONMOUTH  
MARION  
COUNTY  
WELL #1B

EXISTING  
MONMOUTH  
MARION  
COUNTY  
WELL #2

503'-4"  
 479'-9"  
 482'  
 2254'-3"  
 2114'  
 1139'  
 467'

NOTE: EXISTING POA FOR MARION COUNTY WELL #1 IS 482' WEST AND 2,114' NORTH OF THE SE CORNER OF T8S, R4W, SECTION 28.  
 EXISTING POA FOR MARION COUNTY WELL #2 IS 467' WEST AND 1,139' NORTH OF THE SE CORNER OF T8S, R4W, SECTION 28.  
 NEW POA FOR MARION COUNTY WELL #1A IS 503'-4" WEST AND 2254'-3" NORTH OF THE SE CORNER OF T8S, R4W, SECTION 28.  
 NEW POA FOR MARION COUNTY WELL #1B IS 479'-9" WEST AND 2138'-4" NORTH OF THE SE CORNER OF T8S, R4W, SECTION 28.